


PLAT OF SURVEY


LEGAL DESCRIPTION (AS RECORDED)

LOT 2, BLOCK 4, GRADVIEW SUBDIVISION IN THE TOWN OF WHITEWATER, WALWORTH COUNTY, WISCONSIN EXCEPTING THE FOLLOWING PARCELS OF LAND IN THE SELY CORNER OF SAID LOT DESCRIBED AS FOLLOWS: A PART OF LOT 2 OF BLOCK 4 OF GRANVIEW SUBDIVISION LOCATED IN SECTION 4, T4N, R15E, OF WALWORTH COUNTY, WISCONSIN, DESCRIBED AS FOLLOWS: BEGINNING AT A POINT ON THE SWLY LINE OF SAID LOT 2, 111.59 FEET S 49°47' E OF THE WLY CORNER OF SAID LOT; THENCE S 49°47' E 64.50 FEET TO THE HIGH WATER LINE OF WHITEWATER LAKE; THENCE NELY ALONG SAID LINE 25.00 FEET; THENCE N 72°00' W, 64.42 FEET TO THE PLACE OF BEGINNING; AND ALSO A PARCEL OF LAND LOCATED IN THE SE OF SECTION 34, T4N, R15E, WALWORTH COUNTY, WISCONSIN, DESCRIBED AS FOLLOWS, TO-WIT: BEGINNING ON THE HIGH WATER MARK AT THE MOST SLY CORNER OF LOT 2 OF BLOCK 4 OF GRANVIEW SUBDIVISION; THENCE NELY ALONG THE HIGH WATER LINE 25 FEET; THENCE S 49°47' E 96 FEET; THENCE SWLY 29 FEET TO THE SWLY LINE OF SAID LOT 2 EXTENDED; THENCE N 49°47' W ALONG SAID LINE EXTENDED 112 FEET TO THE PLACE OF BEGINNING.

OWNERS: MICHAEL A. LOGUNETZ
CHERYL J. LOGUNETZ
223 ADLER DRIVE
LIBERTYVILLE, IL 60048

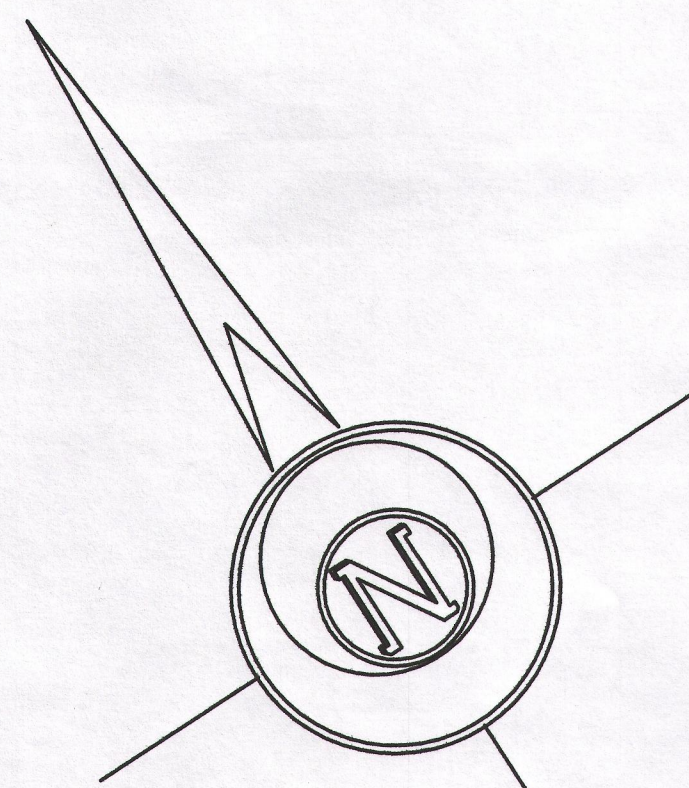

BASES OF BEARINGS:
THE WLY LINE OF LOT 2
BEING S 49°47'00\"/>

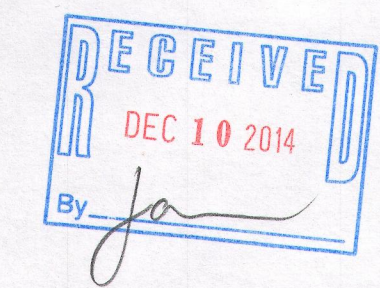

LEGEND

- FOUND IRON PIPE
- FOUND IRON ROD
- FOUND CONCRETE MONUMENT
- RECORDED AS DIMENSION
- EXISTING WOOD FENCE

SCALE: 1 INCH = 10 FEET

"I hereby certify that the above described property has been surveyed by me or under my direction and that the above map is a true representation thereof and shows the size and location of the property, its exterior boundaries, the location of all visible structures and dimensions of all principal buildings thereon, boundary fences, apparent easements, roadways and visible encroachments, if any."

"This survey is made for the use of the present owners of the property, and also those who purchase, mortgage, or guarantee the title thereto within one year from date hereof."

Mark L. Miritz
MARK L. MIRITZ
WISCONSIN PROFESSIONAL
LAND SURVEYOR S-2582
DATE: OCT. 2, 2014 JOB NO. 14.910