

LAND-MARK SURVEYING

Mark L. Miritz

Wisconsin Professional Land Surveyor S-2582

N9330 Knuteson Drive
Whitewater, WI 53190
Phone: (262) 495-3284
MarkMiritz@
Land-MarkSurveying.com

PLAT OF SURVEY

**LOT 34, BLOCK 2, INDIAN TRAIL SUBDIVISION,
LOCATED IN THE SOUTHEAST 1/4 OF SECTION 27,
TOWN 4 NORTH, RANGE 15 EAST, WHITEWATER
TOWNSHIP, WALWORTH COUNTY, WISCONSIN.**

**OWNER: LINDA W. WAGNER TRUST
9425 S. WALKER ROAD
BELOIT, WI 53511**

**SITE ADDRESS: N7718 KETTLE MORaine DRIVE
WHITEWATER, WI 53190**

ZONED: R-1



LEGEND



- PINE TREE DIAMETER IN INCHES
- TREE DIAMETER IN INCHES
- FOUND IRON PIPE
- SET IRON ROD, 18" LONG, WEIGHING 1.5 LBS./LINEAL FT., 3/4" DIA.
- RECORDED AS DIMENSION
- EXISTING WOOD FENCE

SCALE: 1 INCH = 20 FEET

"I hereby certify that the above described property has been surveyed by me or under my direction and that the above map is a true representation thereof and shows the size and location of the property, its exterior boundaries, the location of all visible structures and dimensions of all principal buildings thereon, boundary fences, apparent easements, roadways and visible encroachments, if any." "This survey is made for the use of the present owners of the property, and also those who purchase, mortgage, or guarantee the title thereto within one year from date hereof."

**MARK L. MIRITZ
WISCONSIN PROFESSIONAL
LAND SURVEYOR S-2582**

DATE: MAY 27, 2015 JOB NO. 15.505

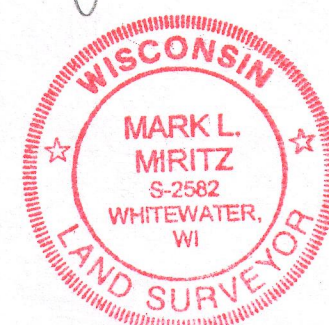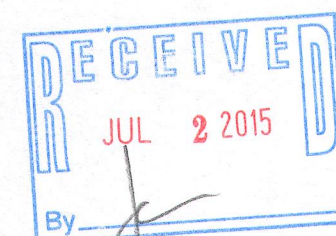

DIT8-58

415-1355