

# Plat of Survey


of

## Lot 10 of Block 1 of Moraine Heights,

a subdivision located in the Southeast 1/4 of Section 26,  
Town 4 North, Range 15 East, Town of Whitewater,  
Walworth County, Wisconsin.

Surveyed for: **Todd & Kristine Zinkgraf**

N7698 Woodchuck Alley  
Whitewater, Wisconsin. 53190

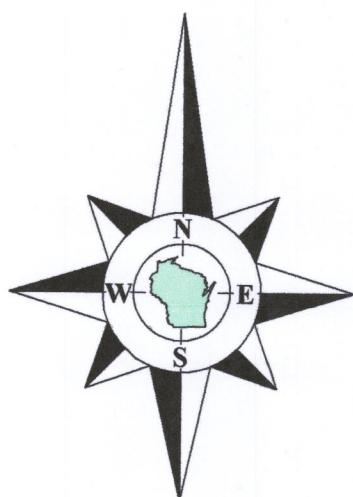

Bearings reference to the  
plat of Moraine Heights.

"Park"

**Woodchuck Alley**  
(East Ridge Road)  
(30' Wide - One Way)

Unimproved  
**"Public Road"**  
(50' Wide)

House  
N7714

Deck

**Whitewater  
Lake**

Lot 9  
Moraine Heights

Tax Parcel  
DMH 00009

House  
N7698

**Lot 10**  
Tax Parcel  
DMH 00010

0.249 Acre  
10,867 Sq.Ft.

**Garage**  
Under Construction  
Location of Cement  
Block Lower Level


Lot 11  
Moraine Heights

Tax Parcel  
DMH 00011

Lot 12  
Moraine Heights

House  
N7694  
Porch  
Under Deck

**Whitewater  
Lake**

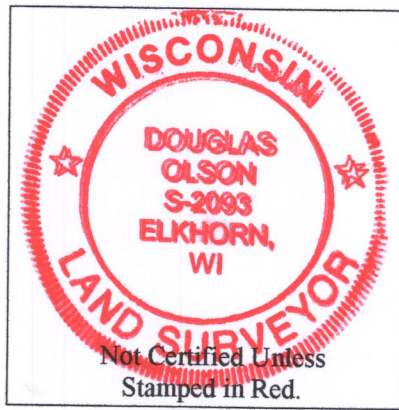

### Notes:


- 1) This survey plat is not certified unless signed and sealed in red ink.
- 2) This survey is subject to Wisconsin lien laws. This Plat of Survey is the notice of intent to file lien. Lien waiver required.

Copyright 2016 by Olson Land Surveying, LLC.

All rights reserved. No part of this survey plat may be reproduced or transmitted in any form by any means - graphic, electronic, or mechanical, including photocopying, tracing, or information storage and retrieval systems - without permission in writing from Douglas G. Olson, Olson Land Surveying, LLC.

I, Douglas G. Olson, Wisconsin Professional Land Surveyor, do hereby certify that this survey was performed by me, or under my direction in full compliance with the owner's/agent's instructions and Chapter A-E 7 of the Wisconsin Administrative Code "Minimum Standards for Property Surveys"; and that this map is an accurate representation thereof to the best of my knowledge and belief.

Douglas G. Olson  
Wisconsin Professional Land Surveyor - 2093

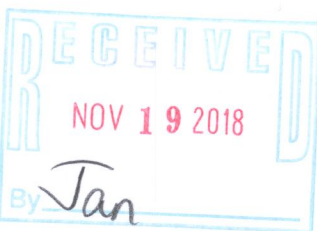

Sheet 1 of 1 Sheets

Drawing Name:

Job Reference Number  
**2016.095**

### Legend of Symbols & Abbreviations


- Found Iron Pipe
- Found Iron Rod
- Recorded Information
- Utility Pedestal
- Concrete Cover
- Septic Vent
- Lamp
- Asphalt Surface
- Gravel Surface

N North  
S South  
E East  
W West  
In Bearings  
° Degrees  
' Minutes  
" Seconds  
In Distances  
Feet  
" Inches



45 South Wisconsin Street | P.O. Box 322  
Elkhorn, Wisconsin. 53121  
Telephone: (262) 723-3434  
Facsimile: (262) 723-8044  
Email: doug@olsonsurveying.com  
Website: www.olsonsurveying.com

Scale in Feet  
1" = 20'

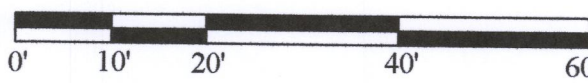

Survey Date: July 19, 2006.

Revisions: No. 1 - Adjacent houses and shoreyard setbacks, Proposed Garage & Deck.  
No. 2 - Proposed Garage location.  
No. 3 - Garage Under Construction

2016.095

DMH-10 4/5-1472