

LOT 1, CERTIFIED SURVEY MAP NO. 3585, LOCATED IN PART OF THE
SOUTHWEST 1/4 OF THE NORTHEAST 1/4 OF SECTION 29, TOWN 4
NORTH, RANGE 15 EAST, WHITEWATER TOWNSHIP, WALWORTH
COUNTY, WISCONSIN.

NORTH 1/4
SEC. 29-4-15

OWNERS:
ERIK SLUSSER
LORI VERDEGAN
N7934 HIGHWAY 89
WHITEWATER, WI 53190

STATE TRUNK HIGHWAY "89"

N 00°35'18" E 2630.31'

428.86'


100' WIDE

N 00°40'13" E 428.88'

NO ACCESS

NO ACCESS

GRAVEL DRIVE
ONLY ACCESS PER
C.S.M. NO. 3585

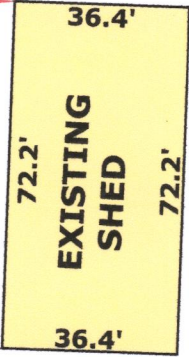

LOT 1
(8.08 ACRES)

LEGEND

- FOUND IRON ROD
- FOUND COUNTY MONUMENT
- (xx) RECORDED AS DIMENSION

SCALE: 1 INCH = 40 FEET

"I hereby certify that the above described property
has been surveyed by me or under my direction and
that the above map is correct to the best of my
knowledge and belief."

Mark L. Miritz
MARK L. MIRITZ
WISCONSIN PROFESSIONAL
LAND SURVEYOR S-2582

CENTER SEC.
29-4-15

REVISED AUGUST 5, 2022
TO SHED "AS BUILT"

DATE: MAY 28, 2022 JOB NO. 22.503