


FILE NAME: 2023-047 ELEGANT BUILDERS N7715 RIDGE ROAD WHITEWATER.DGN

PLAT OF SURVEY



LOT 10, BLOCK 2 OF MORaine HEIGHTS SUBDIVISION, LOCATED IN THE SOUTHWEST ¼ OF THE SOUTHEAST ¼ OF SECTION 26 AND THE SOUTHEAST ¼ OF THE SOUTHWEST ¼ OF SECTION 26 AND THE NORTHWEST ¼ OF SECTION 35 AND THE NORTHEAST ¼ OF SECTION 35 AND THE SOUTHWEST ¼ OF SECTION 35, TOWNSHIP 4 NORTH, RANGE 15 EAST, TOWN OF WHITEWATER, WALWORTH COUNTY, WISCONSIN.

WHITEWATER LAKE

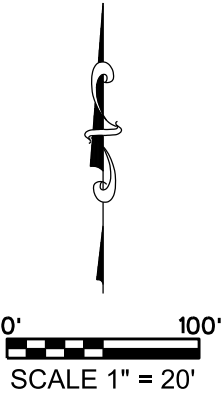

LEGEND:

- (100.00') RECORDED DISTANCE
- 100.00' MEASURED DISTANCE
- 1" FOUND IRON PIPE, UNLESS NOTED
- ⊗ ¾" x 18" IRON PIPE SET, 1.13 lbs./L.F.
- ⚡ WELL
- Ⓢ SEPTIC TANK
- Ⓜ MANHOLE
- ⊗ LIGHT POLE
- Ⓛ ELECTRIC TRANSFORMER
- Ⓢ ELECTRIC PEDESTAL
- Ⓢ TELEPHONE PEDESTAL
- Ⓢ CABLE TV PEDESTAL

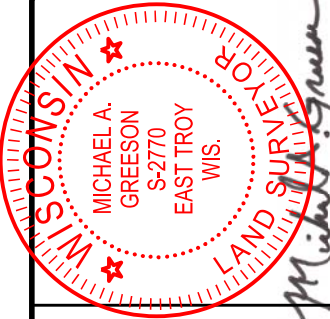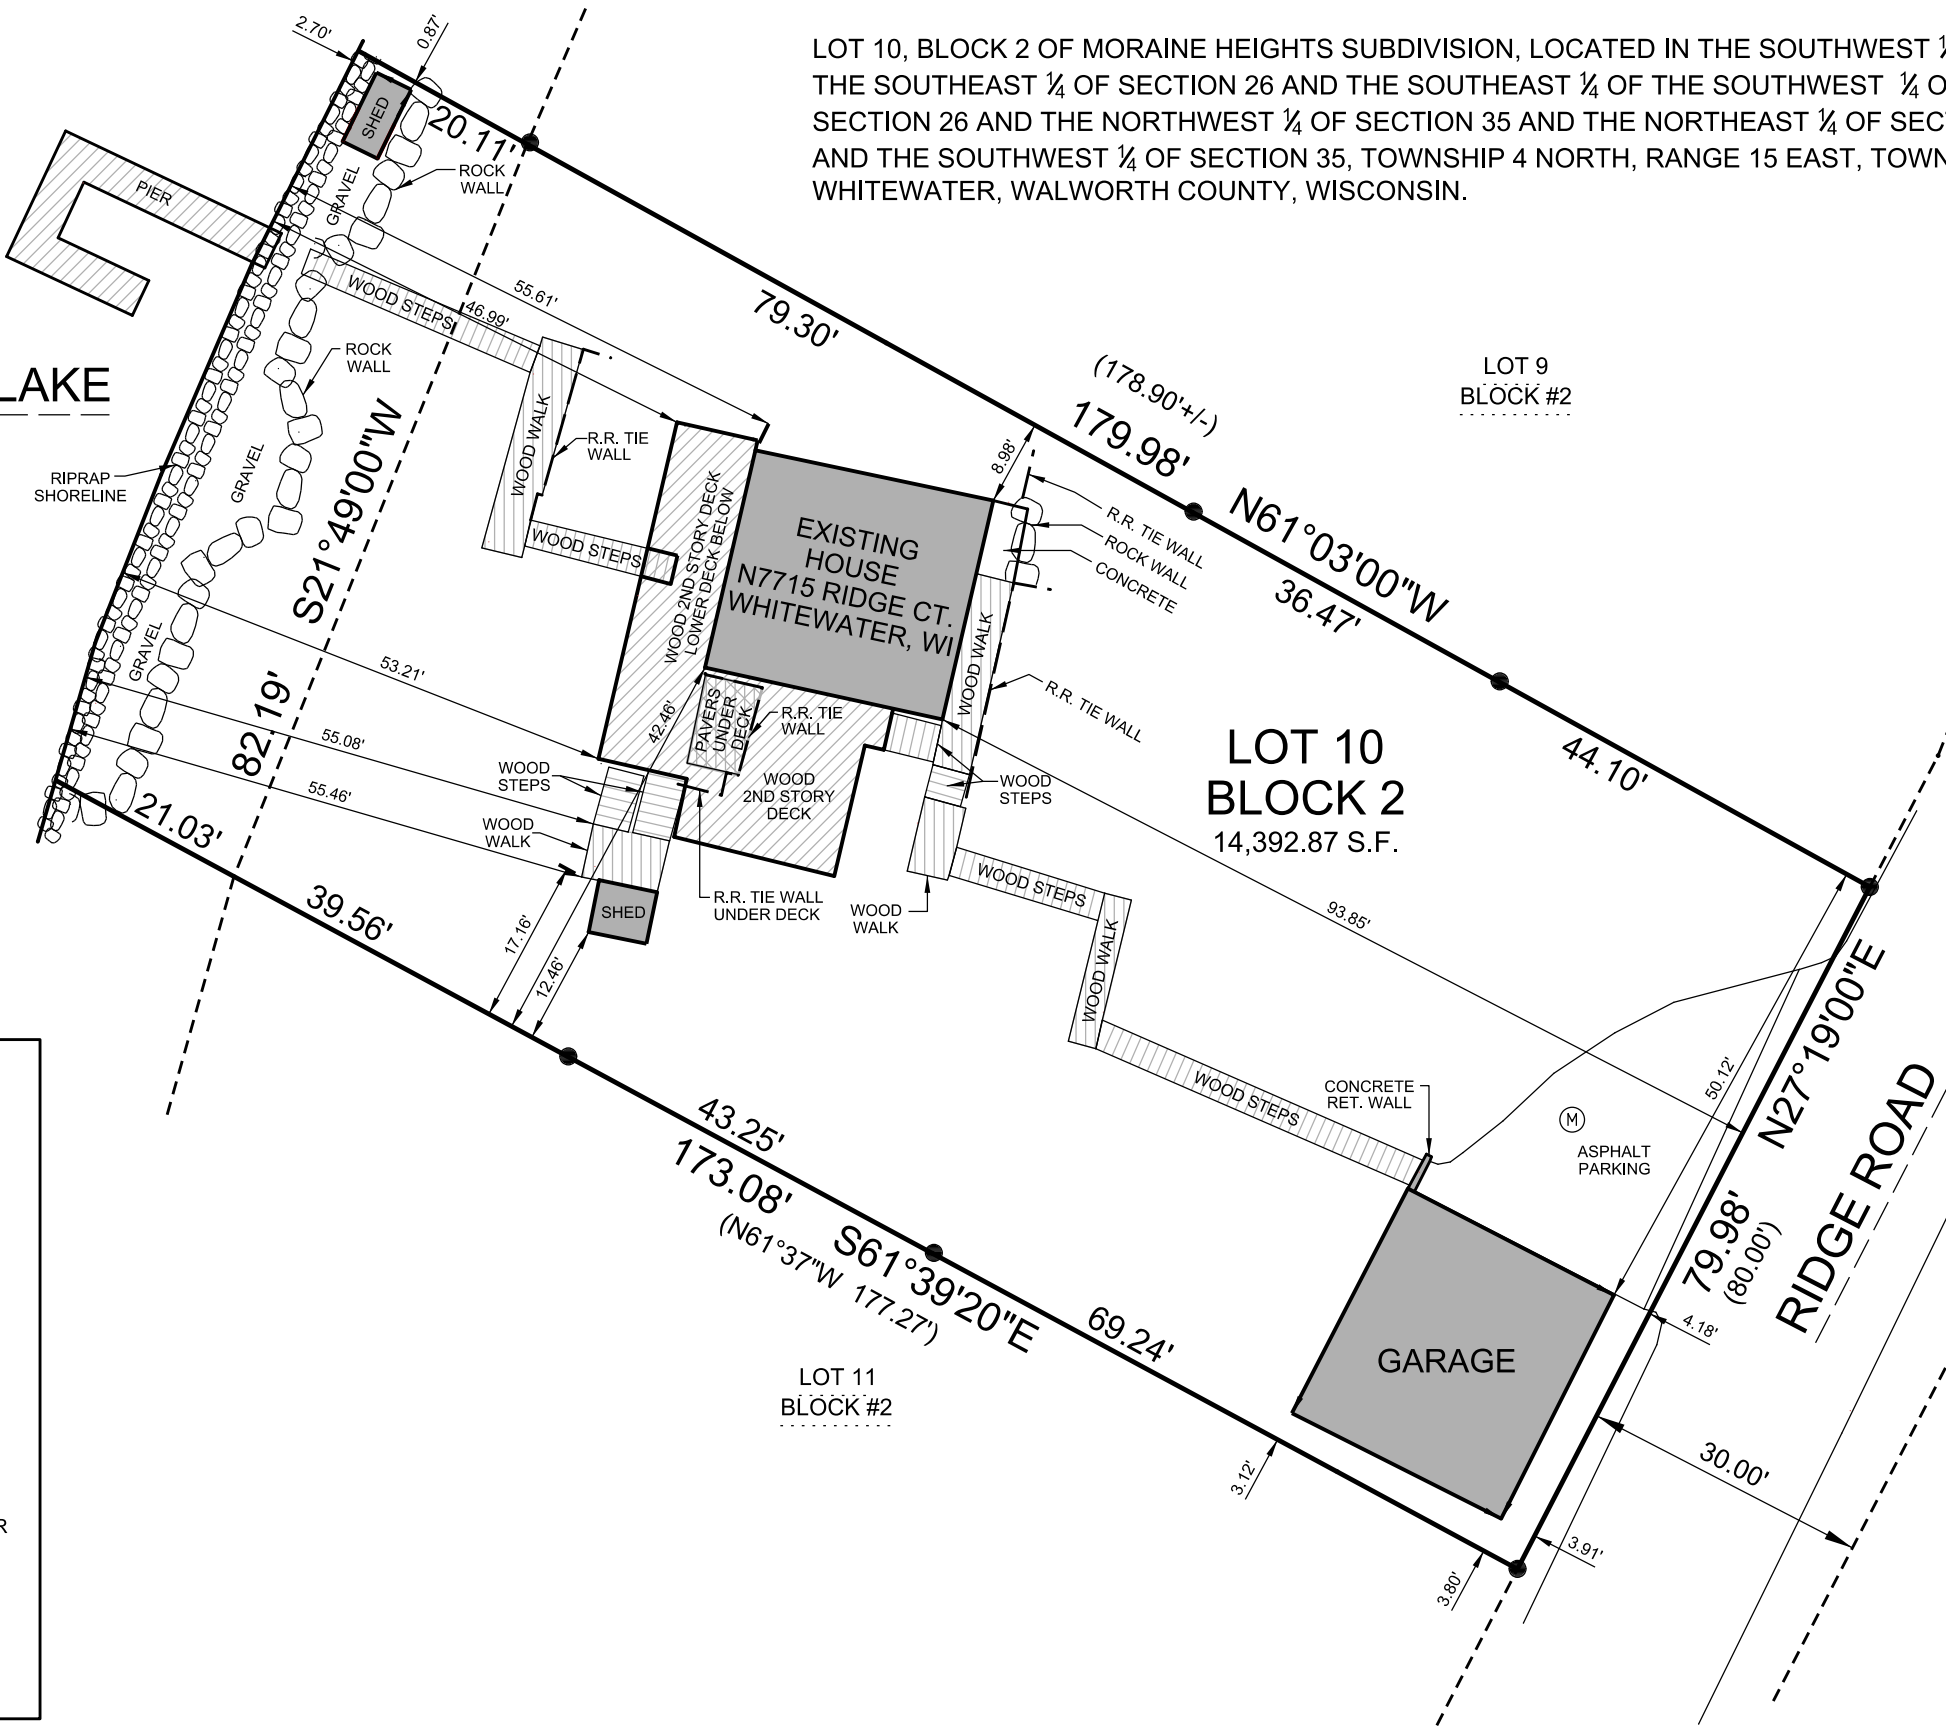

THIS SURVEY IS MADE FOR THE USE OF THE PRESENT OWNERS OF THE PROPERTY, AND ALSO THOSE WHO PURCHASE, MORTGAGE OR GUARANTEE TITLE TO WITHIN ONE (1) YEAR FROM DATE HERETO.

I, MICHAEL A. GREESON P.L.S. #2770, HEREBY CERTIFY THAT THIS SURVEY WAS MADE IN ACCORDANCE WITH THE MINIMUM STANDARDS FOR PROPERTY SURVEYS (CHAPTER A-E 7) FOR THE STATE OF WISCONSIN AND HAS BEEN PREPARED UNDER MY DIRECTION AND CONTROL AND IS CORRECT TO THE BEST OF MY KNOWLEDGE AND BELIEF.

SURVEY MADE FOR:
Elegant Builders
S70W39675 County Rd N
Eagle, WI 53119

DATE	ITEM
05/31/2023	PLAT OF SURVEY

V²G
SURVEYING, LLC

123 WOLF RUN - SUITE 4
MUKWONAGO, WI 53149
(262) 378-5097