


HAROLD H. KOLB

REGISTERED PROFESSIONAL LAND SURVEYOR
LAKE GENEVA, WISCONSIN


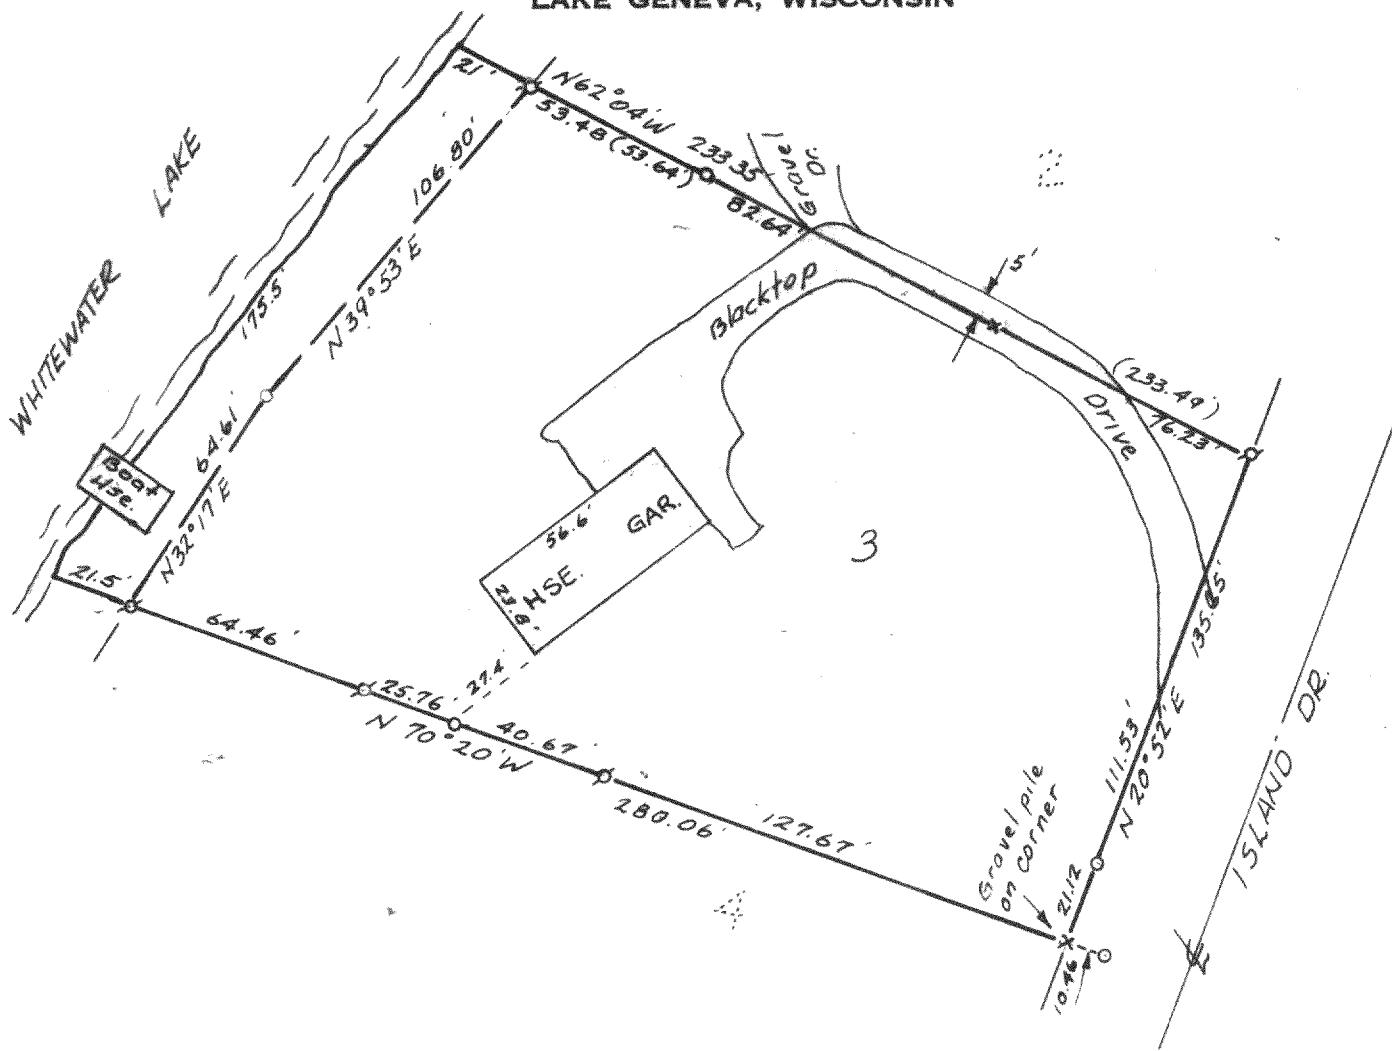


PLAT OF SURVEY OF

Lot 3, Thorne Heights, located in Sec.
37, T4N, R15E, Whitefish County, Wisconsin

Ordered by: Roland Aronson
117 S. 1st St.
Whitefish, WI

Notes: Bearings are as noted as listed.

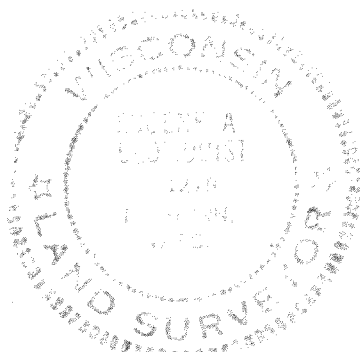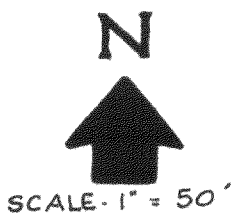

LEGEND

- O — IRON PIPE PLACED. 1" x 24" 1.13 LB./LIN. FT.
- — CONCRETE MONUMENT. 5" DIA. x 30"
- () — PLATTED AS ρ — IRON PIPE FOUND

I, Eugene A. Blomquist, do hereby certify
that I have surveyed the property herein
described according to the official records
and that the plat herein is a correct
representation of the lot lines.

EUGENE A. BLUMQUIST

WISCONSIN REGISTERED LAND SURVEYOR, S. 270

DATE Sept. 26, 1978