


PLAT OF SURVEY

OF Lot 27 Block 2 of Indian Trail Subdivision, located in the NW 1/4 of the SW 1/4 of Section 26, and the NE 1/4 of the SE 1/4 of Section 27, and the SE 1/4 of the SE 1/4 of Section 27, T4N, R15E, Walworth County, Wisconsin.

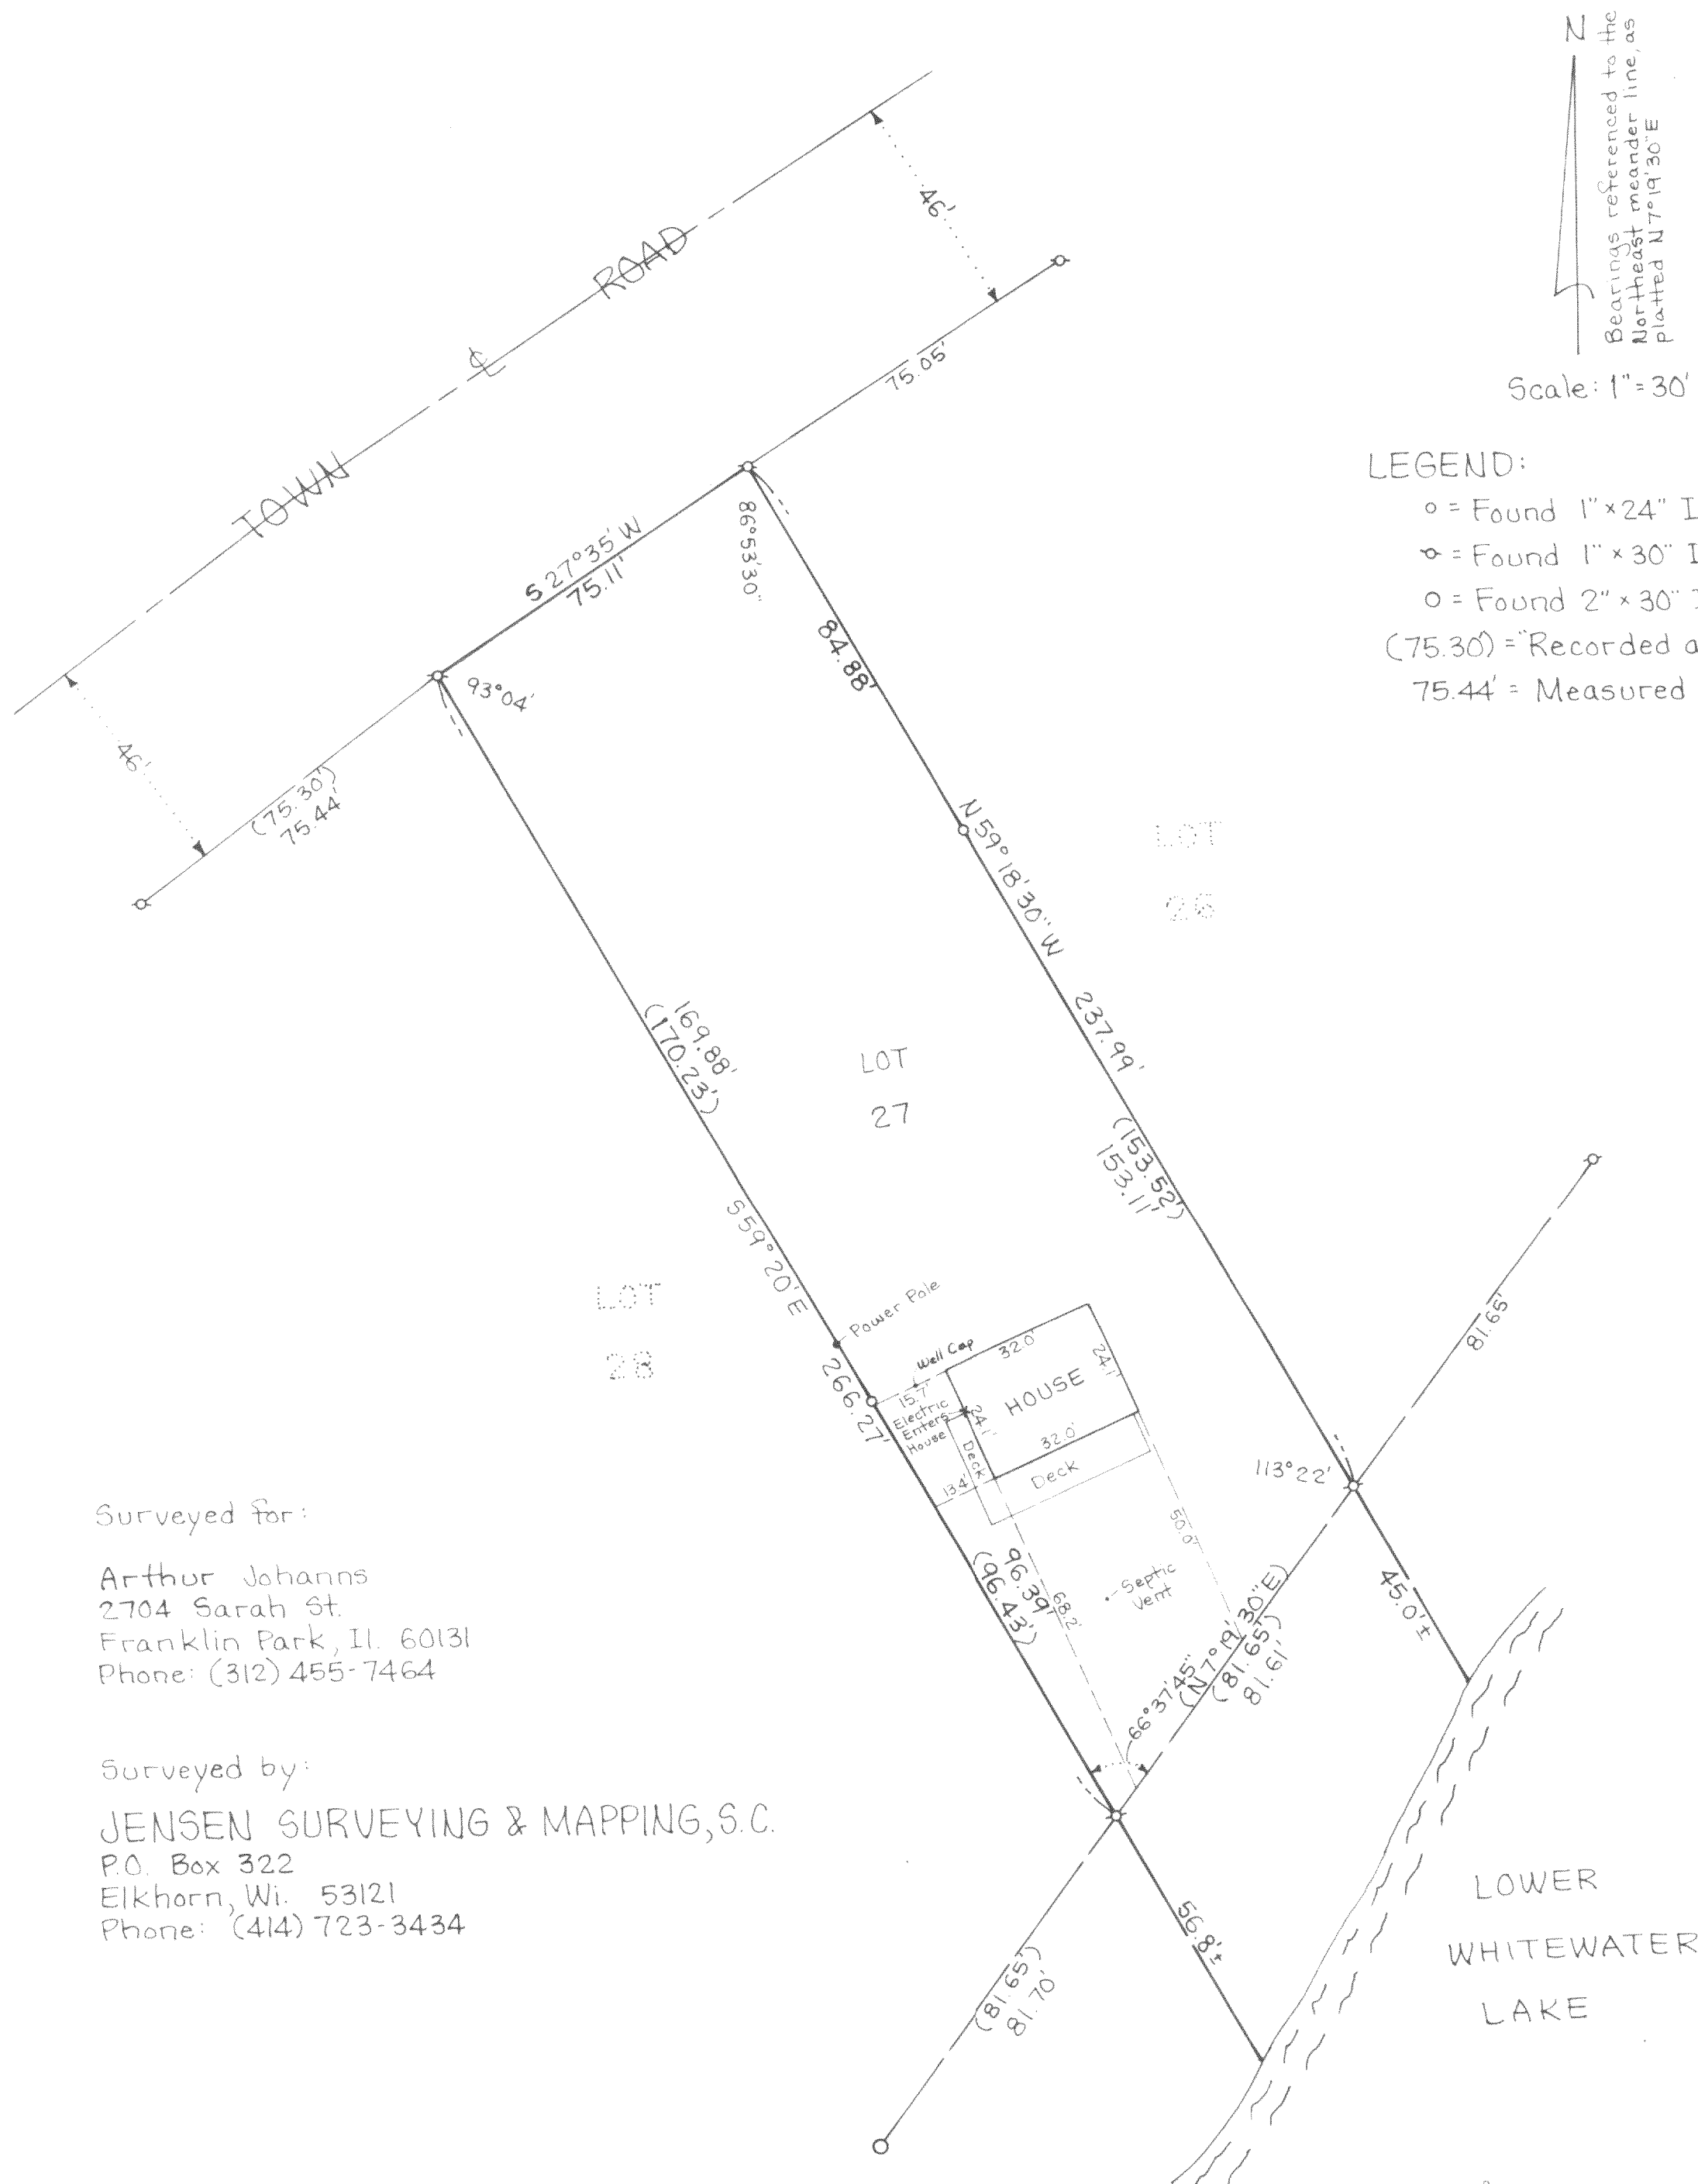

I hereby certify that the above described property has been surveyed under my direction, that the plat shown hereon is an accurate survey, a true representation thereof, correctly shows the exterior boundary lines on said property and the correct measurements thereof and buildings thereon.



Thomas A. Jensen
 THOMAS A. JENSEN R.L.S. NO. 1084

