

DETAIL OF TREE LINE


LOCATED ALONG THE NORTHEASTLY LINE OF LOT 14 OF BLOCK 1
OF MINNIESKA SUBDIVISION, LOCATED IN THE N.E. 1/4 OF SECTION 35,
T4N, R15E, WALWORTH COUNTY, WISCONSIN

WATER LAKE




SCALE 1" = 10'

0 FOUND IRON PIPE
Lot Line
DISTANCE FROM LOT LINE
AT RIGHT ANGLES

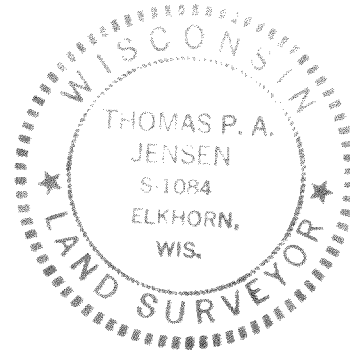

Thomas P. A. Jensen
Dec 10 1985

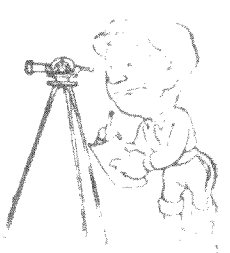

SHED
OLD IRON FENCE POST

ROAD TO LAKE

LOT 14

OLD IRON FENCE POST

OLD IRON FENCE POST

EAST SHORE DRIVE
66' WIDE