


Plat of Survey of Lot 34 Block 2 of Indian Trails Subdivision  
Located in the Town of Whitewater, Walworth County Wisconsin

**D.D. COOPER & CO. INC.**

Route 4 Box 508B  
Elkhorn WI 53121  
Phone-414-723-6265

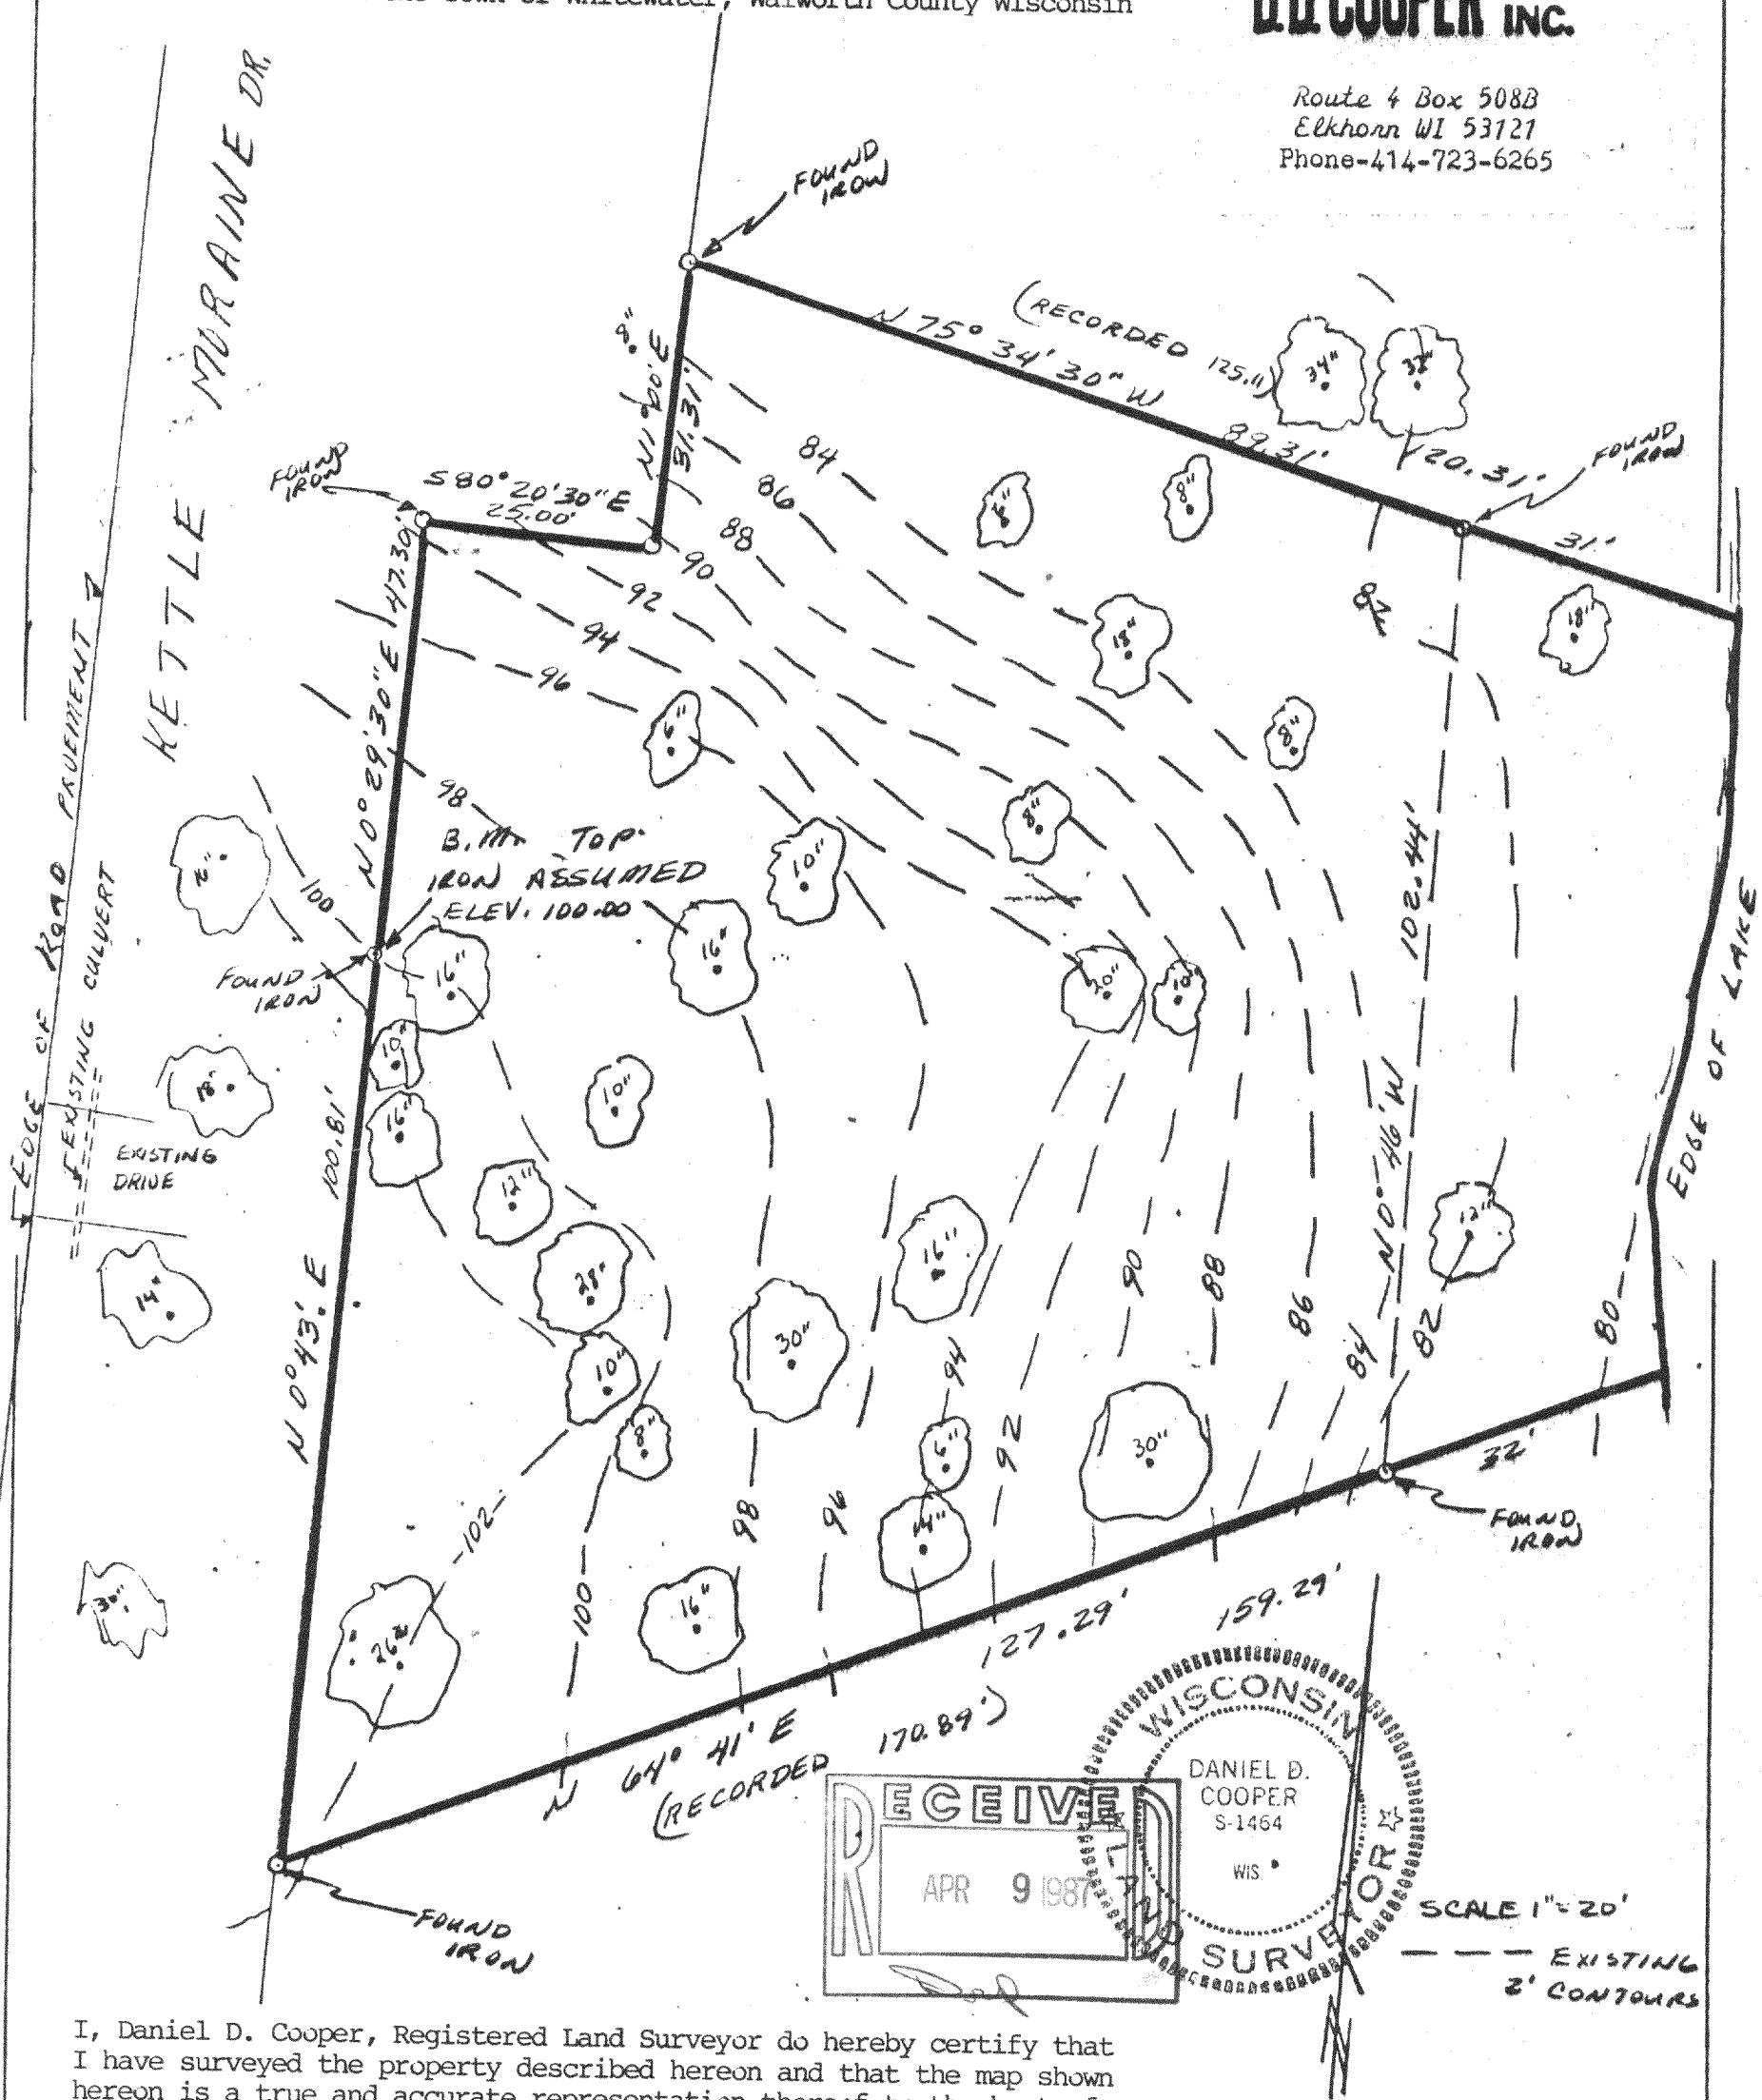

I, Daniel D. Cooper, Registered Land Surveyor do hereby certify that I have surveyed the property described hereon and that the map shown hereon is a true and accurate representation thereof to the best of my professional knowledge and belief.

Dated this 14<sup>TH</sup> day of Jan 1987

*Daniel D. Cooper*  
Daniel D. Cooper, RLS NO. S-1464

Survey ordered by Century 21  
Whitewater WI

DITS-58

Bearing Reference: Easterly line of Kettle Moraine Dr.  
assumed to bear N0 43'E

DRAWING D. 3043

415-266