
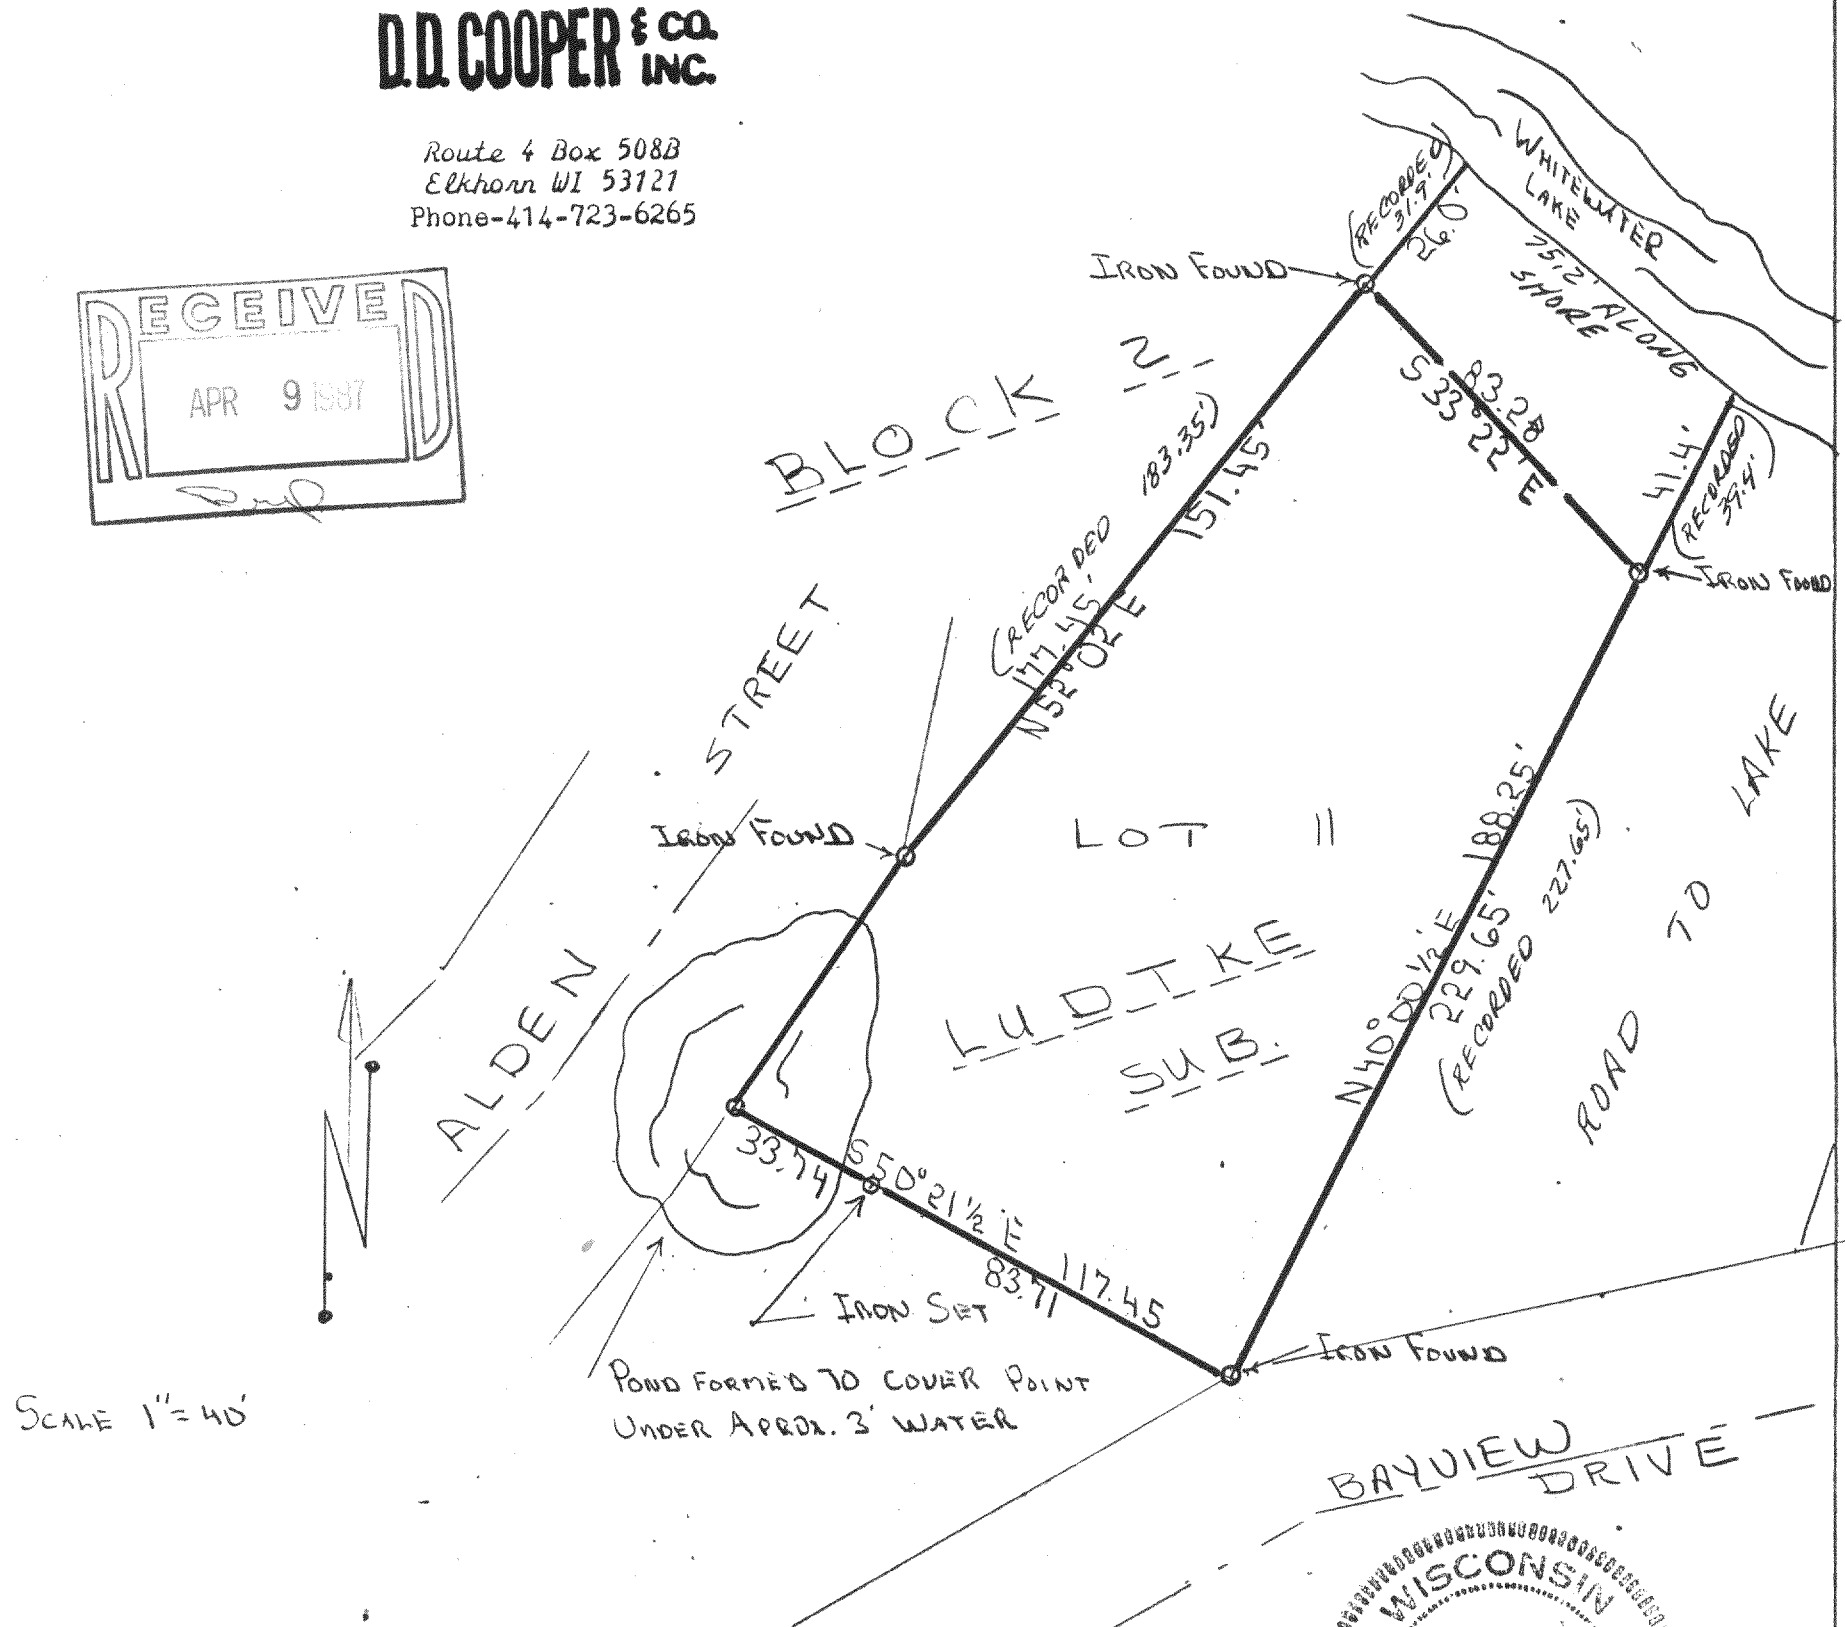


D.D. COOPER & CO. INC.

Route 4 Box 508B
Elkhorn WI 53121
Phone-414-723-6265

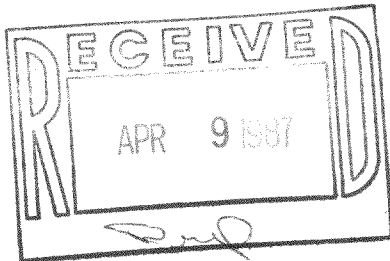

Plat of Survey of Lot 11, Block 2 of Ludtke Subdivision being located in T4N, R15E Walworth County Wisconsin

Survey ordered by Atty Andy Hack
321 East Millwaukee Ave.
Janesville WI 53545

Bearing Reference: Southeasterly line of parcel assumed to
Bear N40 00'30\"E as platted

I, Daniel D. Cooper, Registered Land Surveyor do hereby certify that I have surveyed the property described hereon and that the map shown hereon is a true and accurate representation thereof to the best of my professional knowledge and belief.

Dated this 24TH day of NOV., 1986

Daniel D. Cooper, RLS NO. S-1464

