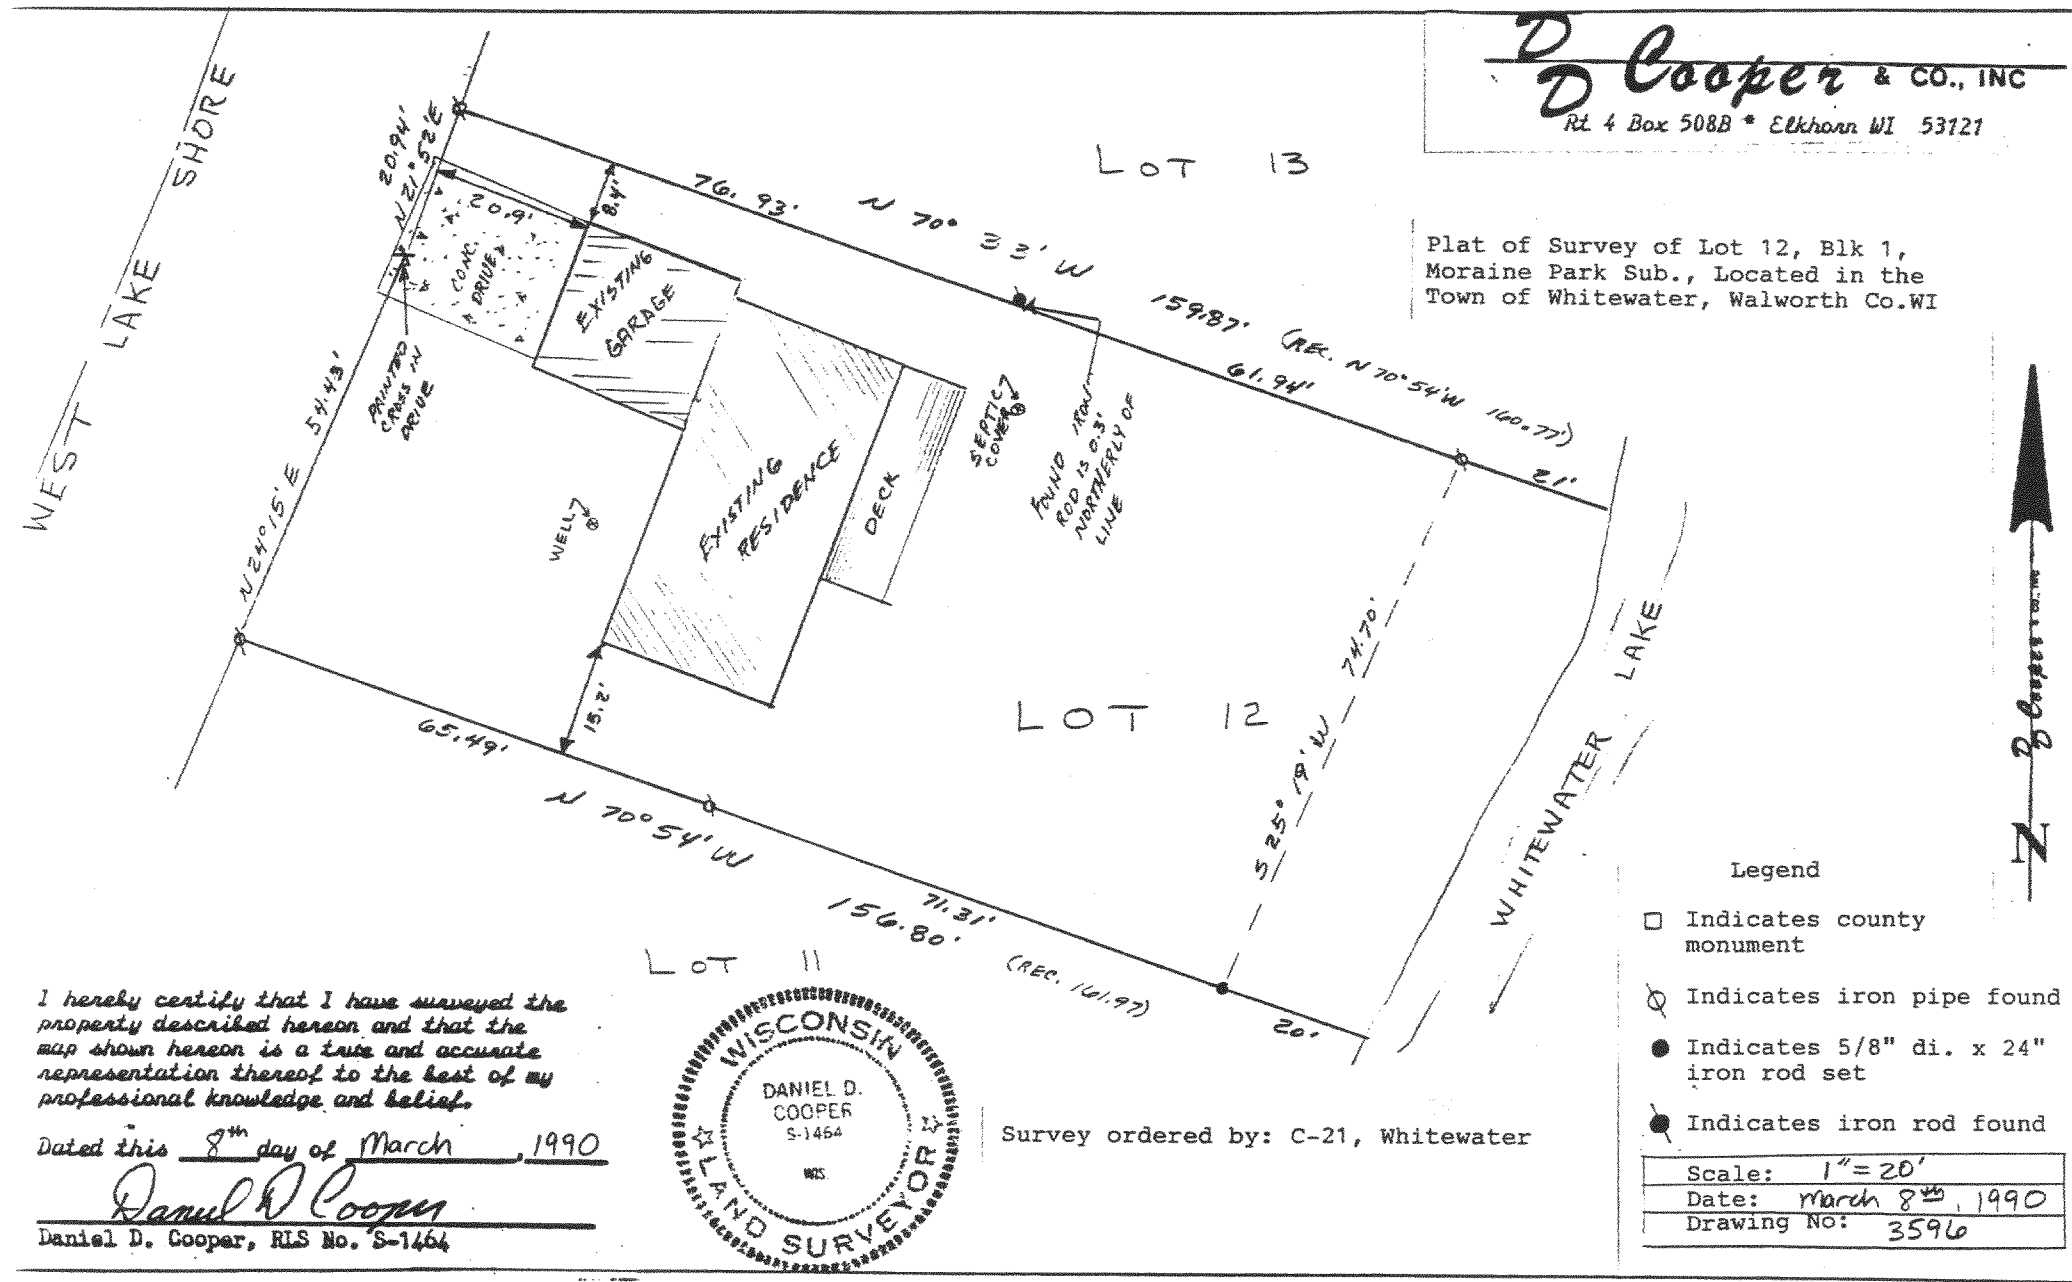


Revised

TAX KEY # DMP 00012

415-312