

ABELL
SURVEYING & MAPPING

DELAVER, WISCONSIN 53115

414-728-6737

PLAT OF SURVEY OF

LOT 4, BLOCK 3, MORaine PARK
SUBDIVISION, T4N, R15E, WALWORTH
COUNTY, WISCONSIN.

ORDERED BY: CENTURY 21 -
WALTON REALTY
202 E. MAIN ST.
WHITEWATER, WI
53190


KETTLE MORaine DRIVE

LOT 4

0.44 ACRES

LOT 5

NOTE: BEARINGS ARE
REFERENCED TO THE
SUBDIVISION PLAT.

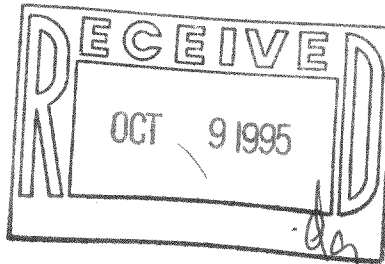

I HEREBY CERTIFY THAT I HAVE SURVEYED THE ABOVE DESCRIBED PROPERTY AND THAT THE ABOVE MAP IS A TRUE REPRESENTATION THEREOF AND SHOWS THE SIZE AND LOCATION OF THE PROPERTY, ITS EXTERIOR BOUNDARIES, THE LOCATION OF ALL VISIBLE STRUCTURES AND DIMENSIONS OF ALL PRINCIPAL BUILDINGS THEREON, BOUNDARY FENCES, APPARENT EASEMENTS, ROADWAYS AND VISIBLE ENCROACHMENTS, IF ANY, TO THE BEST OF MY KNOWLEDGE AND BELIEF.

THIS SURVEY IS MADE FOR THE USE OF THE PRESENT OWNERS OF THE PROPERTY, AND ALSO THOSE WHO PURCHASE, MORTGAGE, OR GUARANTEE THE TITLE THERETO WITHIN ONE (1) YEAR FROM DATE HEREON.

David F. Abell
DAVID F. ABELL
WISCONSIN REGISTERED LAND SURVEYOR, S-1596

DATE May 20, 1995 JOB NUMBER 95072
NOTE: THIS IS NOT A CERTIFIED COPY UNLESS SEALED.

SCALE - 1"=30'

LEGEND

- Ø - IRON PIPE FOUND
- - IRON PIPE FOUND
- - BENT, SET IRON PIPE
- - UTILITY PED
- () - RECORDED AS

DMP-37

415-SP2