


# GEORGE T. DUNHAM

SURVEYING & SUBDIVIDING  
DELAVER, WISCONSIN

LAKE SHORE DRIVE

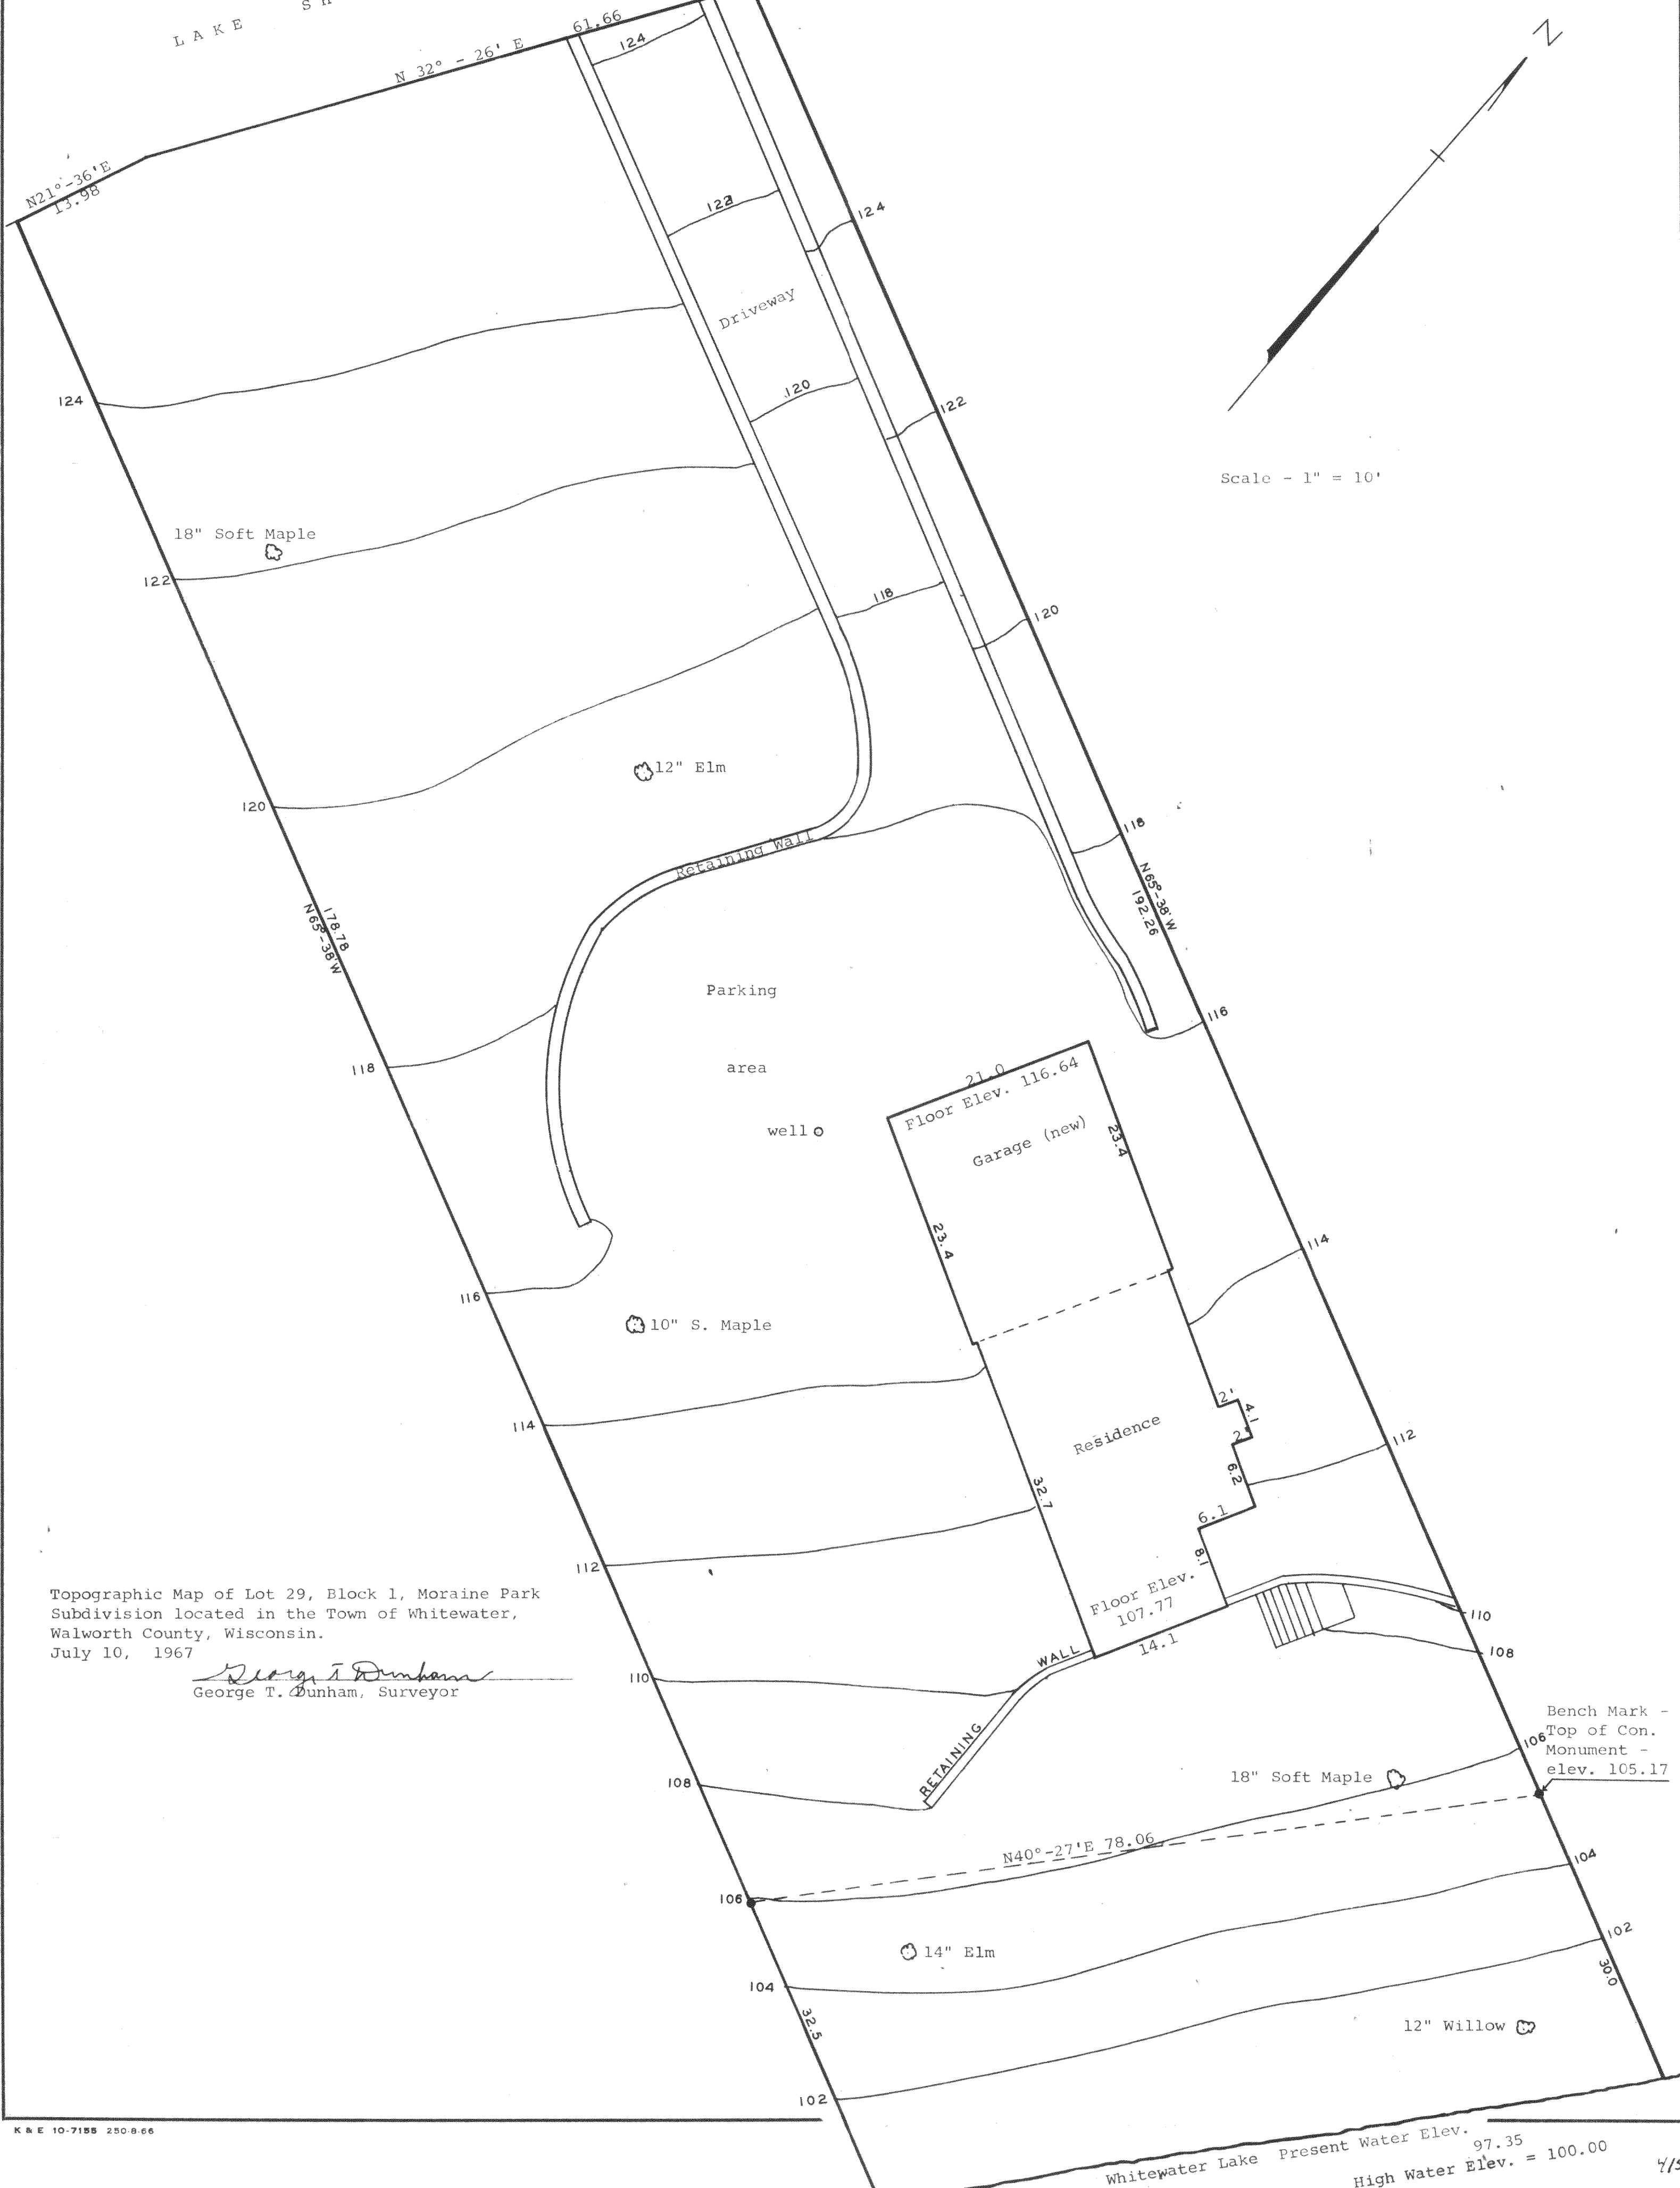

Topographic Map of Lot 29, Block 1, Moraine Park Subdivision located in the Town of Whitewater, Walworth County, Wisconsin.  
July 10, 1967

*George T. Dunham*  
George T. Dunham, Surveyor