


ABELL  
SURVEYING & MAPPING  
DELAVER, WISCONSIN 53115  
414-728-6737

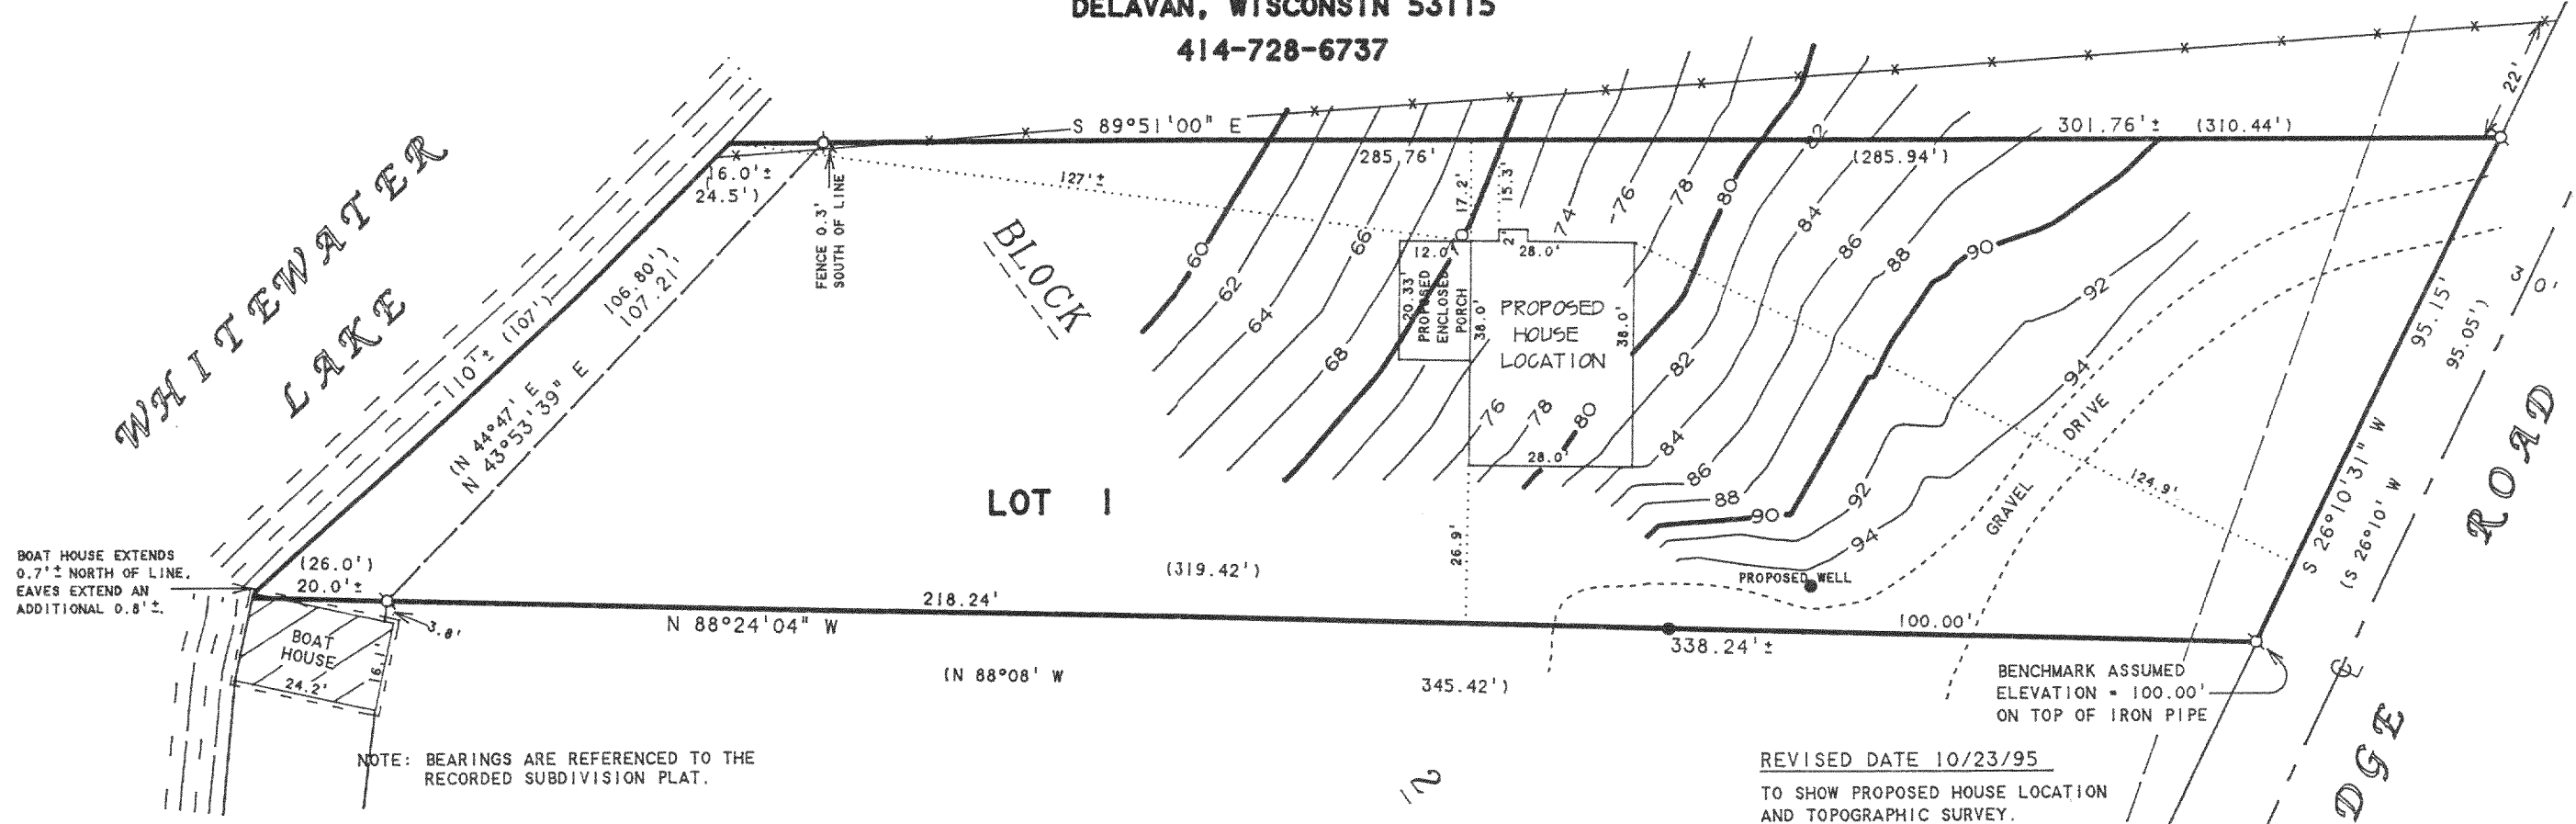

SCALE 1"=30'

LEGEND

- - IRON PIPE FOUND
- - OVERHEAD UTILITY LINES
- \* - WIRE FENCE
- ( ) - RECORDED AS
- - IRON ROD SET

PLAT OF SURVEY OF

LOT 1 BLOCK 2, MORaine HEIGHTS, LOCATED  
IN T4N, R1E, WALWORTH COUNTY, WISCONSIN.

I HEREBY CERTIFY THAT I HAVE SURVEYED THE ABOVE DESCRIBED PROPERTY AND THAT THE ABOVE MAP IS A TRUE REPRESENTATION THEREOF AND SHOWS THE SIZE AND LOCATION OF THE PROPERTY, ITS EXTERIOR BOUNDARIES, THE LOCATION OF ALL VISIBLE STRUCTURES AND DIMENSIONS OF ALL PRINCIPAL BUILDINGS THEREON, BOUNDARY FENCES, APPARENT EASEMENTS, ROADWAYS AND VISIBLE ENCROACHMENTS, IF ANY, TO THE BEST OF MY KNOWLEDGE AND BELIEF.


THIS SURVEY IS MADE FOR THE USE OF THE PRESENT OWNERS OF THE PROPERTY, AND ALSO THOSE WHO PURCHASE, MORTGAGE, OR GUARANTEE THE TITLE THERETO WITHIN ONE (1) YEAR FROM DATE HEREON.

*David F. Abell*

DAVID F. ABELL  
WISCONSIN REGISTERED LAND SURVEYOR, S-1596


August 2, 1995

DATE: August 2, 1995 JOB NUMBER - 93251  
NOTE: THIS IS NOT A CERTIFIED COPY UNLESS SEALED.

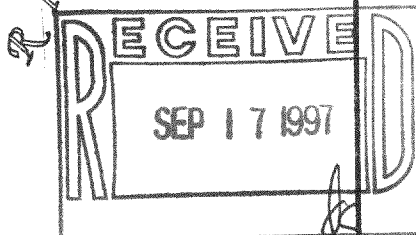

DMH-36  
HIS-605

ABELL  
SURVEYING & MAPPING  
DELAVAN, WISCONSIN 53115  
414-728-6737

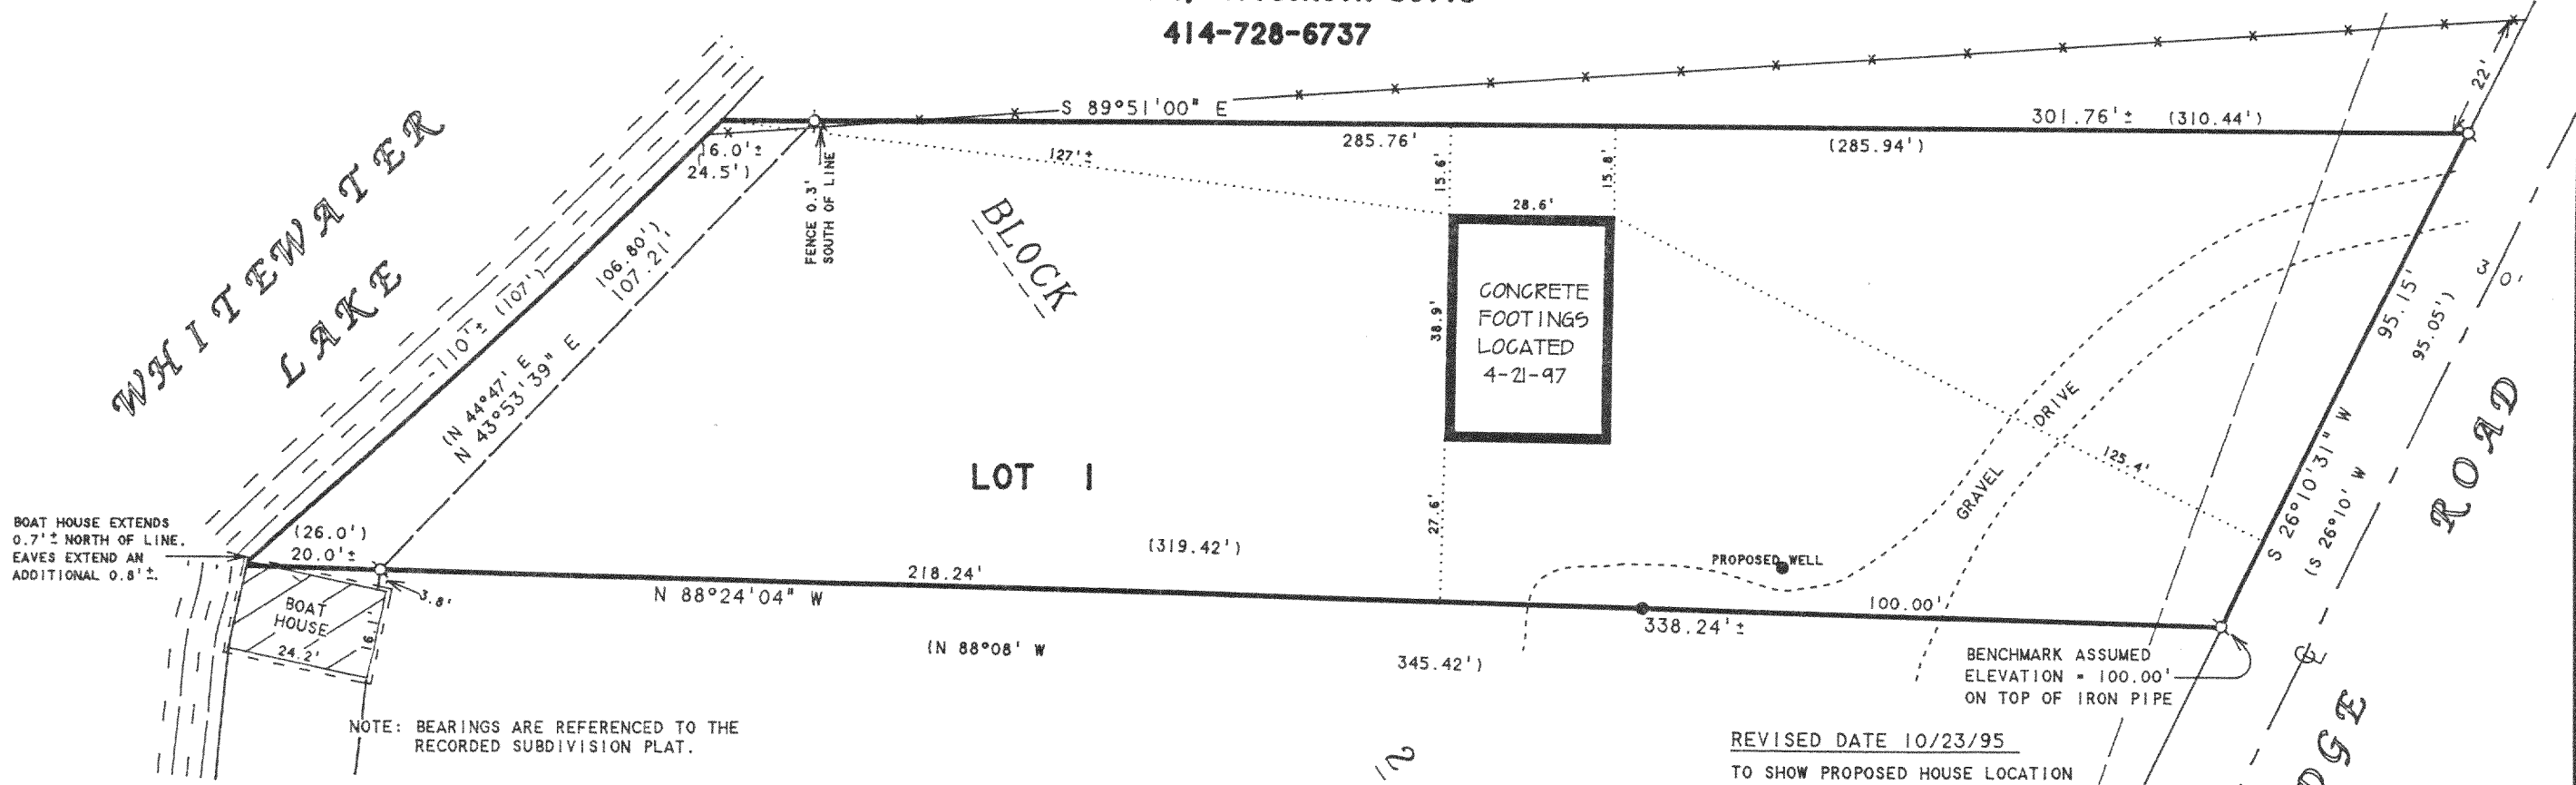

N

SCALE 1"=30'

LEGEND

- Ø -IRON PIPE FOUND
- OVERHEAD UTILITY LINES
- \* -WIRE FENCE
- ( ) -RECORDED AS
- -IRON ROD SET

PLAT OF SURVEY OF

LOT 1 BLOCK 2, MORaine HEIGHTS, LOCATED  
IN T4N, R1E, WALWORTH COUNTY, WISCONSIN.

ORDERED BY: RE/MAX - HEARTLAND REALTY  
239 E. MILWAUKEE STREET  
WHITEWATER, WI 53190

REVISED DATE 10/23/95  
TO SHOW PROPOSED HOUSE LOCATION  
AND TOPOGRAPHIC SURVEY.

REVISED DATE 4/9/97  
TO SHOW PROPOSED HOUSE AND STAKE IN FIELD

REVISED DATE 4/21/97  
TO SHOW LOCATION OF CONCRETE FOOTINGS.  
TOPOGRAPHIC SURVEY NOT SHOWN.

ORDERED BY: JACK & JENNA MECK  
9602 S. COOK  
OAK LAWN, IL 60453

I HEREBY CERTIFY THAT I HAVE SURVEYED THE ABOVE DESCRIBED PROPERTY AND THAT THE ABOVE MAP IS A TRUE REPRESENTATION THEREOF AND SHOWS THE SIZE AND LOCATION OF THE PROPERTY, ITS EXTERIOR BOUNDARIES, THE LOCATION OF ALL VISIBLE STRUCTURES AND DIMENSIONS OF ALL PRINCIPAL BUILDINGS THEREON, BOUNDARY FENCES, APPARENT EASEMENTS, ROADWAYS AND VISIBLE ENCROACHMENTS, IF ANY, TO THE BEST OF MY KNOWLEDGE AND BELIEF.

THIS SURVEY IS MADE FOR THE USE OF THE PRESENT OWNERS OF THE PROPERTY, AND ALSO THOSE WHO PURCHASE, MORTGAGE, OR GUARANTEE THE TITLE THERETO WITHIN ONE (1) YEAR FROM DATE HEREON.

David F. Abell

DAVID F. ABELL  
WISCONSIN REGISTERED LAND SURVEYOR, S-1596

August 2, 1995

DATE JOB NUMBER - 93251  
NOTE: THIS IS NOT A CERTIFIED COPY UNLESS SEALED.