



BOUNDARY SURVEY W/IMPROVEMENTS

WORK ORDERED BY:
PAM PAUL/COLDWELL BANKER
5 WEST WALWORTH STREET
ELKHORN, WISCONSIN 53121


FARRIS, HANSEN & ASSOCIATES, INC.
Engineering, Architecture, Surveying
7 Ridgeway Court P.O. Box 437
ELKHORN, WISCONSIN 53121
Office: (414) 723-2098
Fax: (414) 723-5886

REVISIONS

PROJECT NO.
4849
DATE:
9/26/97
SHEET NO.
1 OF 1

PLAT OF SURVEY


LOT 3 OF BAY VIEW ESTATES
LOCATED IN SECTION 26, TOWN 4 NORTH, RANGE 15 EAST,
TOWN OF WHITEWATER, WALWORTH COUNTY, WISCONSIN

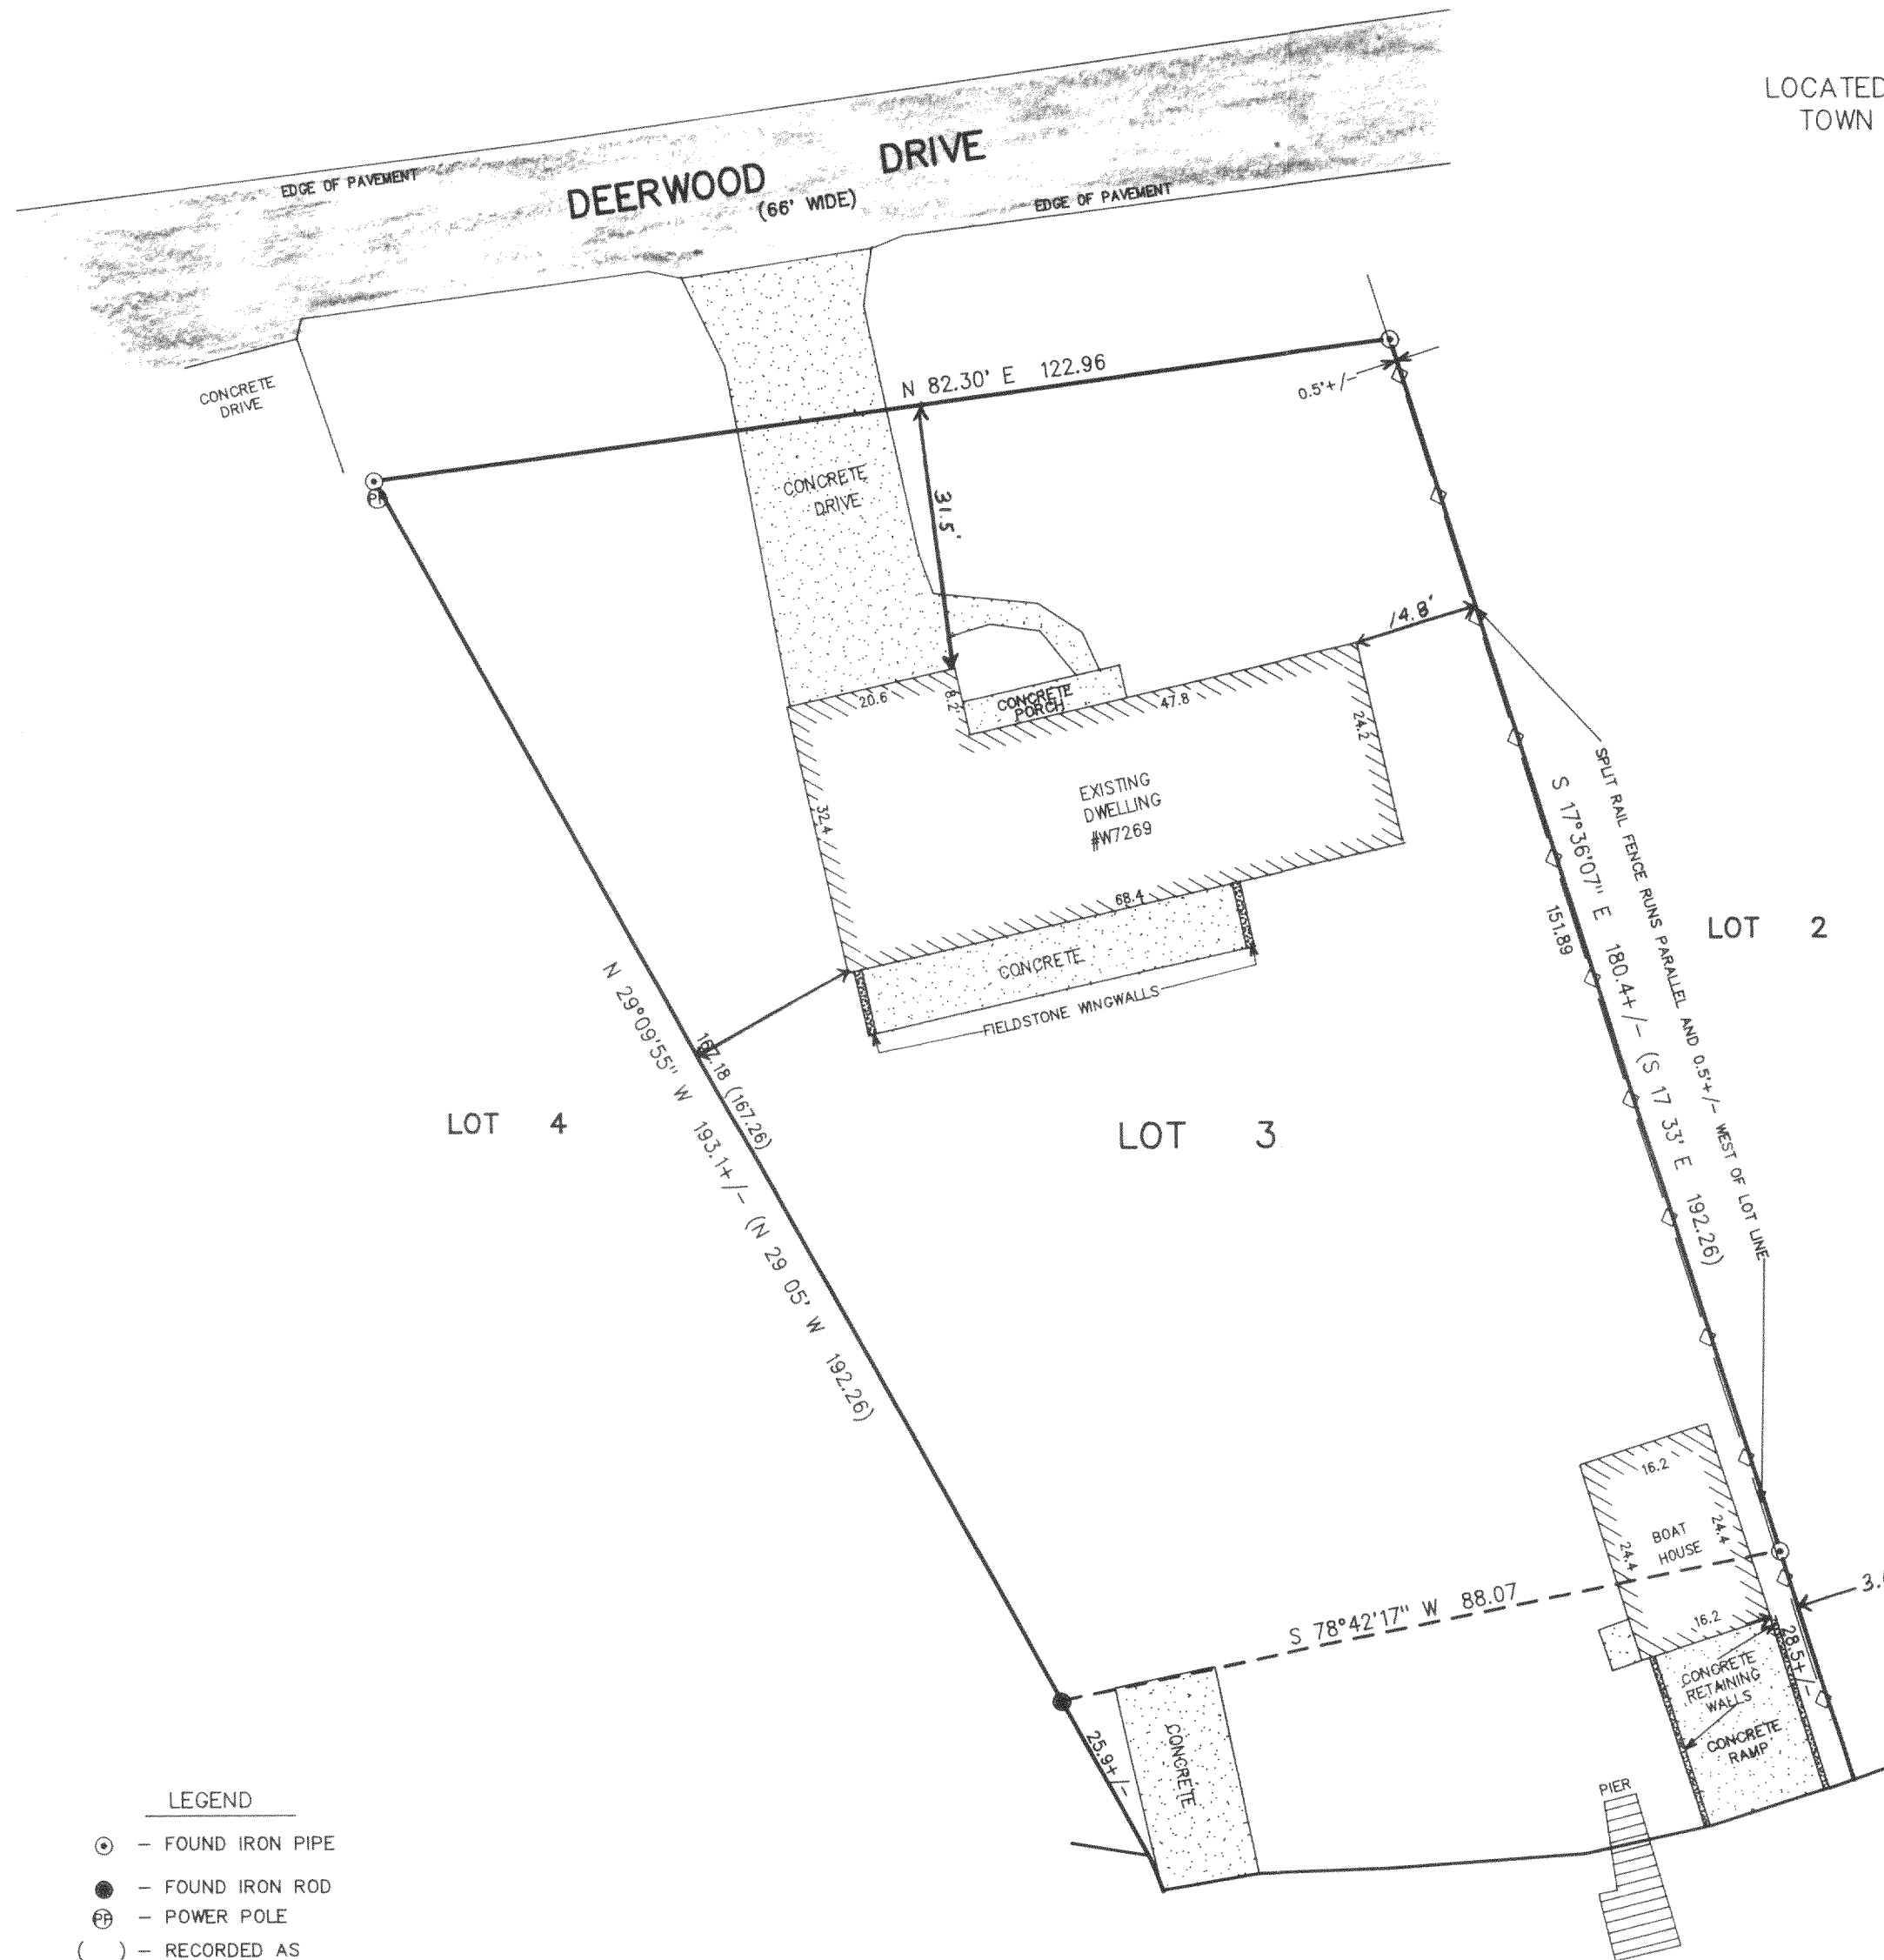

- LEGEND
- ⊕ - FOUND IRON PIPE
 - - FOUND IRON ROD
 - ⊕ - POWER POLE
 - () - RECORDED AS



BEARINGS REFERENCED TO THE
SOUTH LINE OF DEERWOOD DRIVE
RECORDED AS: N 82.30° E

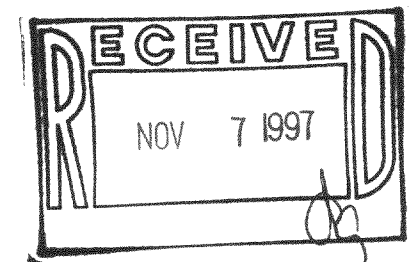

NOTE: COPIES OF THIS MAP TO WHICH THE FOLLOWING CERTIFICATE
WILL APPLY ARE BLUE LINE PRINTS SHOWING SURVEYOR'S ORIGINAL
SEAL AND SIGNATURE IN BLACK INK. COPIES BY ANY OTHER MEANS
MAY HAVE ALTERATIONS WHICH DO NOT REPRESENT THE SURVEYOR'S
WORK PRODUCT.

I HEREBY CERTIFY THAT THE ABOVE DESCRIBED PROPERTY HAS BEEN
SURVEYED UNDER MY DIRECTION AND THAT THE ABOVE MAP IS A TRUE
REPRESENTATION THEREOF AND SHOWS THE SIZE AND LOCATION OF
THE PROPERTY AND ITS EXTERIOR BOUNDARIES. THIS SURVEY IS
MADE FOR THE USE OF THE PRESENT OWNERS OF THE PROPERTY, AND
ALSO THOSE WHO PURCHASE, MORTGAGE, OR GUARANTEE THE TITLE
THERE TO WITHIN ONE YEAR FROM THE DATE HEREOF.

DATED: 9/26/97

Peter S. Gordon
PETER S. GORDON R.L.S. 2101

