


ABELL  
SURVEYING & MAPPING LOT 71

1140 SEQUOIA STREET • DELAVAN, WISCONSIN 53115  
414-726-6737

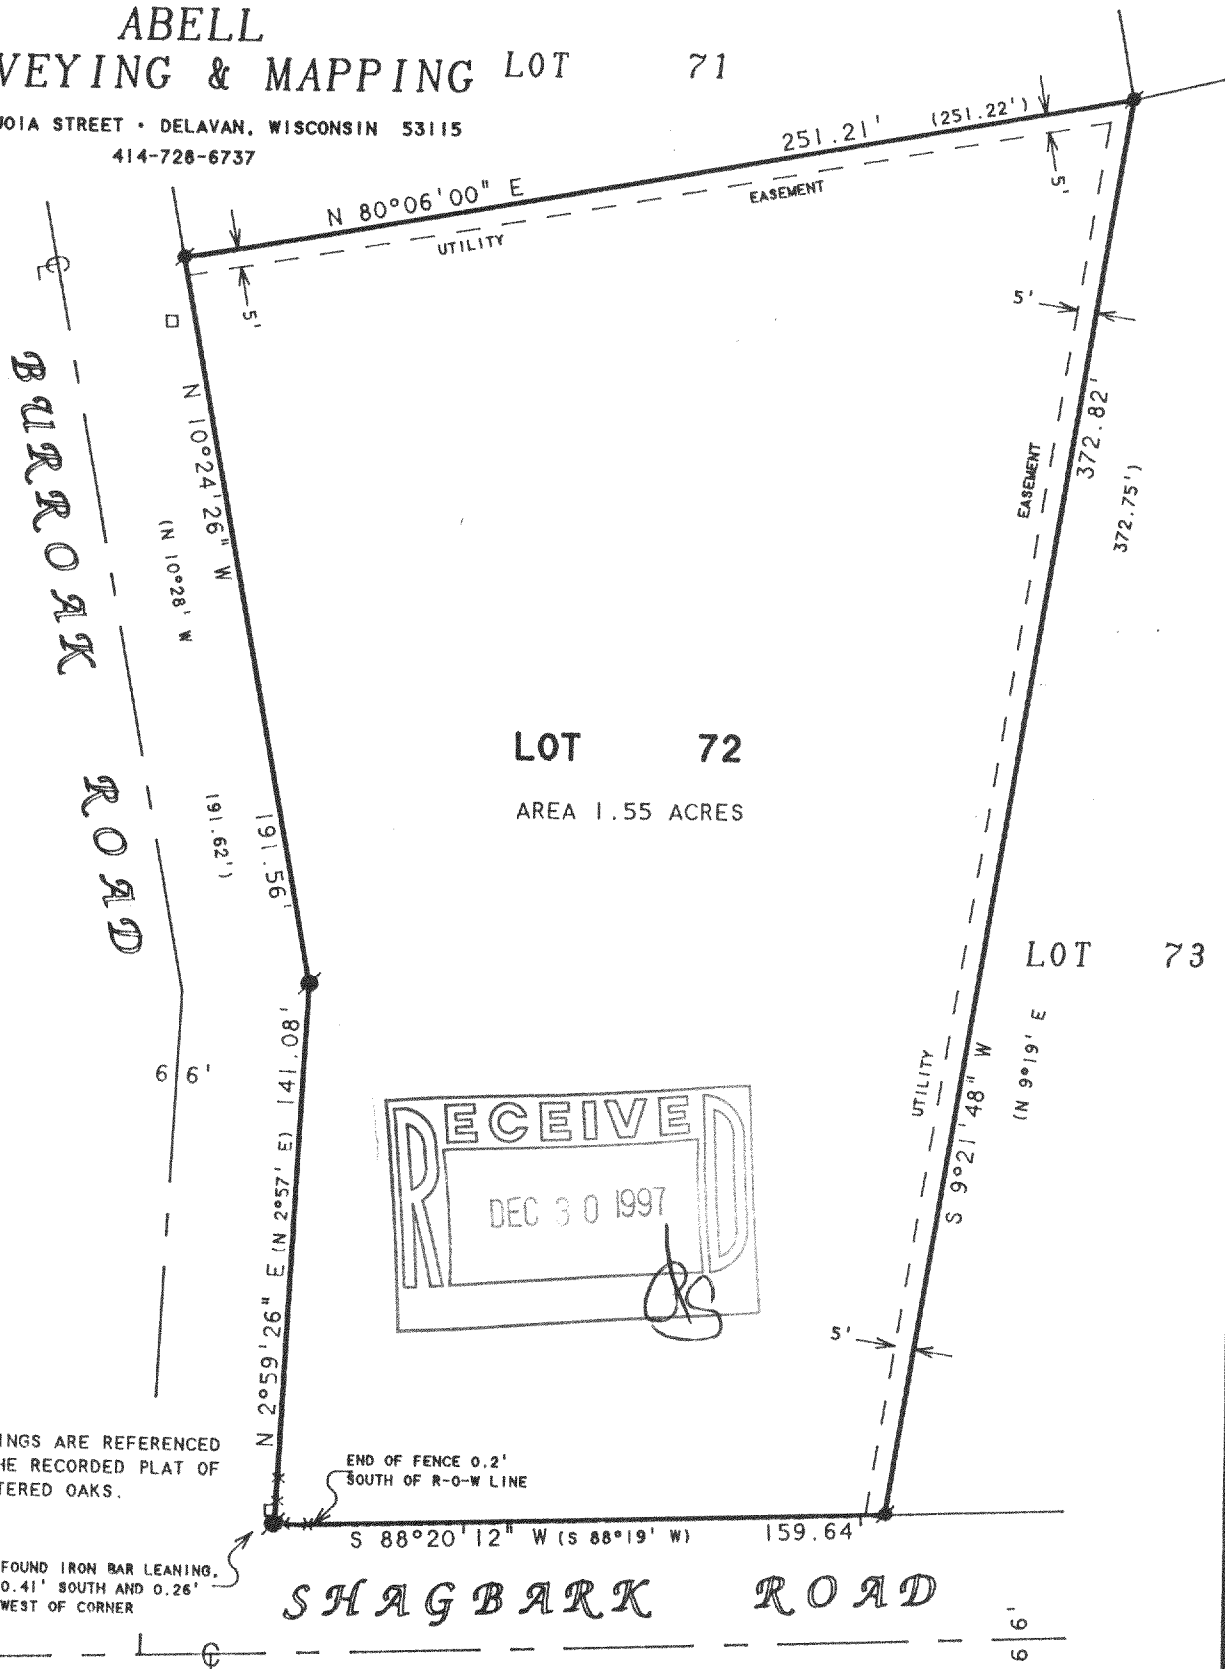

415-6216

DSO-72