

ABERNATHY and ASSOCIATES

Kenneth B. Abernathy Jr.

Wisconsin Registered Land Surveyor S-1594


Rt. 3, Box 273
Elkhorn, Wisconsin 53121
Phone: (414) 723-4260 (office)
(414) 723-4813 (residence)

PLAT OF SURVEY

LOT 19, BLOCK 1, OF MORaine HEIGHTS SUBDIVISION
SECTION 26, T.4N., R.15E. TOWN OF WHITEWATER,
WALWORTH COUNTY, WISCONSIN.

ORDERED BY: SEARS MORTGAGE
2514 S. 102nd ST.
WEST ALLIS, WI. 53227



BUYERS: GREG & JEANE SITEK
224 LINCOLN
GLENDALE HEIGHTS
CHICAGO, ILL. 60139

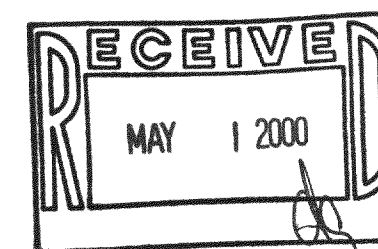

Legend

- FOUND IRON PIPE
- FOUND IRON ROD
- FOUND BRASS CAPPED MONUMENT
- FOUND CONCRETE MONUMENT
- CHISEL CUT IN CONCRETE
- SET IRON ROD, 24" LONG, WEIGHING 1.5 LBS., LINEAL FT., 3/4" DIA.
- SET IRON ROD, 30" LONG, WEIGHING 4.5 LBS., LINEAL FT., 1-11/16" DIA.
- (xx) RECORDED AS DIMENSION
- EXISTING FENCE

DETAIL SCALE 1"=10'
GARAGE ENCROACHMENT

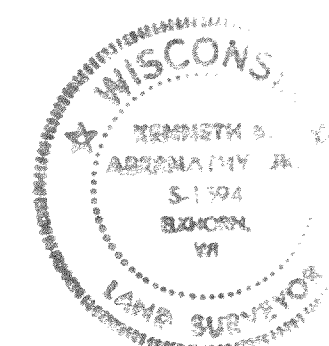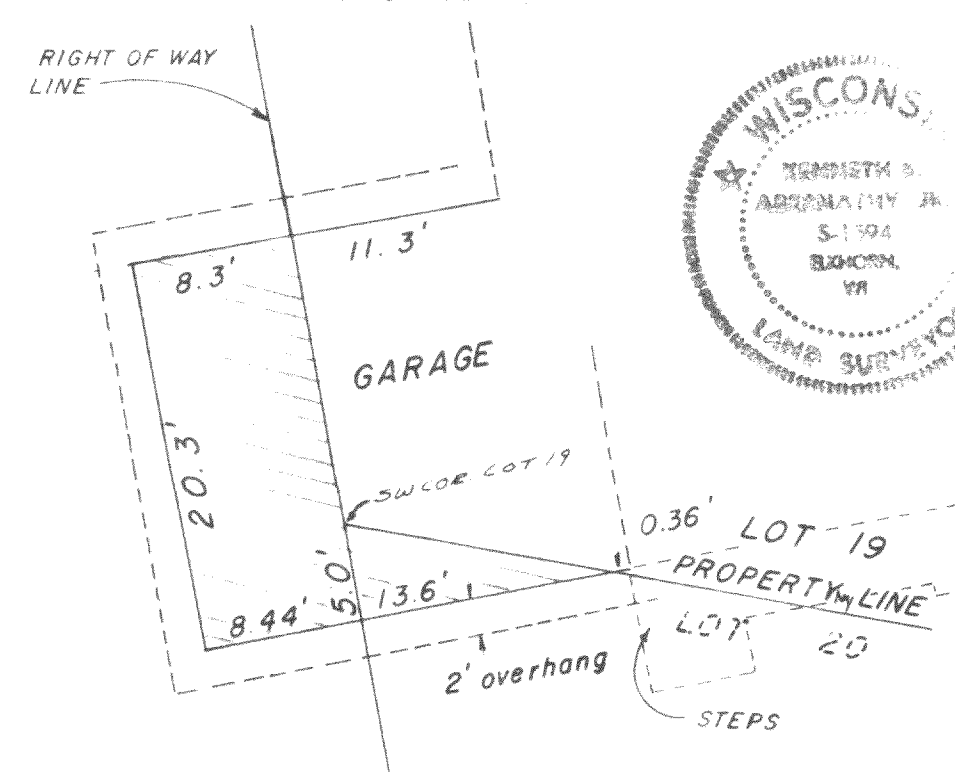

SCALE: 1"=20 FEET

I hereby certify that I have surveyed the above described property and that the above map is a true representation thereof and shows the size and location of the property, its exterior boundaries, the location of all visible structures and dimensions of all principal buildings thereon, boundary fences, apparent easements, roadways and visible encroachments, if any.

This survey is made for the use of the present owners of the property, and also those who purchase, mortgage, or guarantee the title thereto within one year from date hereof.

Kenneth B. Abernathy Jr.

KENNETH B. ABERNATHY, JR.
WISCONSIN REGISTERED LAND SURVEYOR,
S-1594

Date: 4-7-87 Job No. 307

DMH-19

415-746