



PLAT OF SURVEY

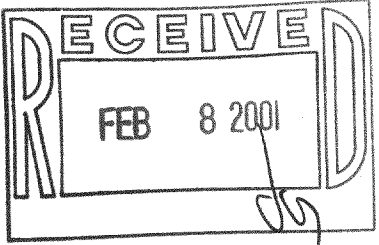

LOT 16, BLOCK 2, MORaine HEIGHTS SUBDIVISION, LOCATED IN SECTIONS 26 AND 35, TOWN 4 NORTH, RANGE 15 EAST, WHITEWATER TOWNSHIP, WALWORTH COUNTY, WISCONSIN.

ORDERED BY: Home Design Manufacturing
Post Office Box 527
Fontana, Wisconsin 53125

OWNER: ROBERT SIVEK
636 WHITE OAK LANE
BARTLETT, ILL. 60103

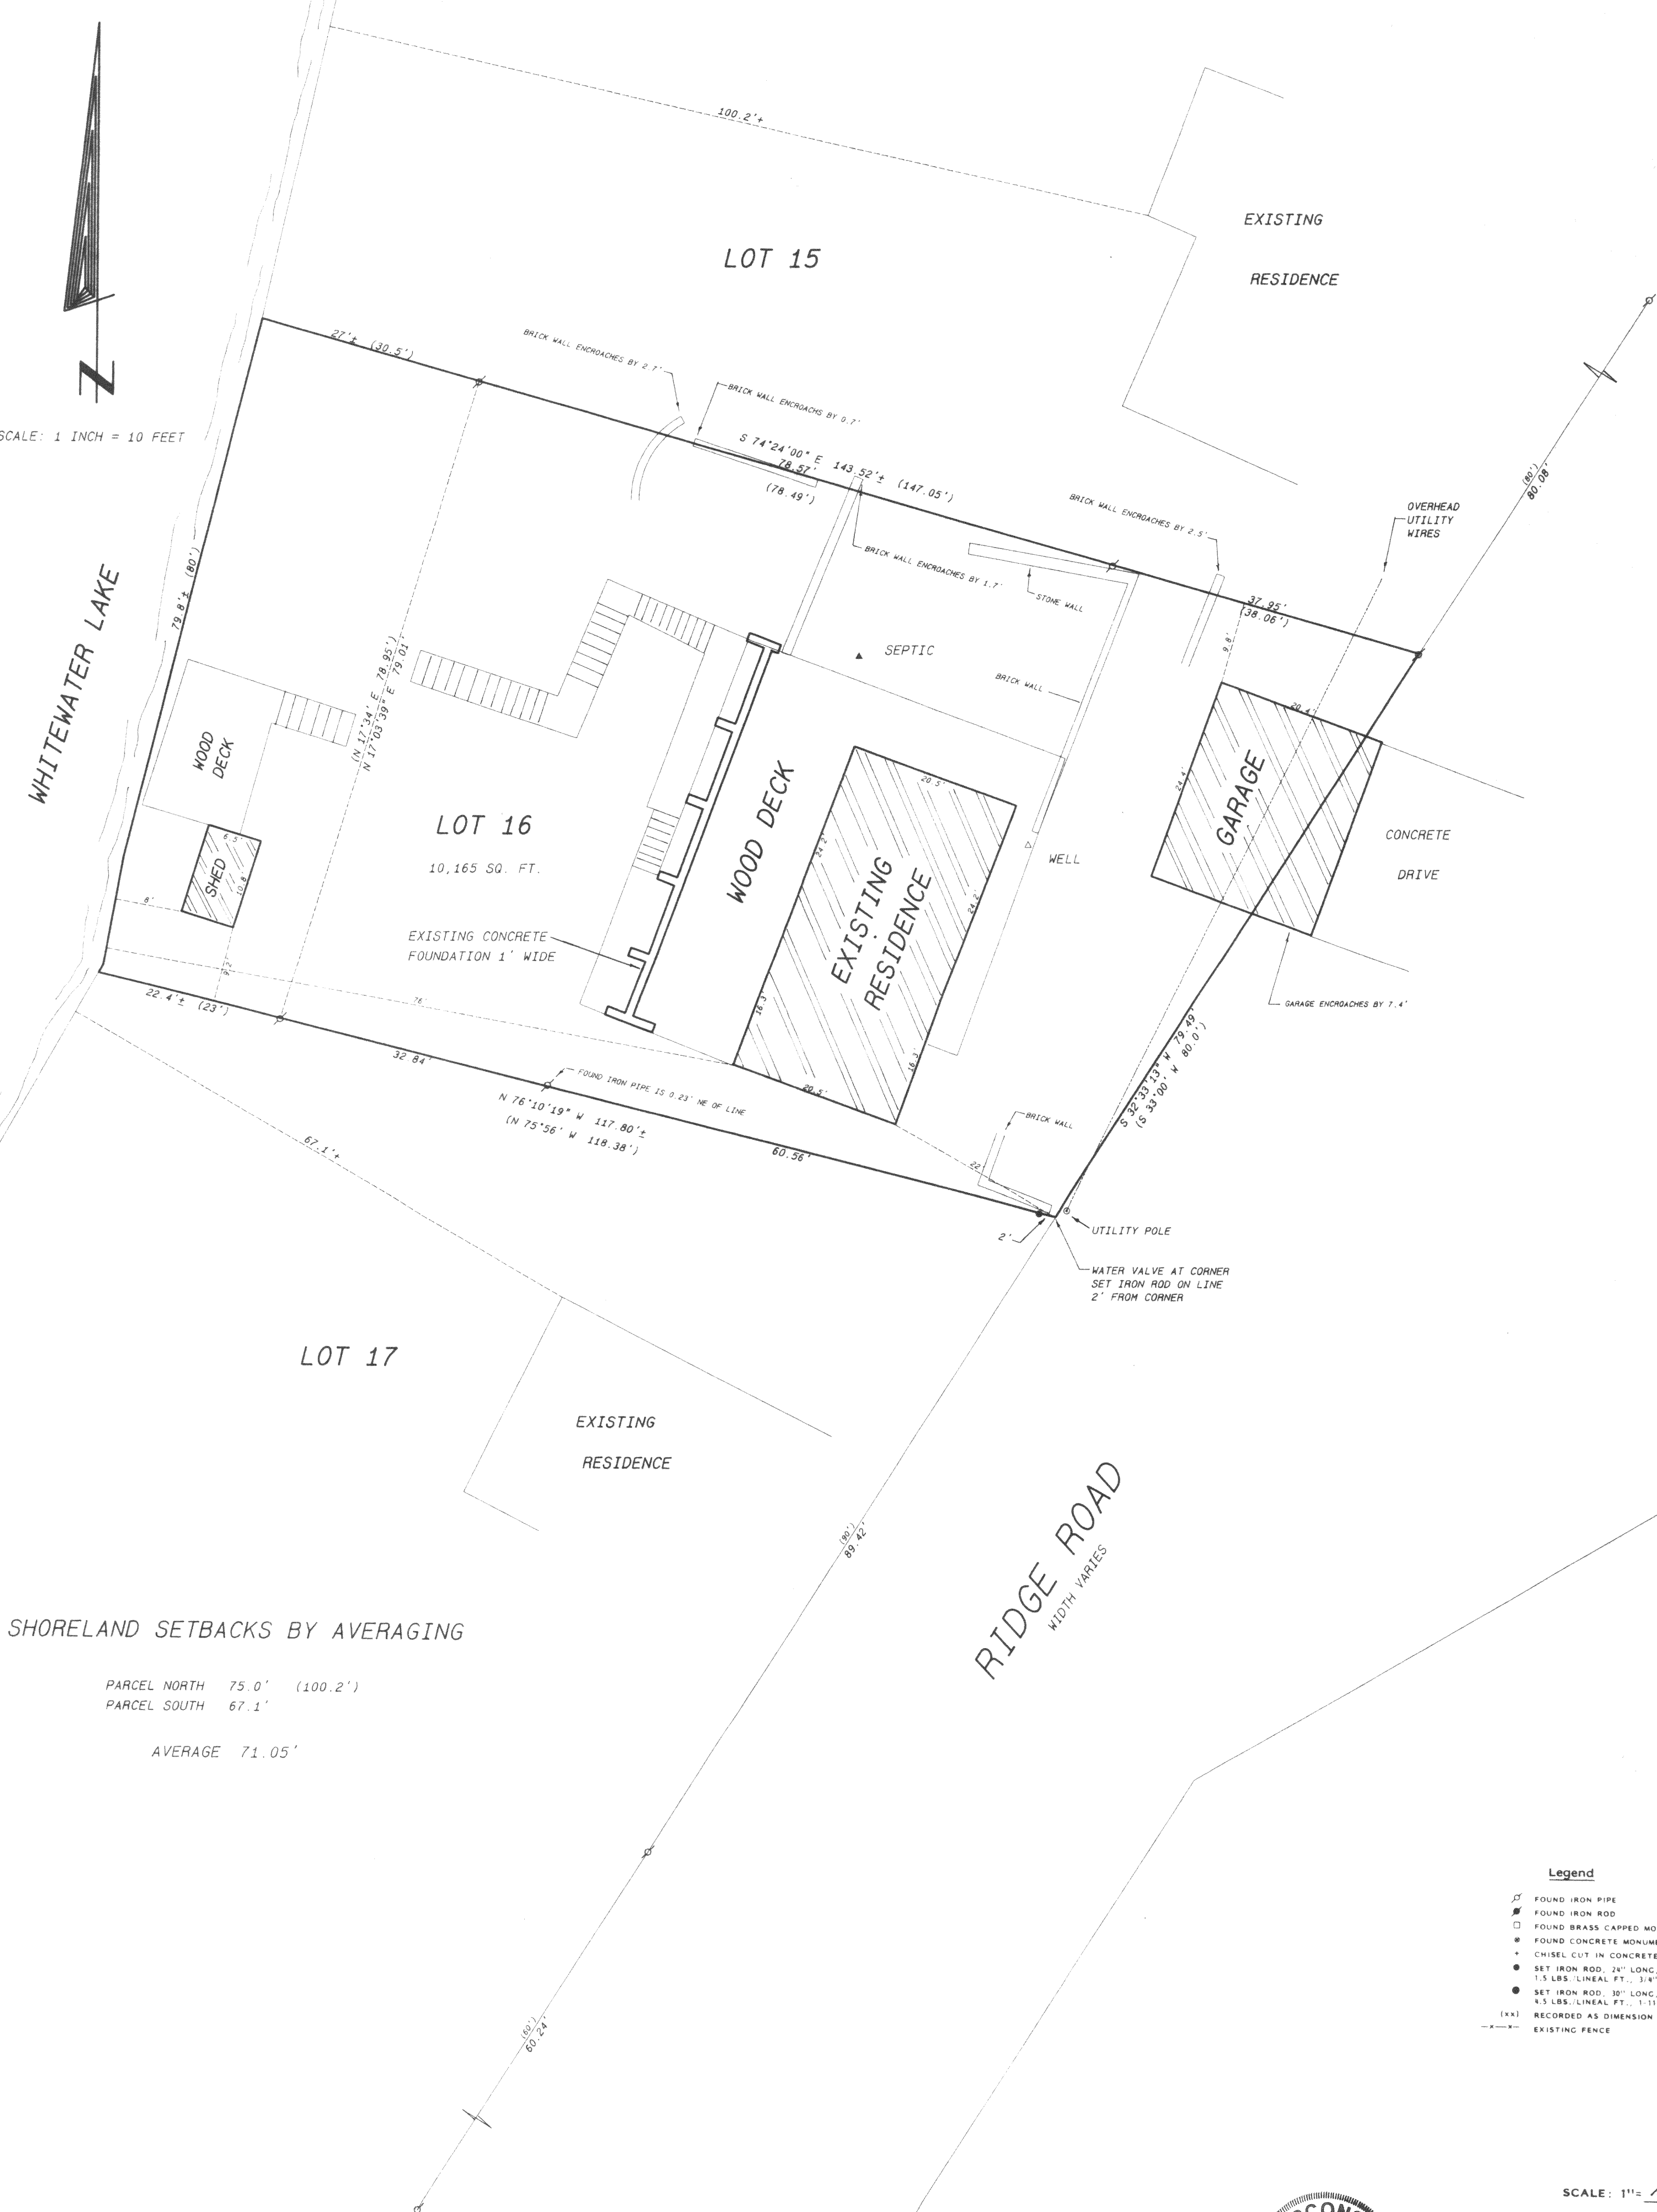

SHORELAND SETBACKS BY AVERAGING

PARCEL NORTH 75.0' (100.2')
PARCEL SOUTH 67.1'

AVERAGE 71.05'

- Legend
- FOUND IRON PIPE
 - FOUND IRON ROD
 - FOUND BRASS CAPPED MONUMENT
 - FOUND CONCRETE MONUMENT
 - CHISEL CUT IN CONCRETE
 - SET IRON ROD, 24" LONG, WEIGHING 1.5 LBS./LINEAL FT., 3/8" DIA.
 - SET IRON ROD, 30" LONG, WEIGHING 4.5 LBS./LINEAL FT., 1-1/16" DIA.
 - RECORDED AS DIMENSION
 - EXISTING FENCE

SCALE: 1"= 10 FEET



I hereby certify that the above described property has been surveyed by me or under my direction and that the above map is a true representation thereof and shows the size and location of the property, its exterior boundaries, the location of all visible structures and dimensions of all principal buildings thereon, boundary fences, apparent easements, roadways and visible encroachments, if any. This survey is made for the use of the present owners of the property, and also those who purchase, mortgage, or guarantee the title thereto within one year from date hereof.

Kenneth B. Abernathy, Jr.
KENNETH B. ABERNATHY, JR.
WISCONSIN REGISTERED LAND SURVEYOR, S-1594
Date: Jan. 22, 2001 Job No. 01.105