


ABELL
SURVEYING & MAPPING

1140 SEQUOIA STREET • DELAVAN, WISCONSIN 53115
262-728-6737

PLAT OF SURVEY OF

LOT 11, BLOCK 2, LUDTKE SUBDIVISION,
LOCATED IN T4N,R15E, WALWORTH COUNTY,
WISCONSIN.

ORDERED BY: MIKE HAJEK
5808 AMHURST COURT
McHENRY, IL 60050

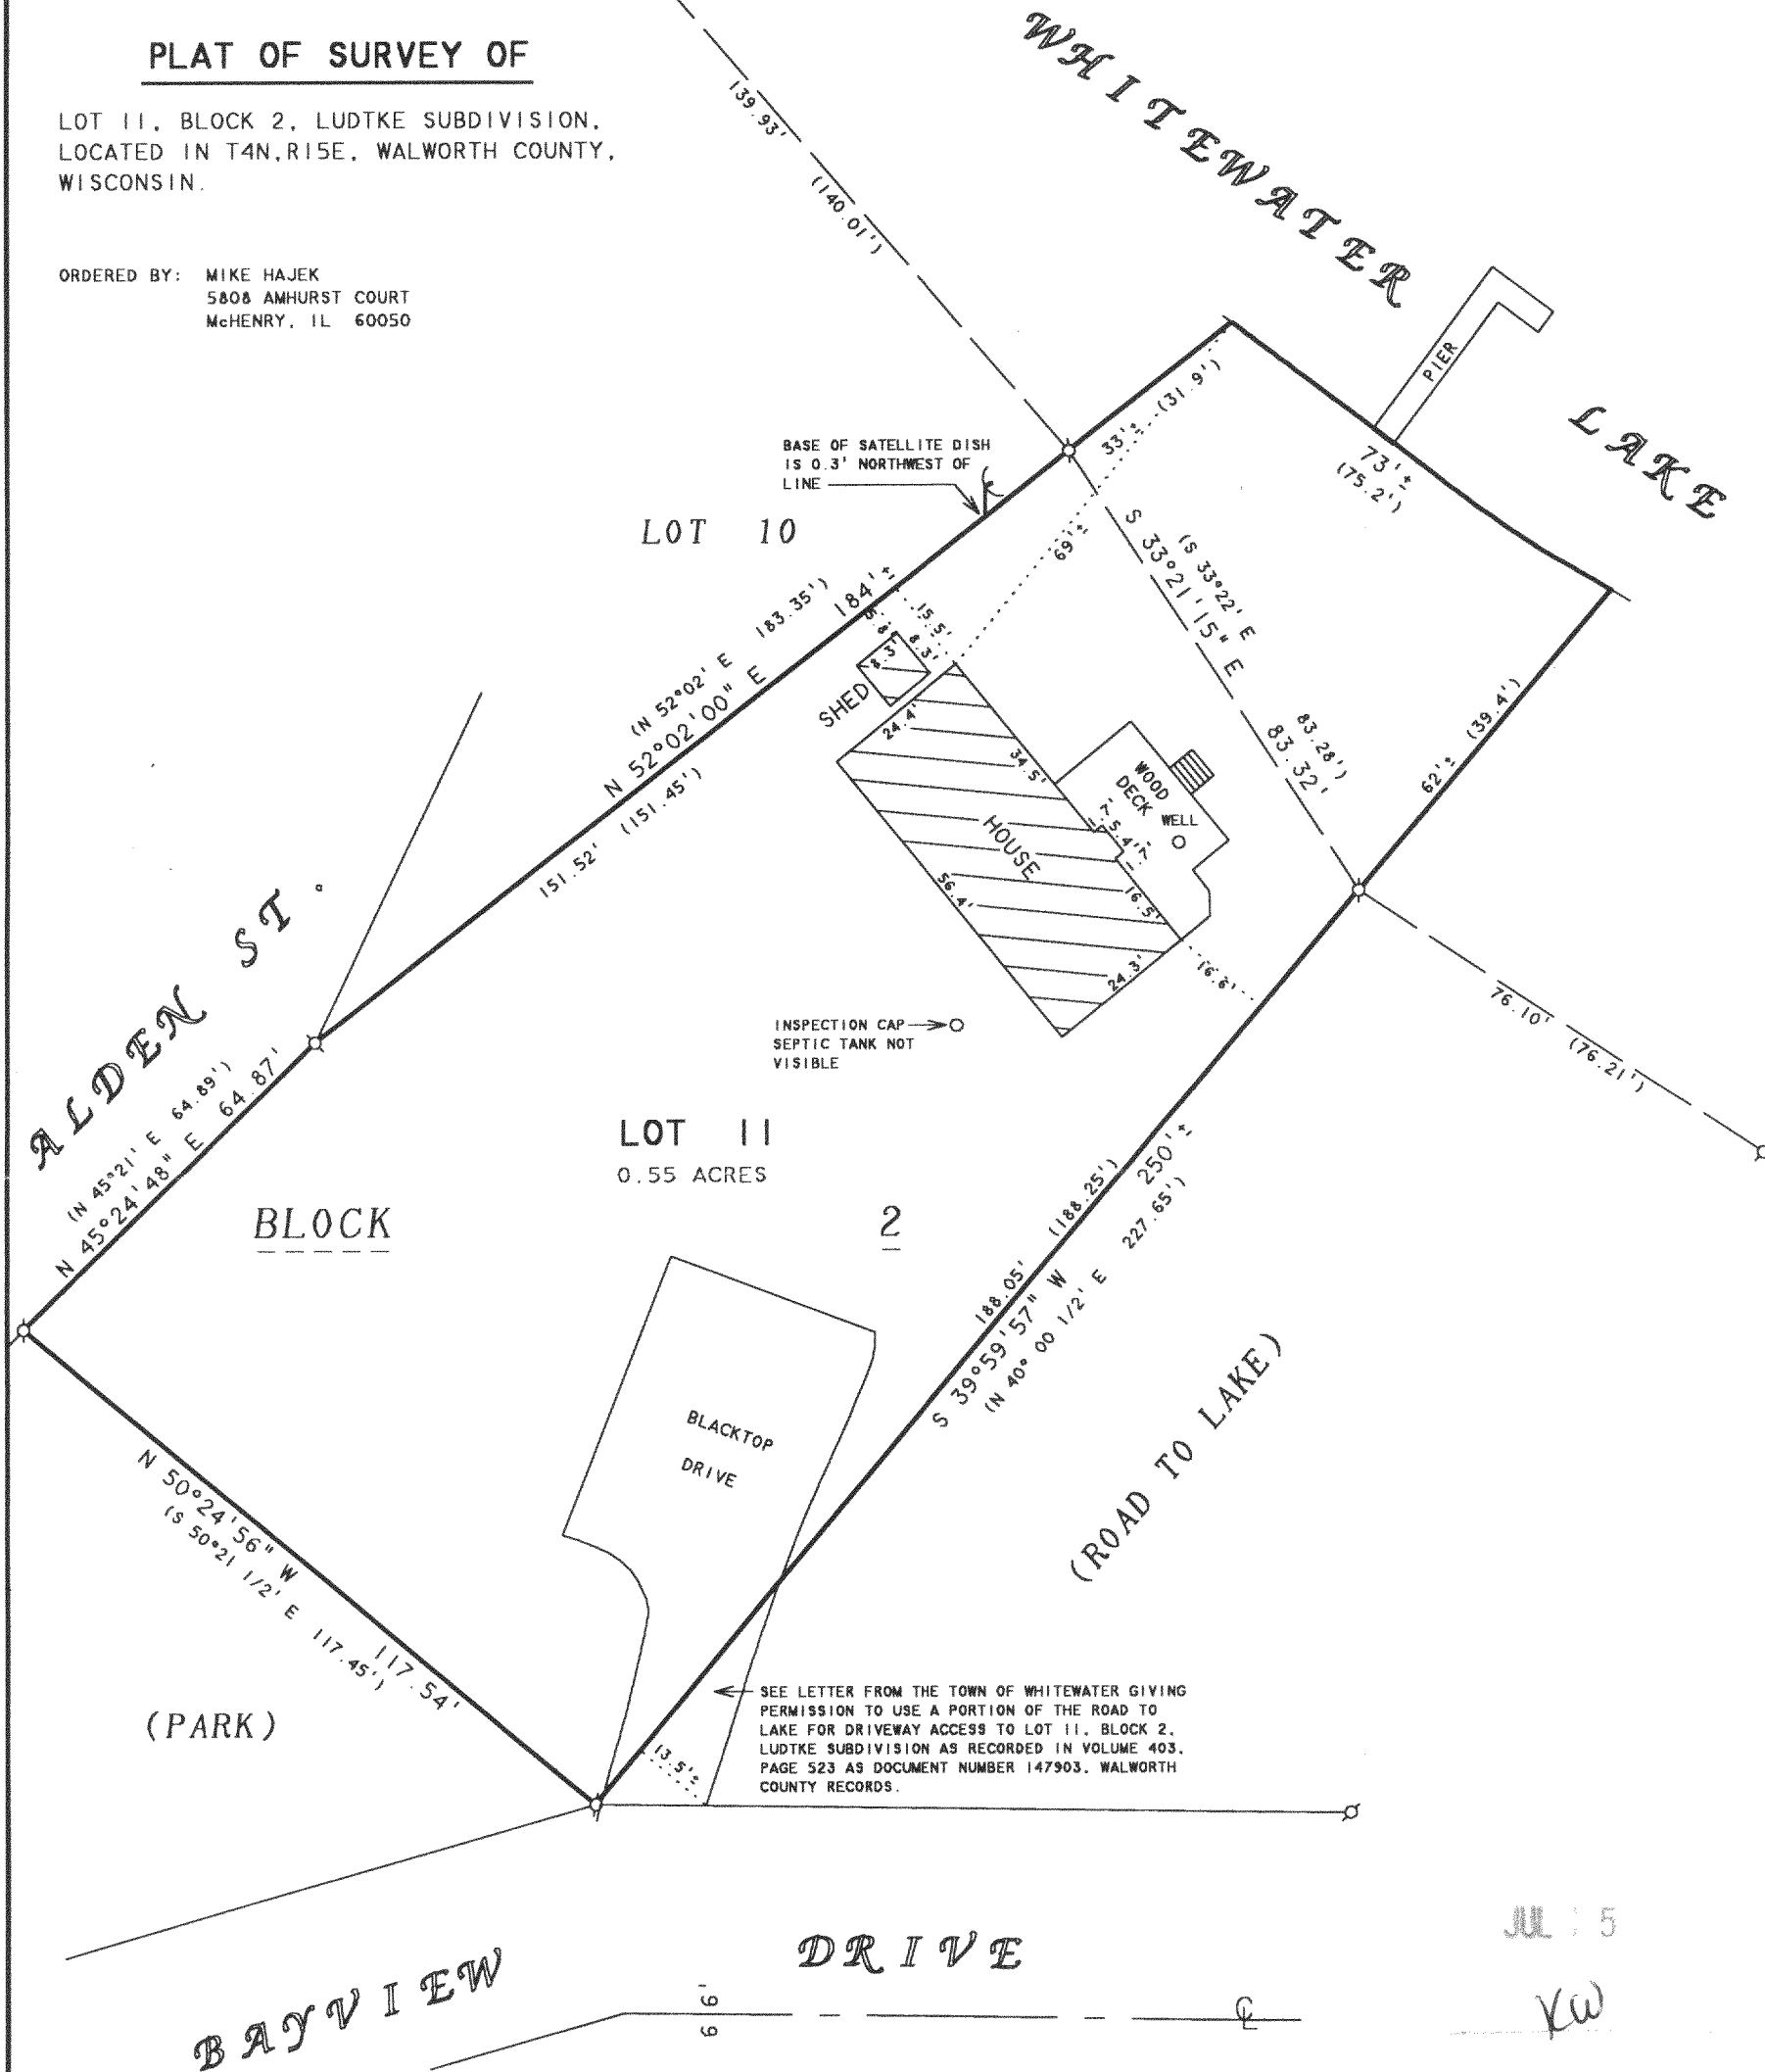

DLS 00014

415-966