
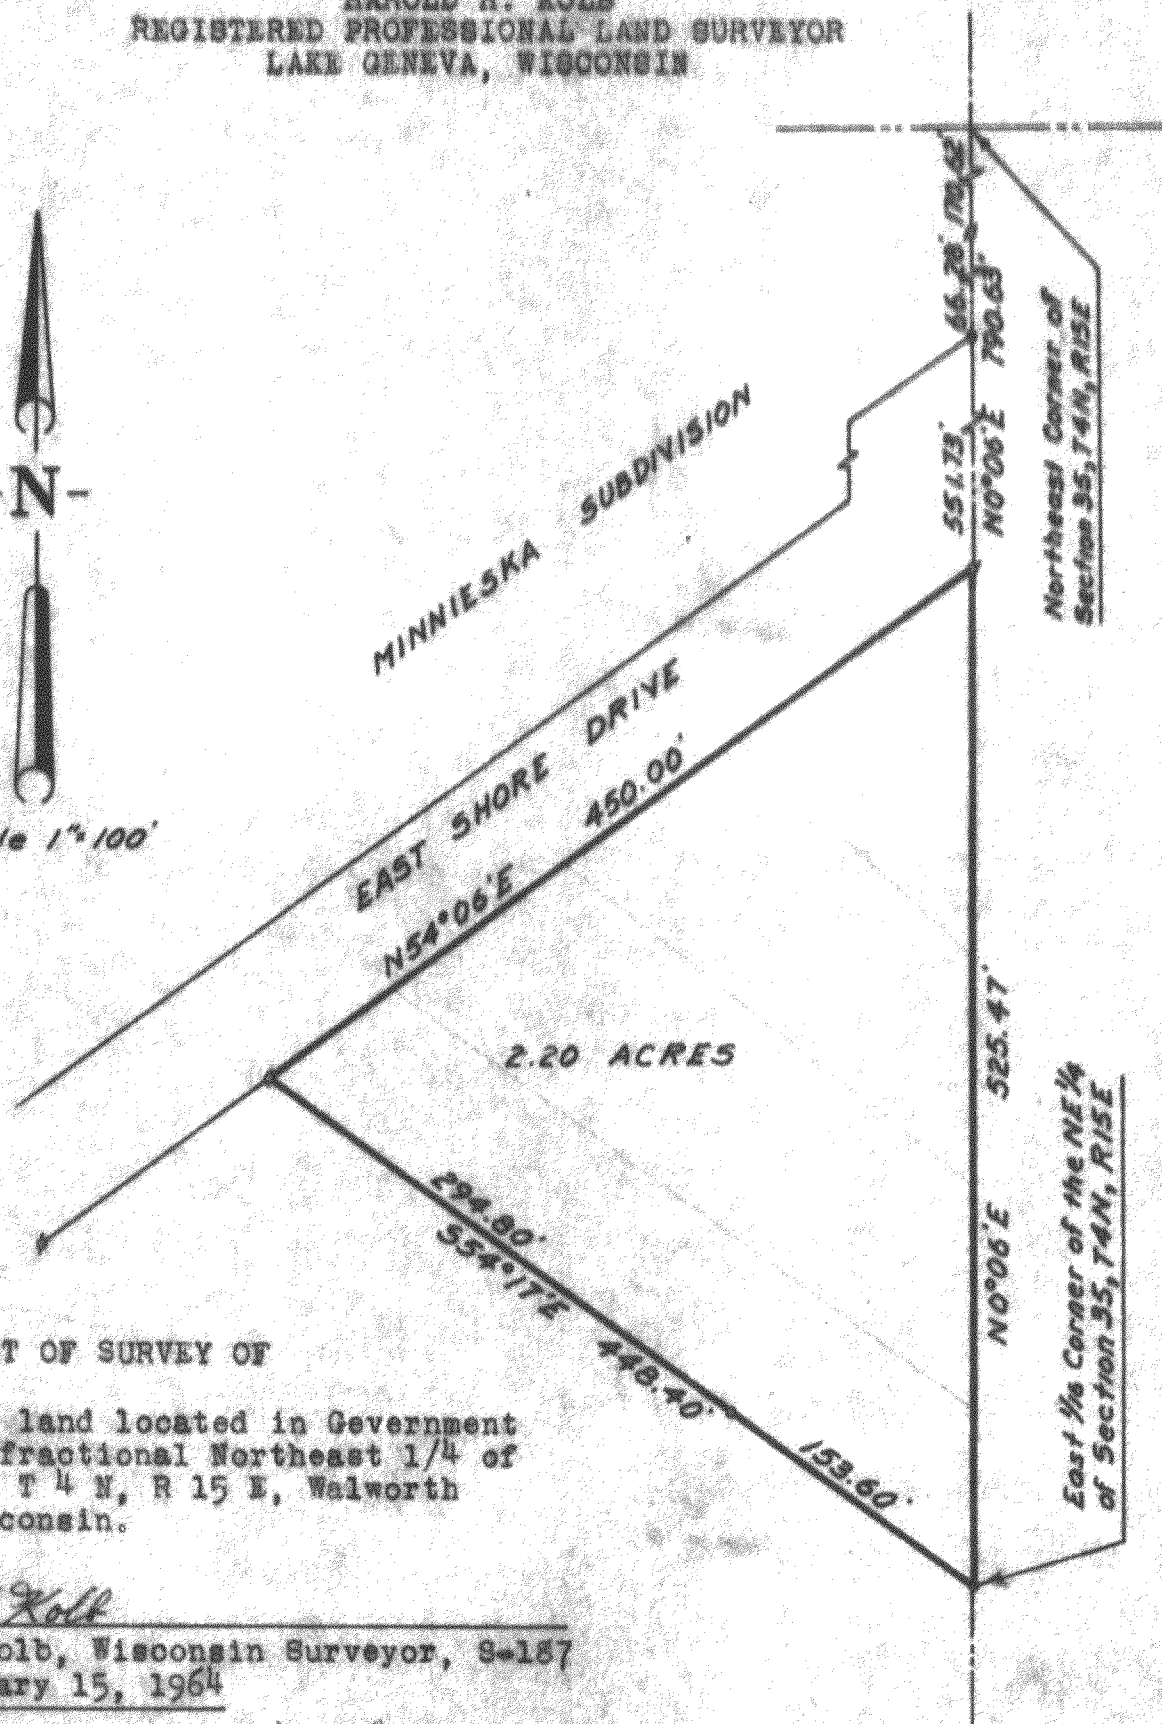


HAROLD H. KOLB
REGISTERED PROFESSIONAL LAND SURVEYOR
LAKE GENEVA, WISCONSIN

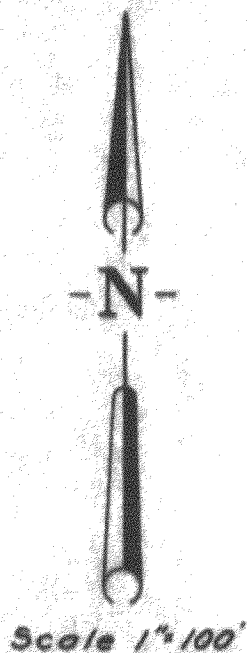

PLAT OF SURVEY OF

A parcel of land located in Government
Lot 1, The fractional Northeast 1/4 of
Section 35, T 4 N, R 15 E, Walworth
County, Wisconsin.

Harold H. Kolb

Harold H. Kolb, Wisconsin Surveyor, S-187
DATE: February 15, 1964

Now Lots 1-4 Cont Int No 6

- - Concrete Monument Found
- - Iron Pipe Found
- - Iron Pipe Placed

415-99