
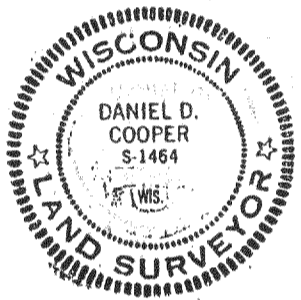


D.D. COOPER & CO. INC.

Route 4 Box 508B
Elkhorn WI 53121
Phone-414-723-6265

DEERWOOD DRIVE

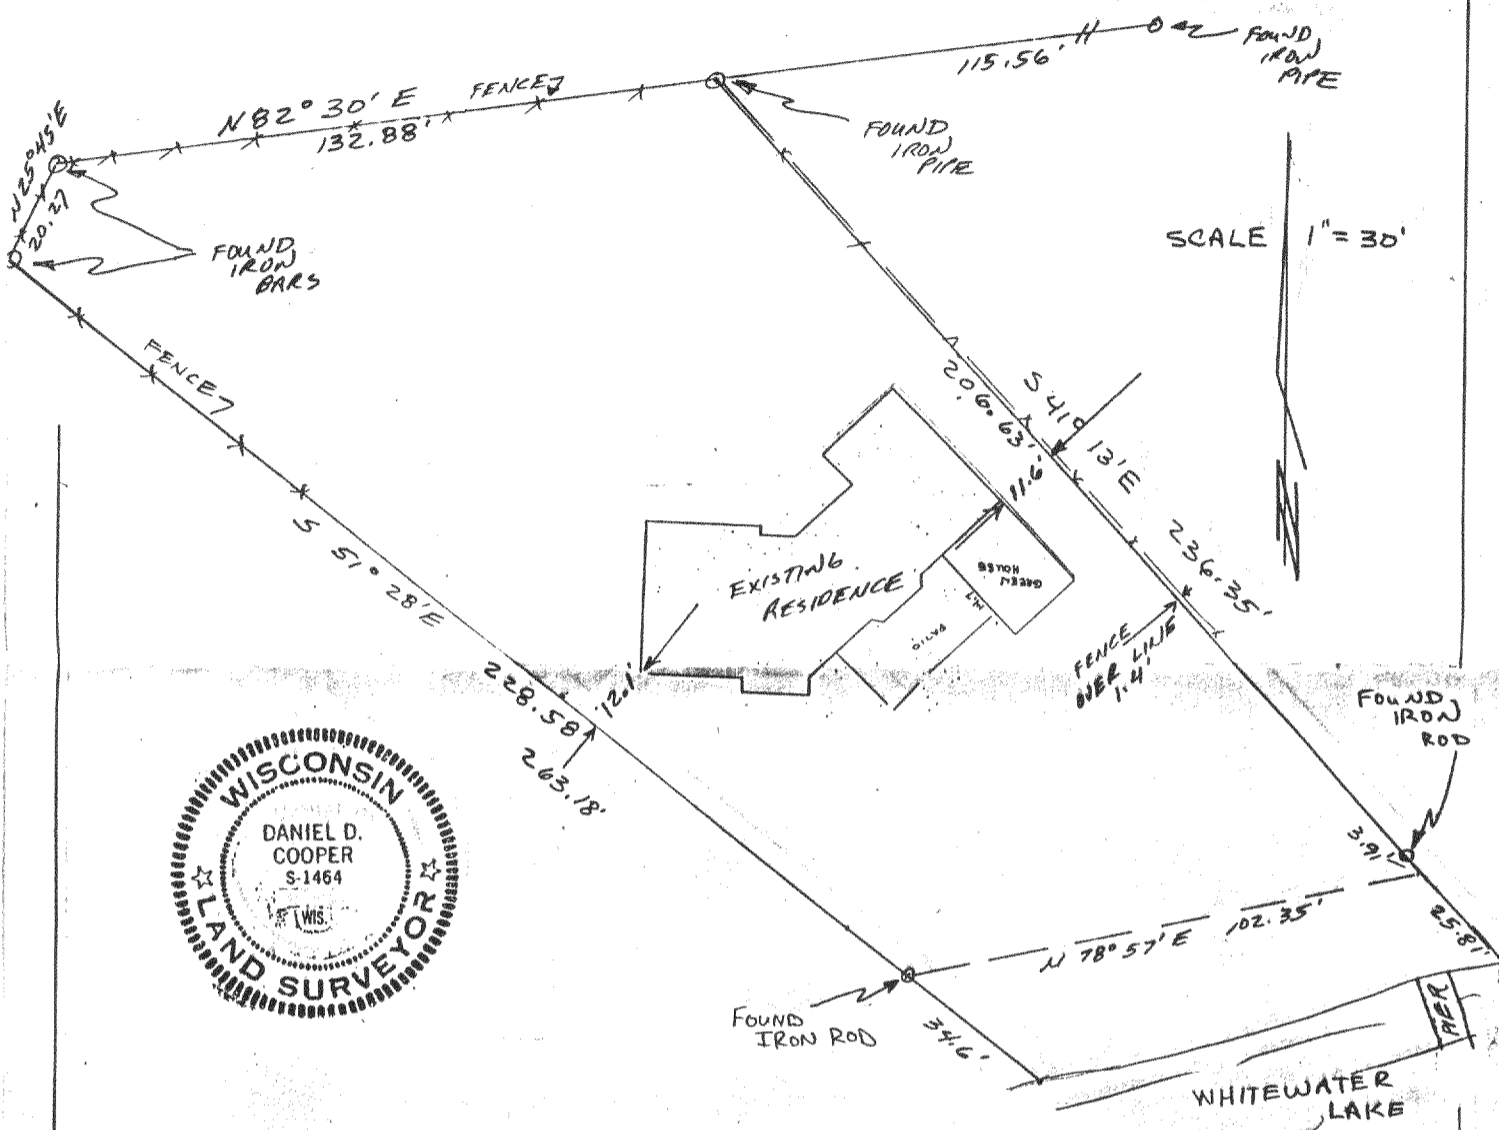

Bearing reference: Southerly line of Deerwood Drive assumed to bear N82°30'E as recorded.

Plat of Survey of Lot 6 Bayview Subdivision located in T4N, R15E, Walworth County Wisconsin.


Survey ordered by Town, Lake, County Realty

I, Daniel D. Cooper, Registered Land Surveyor do hereby certify that I have surveyed the property described hereon and that the map shown hereon is a true and accurate representation thereof to the best of my professional knowledge and belief.

Dated this 19th day of June 1990

Daniel D. Cooper
Daniel D. Cooper, RLS NO. S-1464

DRAWING NO-3652-6-20

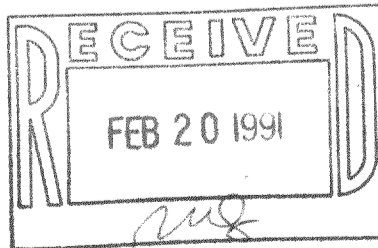

Reduced

TAX KEY # DBVE 00006

415-317