

# LAND-MARK SURVEYING

Mark L. Miritz

Wisconsin Registered Land Surveyor S-2582

N9330 Knuteson Drive  
Whitewater, WI 53190  
Phone: (262) 495-3284  
FAX : (262) 495-8421  
LAND-MARKSURVEYING.COM

## PLAT OF SURVEY

### LOT 18 OF BLOCK 3 OF GRAND VIEW SUBDIVISION

LOCATED IN THE SOUTHEAST 1/4 OF SECTION 34  
TOWN 4 NORTH, RANGE 15 EAST, TOWN OF WHITEWATER,  
WALWORTH COUNTY, WISCONSIN.

Ordered by: Schauder Building, Inc.  
4115 North U.S. Highway 51  
Janesville, WI. 53545-9674

CLIENT REFERENCE: JO AND MARY JO GEORGEN  
175 VISTA ROAD  
LAKE ZURICH, IL. 60047

JUN 26 2005

BLOCK

LOT 23

LOT 22

LOT 21

LOT 19

3

LOT 17

LOT 18

10,127 S.F. ( 0.23 AC.)


SOILS TEST AREA  
SOIL BORING (typical)

EXISTING  
FOUNDATION

PROPOSED  
DRIVEWAY

KETTLE MORaine DRIVE  
66' wide

iron pipe is bent  
S 11°03'W 0.35'

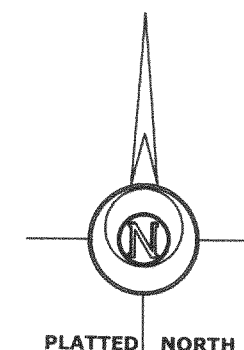

## LEGEND

- FOUND IRON PIPE
- FOUND IRON ROD
- FOUND COUNTY MONUMENT
- WOOD STAKES AT 10' OFFSETS
- CHISEL CUT IN CONCRETE
- SET IRON ROD, 24" LONG, WEIGHING 1.5 LBS./LINEAL FT., 3/4" DIA.
- RECORDED AS DIMENSION
- EXISTING FENCE

SCALE: 1" = 30 FEET

"I hereby certify that the above described property has been surveyed by me or under my direction and that the above map is a true representation thereof and shows the size and location of the property, its exterior boundaries, the location of all visible structures and dimensions of all principal buildings thereon, boundary fences, apparent easements, roadways and visible encroachments, if any."  
"This survey is made for the use of the present owners of the property, and also those who purchase, mortgage, or guarantee the title thereto within one year from date hereof."



MARK L. MIRITZ  
WISCONSIN REGISTERED  
LAND SURVEYOR S-2582

DATE: March 12, 2005 JOB NO. 05.215

REVISED MAY 12, 2005 TO SHOW FOUNDATION "AS BUILT"

415-1019

DGD 00036