
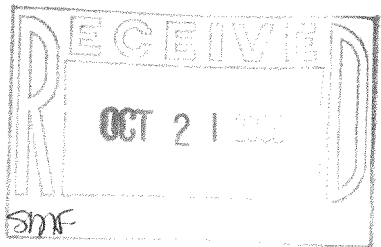


PLAT OF SURVEY

LOT 1, CERTIFIED SURVEY MAP NO. 2556, located in the Southeast 1/4 of the Northwest 1/4 of Section 13, Town 4 North, Range 15 East, Town of Whitewater, Walworth County, Wisconsin.


Surveyed for: Jana Holt

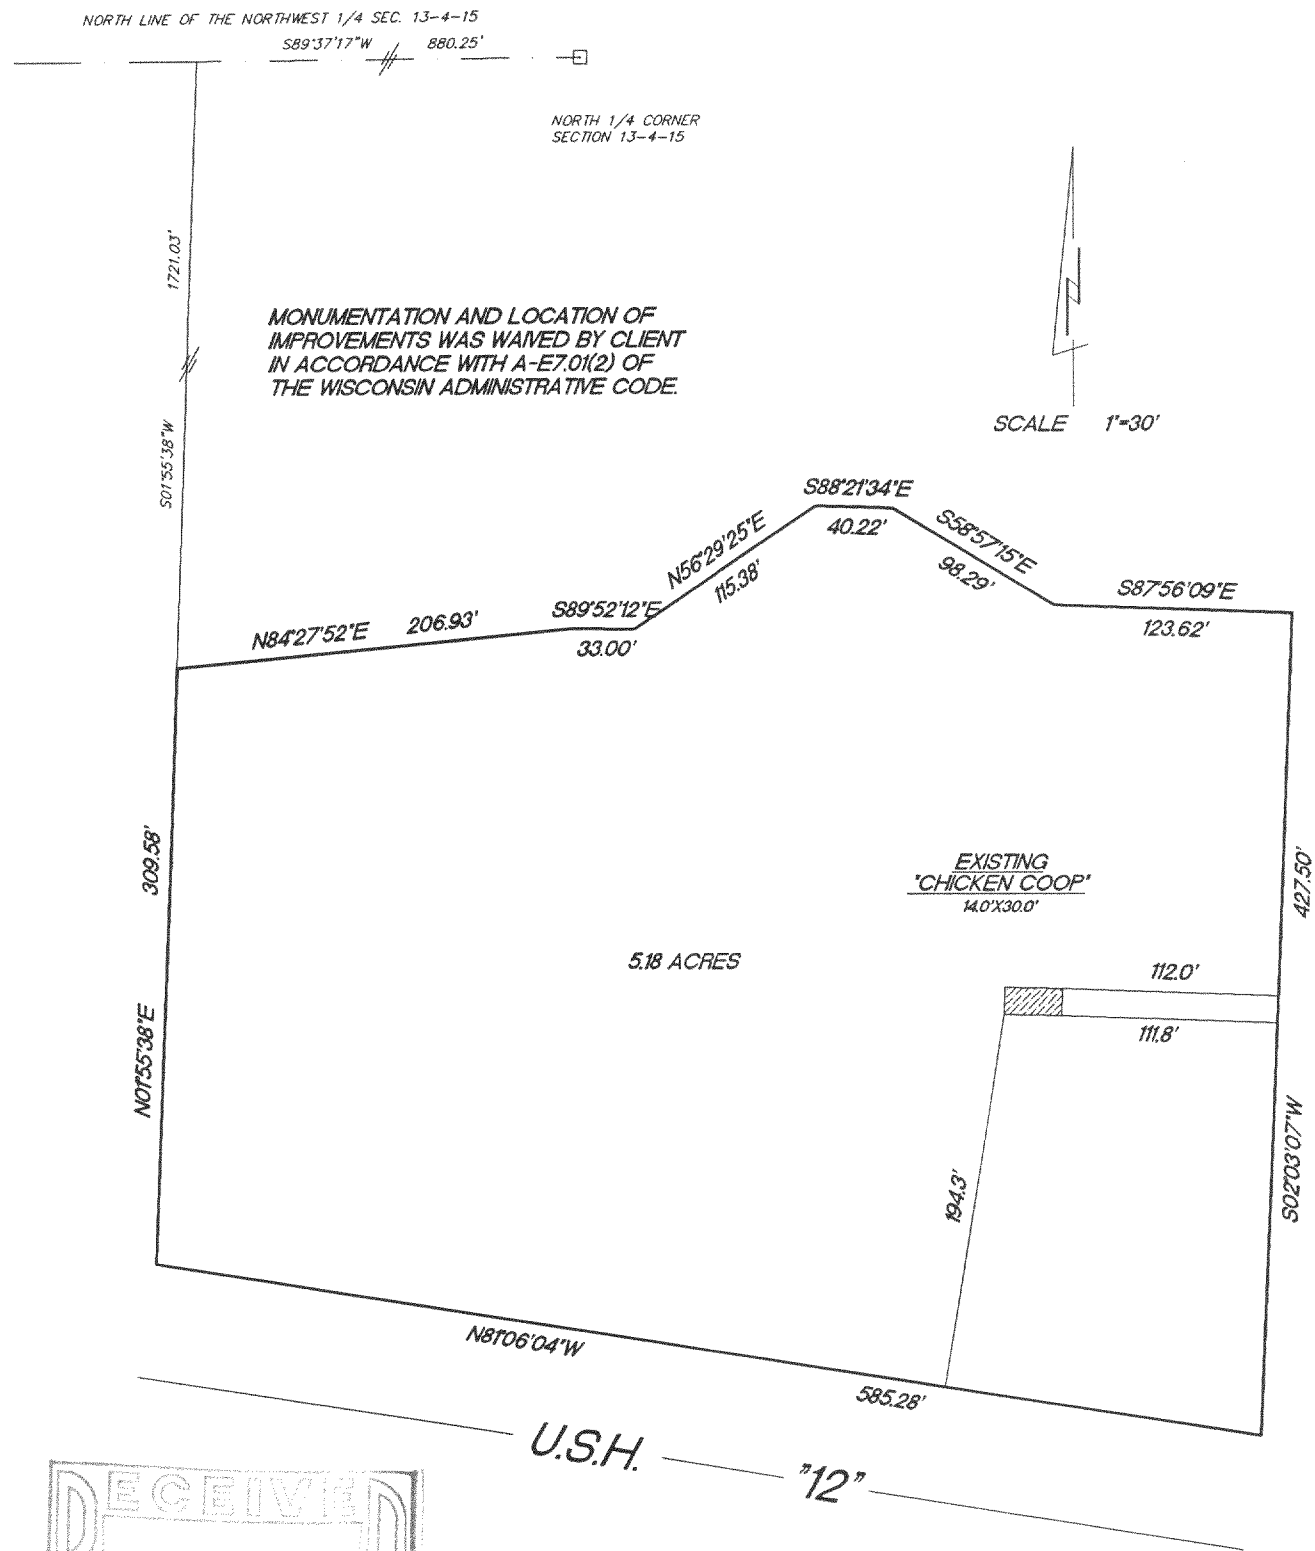

"I hereby certify that I have surveyed the above described property and that the above map is a true representation thereof and shows the size and location of the property, its exterior boundaries, the location of all visible structures and dimension of all principal buildings thereon, boundary fences, apparent easements, roadways and encroachments if any."

"This survey is made for the use of the present owners of the property, and also those who purchase, mortgage or guarantee the title thereto within one year from date hereof."

KETTLE MORaine SURVEYING INC.
W356 S9050 Godfrey Lane
Eagle Wisconsin 53119
P.O. Box 357
(262) 594-3484
Terrance E. Pisarek R.L.S.

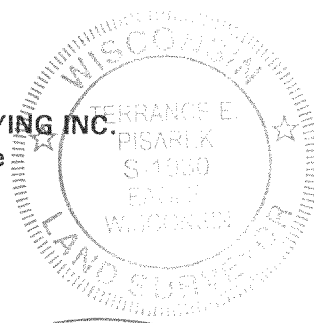

THIS IS NOT AN ORIGINAL SURVEY UNLESS THE SEAL IS RED.

7/19/05
DATE

TEP
FIELD WORK BY

TEP
DRAWN BY

05112
JOB NUMBER

DA255600001

415 -1047