


PLAT OF SURVEY
LOT 1 OF TWIN PONDS SUBDIVISION

LOCATED IN THE SOUTHEAST 1/4 OF SECTION 35, TOWN 4 NORTH, RANGE 15 EAST,
TOWN OF WHITEWATER, WALWORTH COUNTY, WISCONSIN

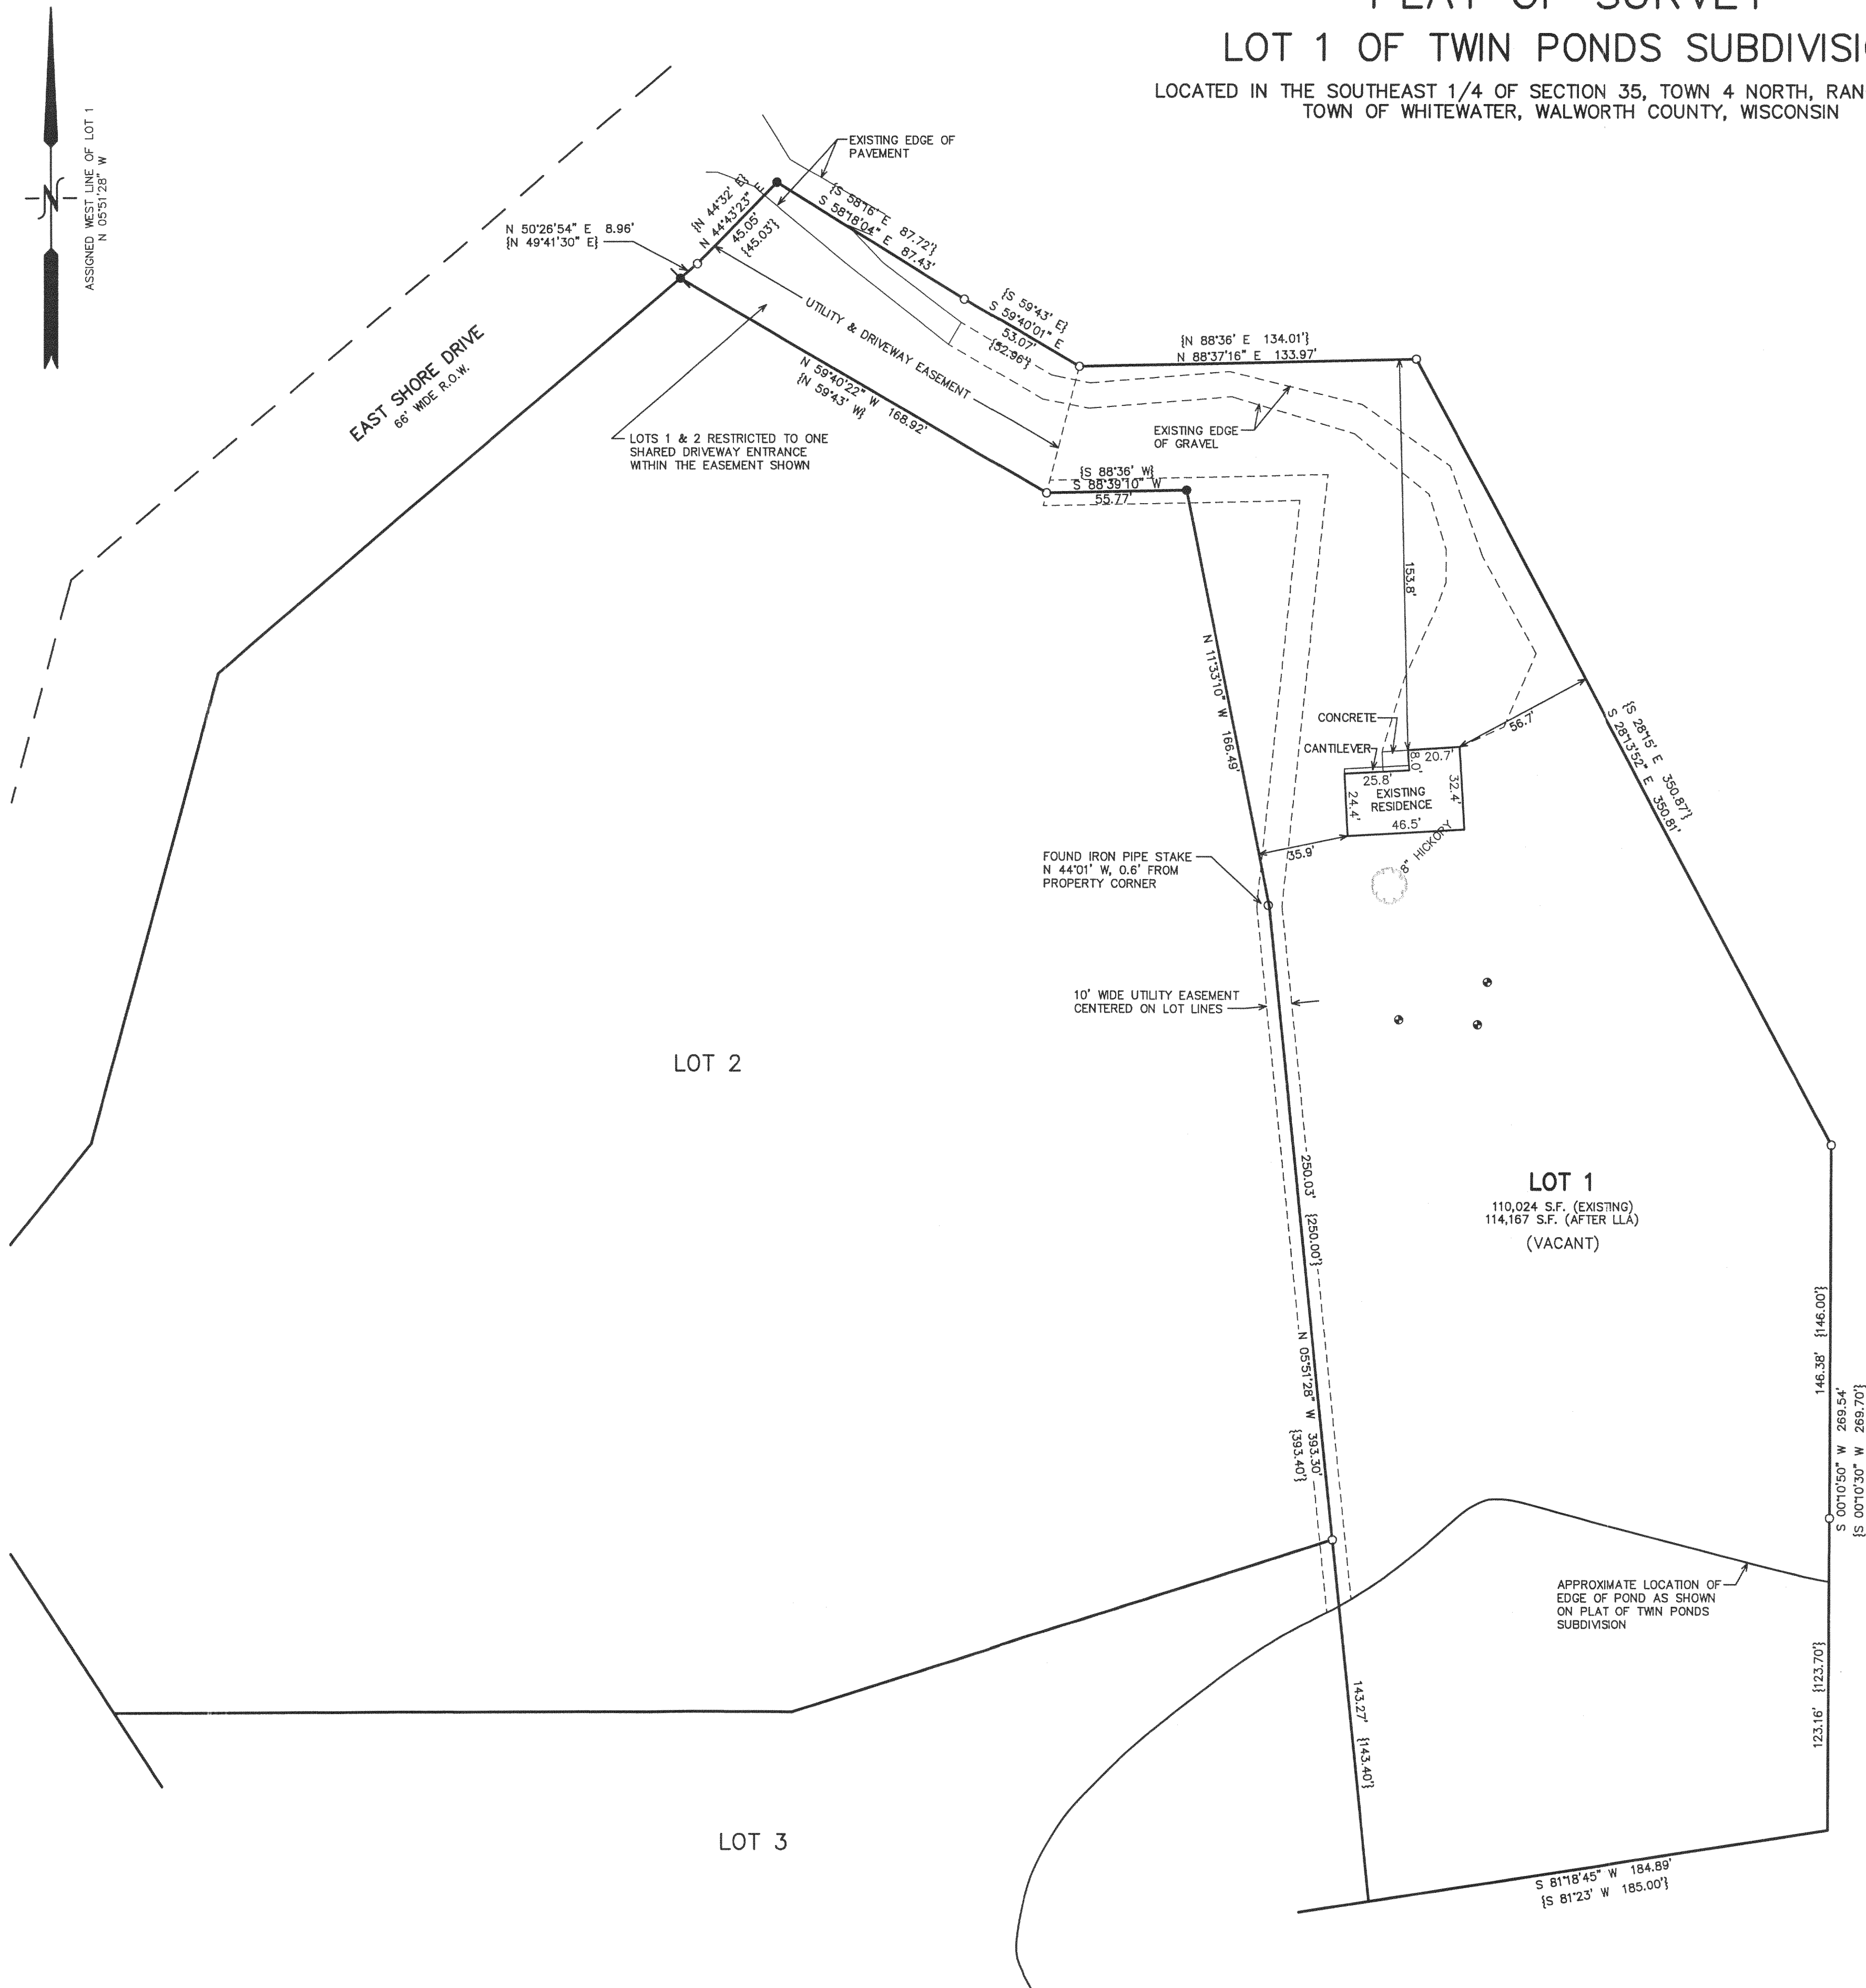

- LEGEND
- = FOUND IRON PIPE STAKE
 - = FOUND IRON REBAR STAKE
 - ⦿ = SET IRON REBAR STAKE, 3/4" DIA.
 - ⊙ = SOIL TEST BORING LOCATED
 - {XXX} = RECORDED AS

NOTE: WISCONSIN GAS AND ELECTRIC COMPANY EASEMENTS RECORDED
IN VOL. 250 OF DEEDS ON PG. 324, IN VOL. 253 OF DEEDS ON PG. 56,
AND IN VOL. 255 OF DEEDS ON PG. 42 GIVES THE RIGHT TO CONSTRUCT
AND MAINTAIN POWER POLES AND OVERHEAD WRES BY DOES NOT
PROVIDE A SPECIFIC LOCATION.

NOTE: COPIES OF THIS MAP TO WHICH THE FOLLOWING CERTIFICATE WILL APPLY SHOW
THE SURVEYOR'S ORIGINAL SEAL AND SIGNATURE IN RED INK. COPIES BY ANY OTHER
MEANS MAY HAVE ALTERATIONS WHICH DO NOT REPRESENT THE SURVEYOR'S WORK
PRODUCT.

I HEREBY CERTIFY THAT THE ABOVE DESCRIBED PROPERTY HAS BEEN SURVEYED UNDER
MY DIRECTION AND THAT THE ABOVE MAP IS A TRUE REPRESENTATION THEREOF AND
SHOWS THE SIZE AND LOCATION OF THE PROPERTY, ITS EXTERIOR BOUNDARIES, THE
LOCATION OF ALL VISIBLE STRUCTURES, AND DIMENSIONS OF ALL PRINCIPLE
BUILDINGS THEREON, BOUNDARY FENCES, APPARENT EASEMENTS, ROADWAYS, AND
VISIBLE ENCROACHMENTS, IF ANY. THIS SURVEY IS MADE FOR THE USE OF THE
PRESENT OWNERS OF THE PROPERTY, AND ALSO THOSE WHO PURCHASE, MORTGAGE, OR
GUARANTEE THE TITLE THEREO WITHIN ONE YEAR FROM THE DATE HEREOF.


REVISED 02-13-2002
TO SHOW SIZE & LOCATION OF
PROPOSED RESIDENCE

REVISED 04-23-2002
TO SHOW SIZE & LOCATION OF
FOUNDATION AS BUILT

REVISED 12-21-2005
UPDATE TO TITLE SPECS.

DATED: JANUARY 2, 2002

Peter S. Gordon
PETER S. GORDON

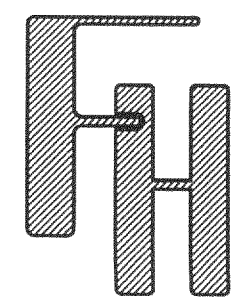

PLAT OF SURVEY
LOT 1
TWIN PONDS SUBDIVISION
TOWN OF WHITEWATER
WALWORTH COUNTY, WISCONSIN

— WORK ORDERED BY —
KEVIN NETTESHEIM
WS638 MARINER HILLS COURT
ELKHORN, WI. 53121

FARRIS, HANSEN & ASSOCIATES, INC.
ENGINEERING — ARCHITECTURE — SURVEYING
7 RIDGWAY COURT P.O. BOX 437
ELKHORN, WISCONSIN 53121
OFFICE: (262) 723-2098 FAX: (262) 723-5686

REVISIONS

PROJECT NO.
5425

DATE
01/02/02

SHEET NO.
1 OF 1