
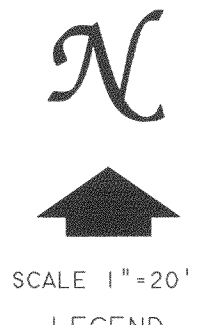


ABELL
SURVEYING & MAPPING

1140 SEDUOIA STREET • DELAVAN, WISCONSIN 53115
262-728-6737

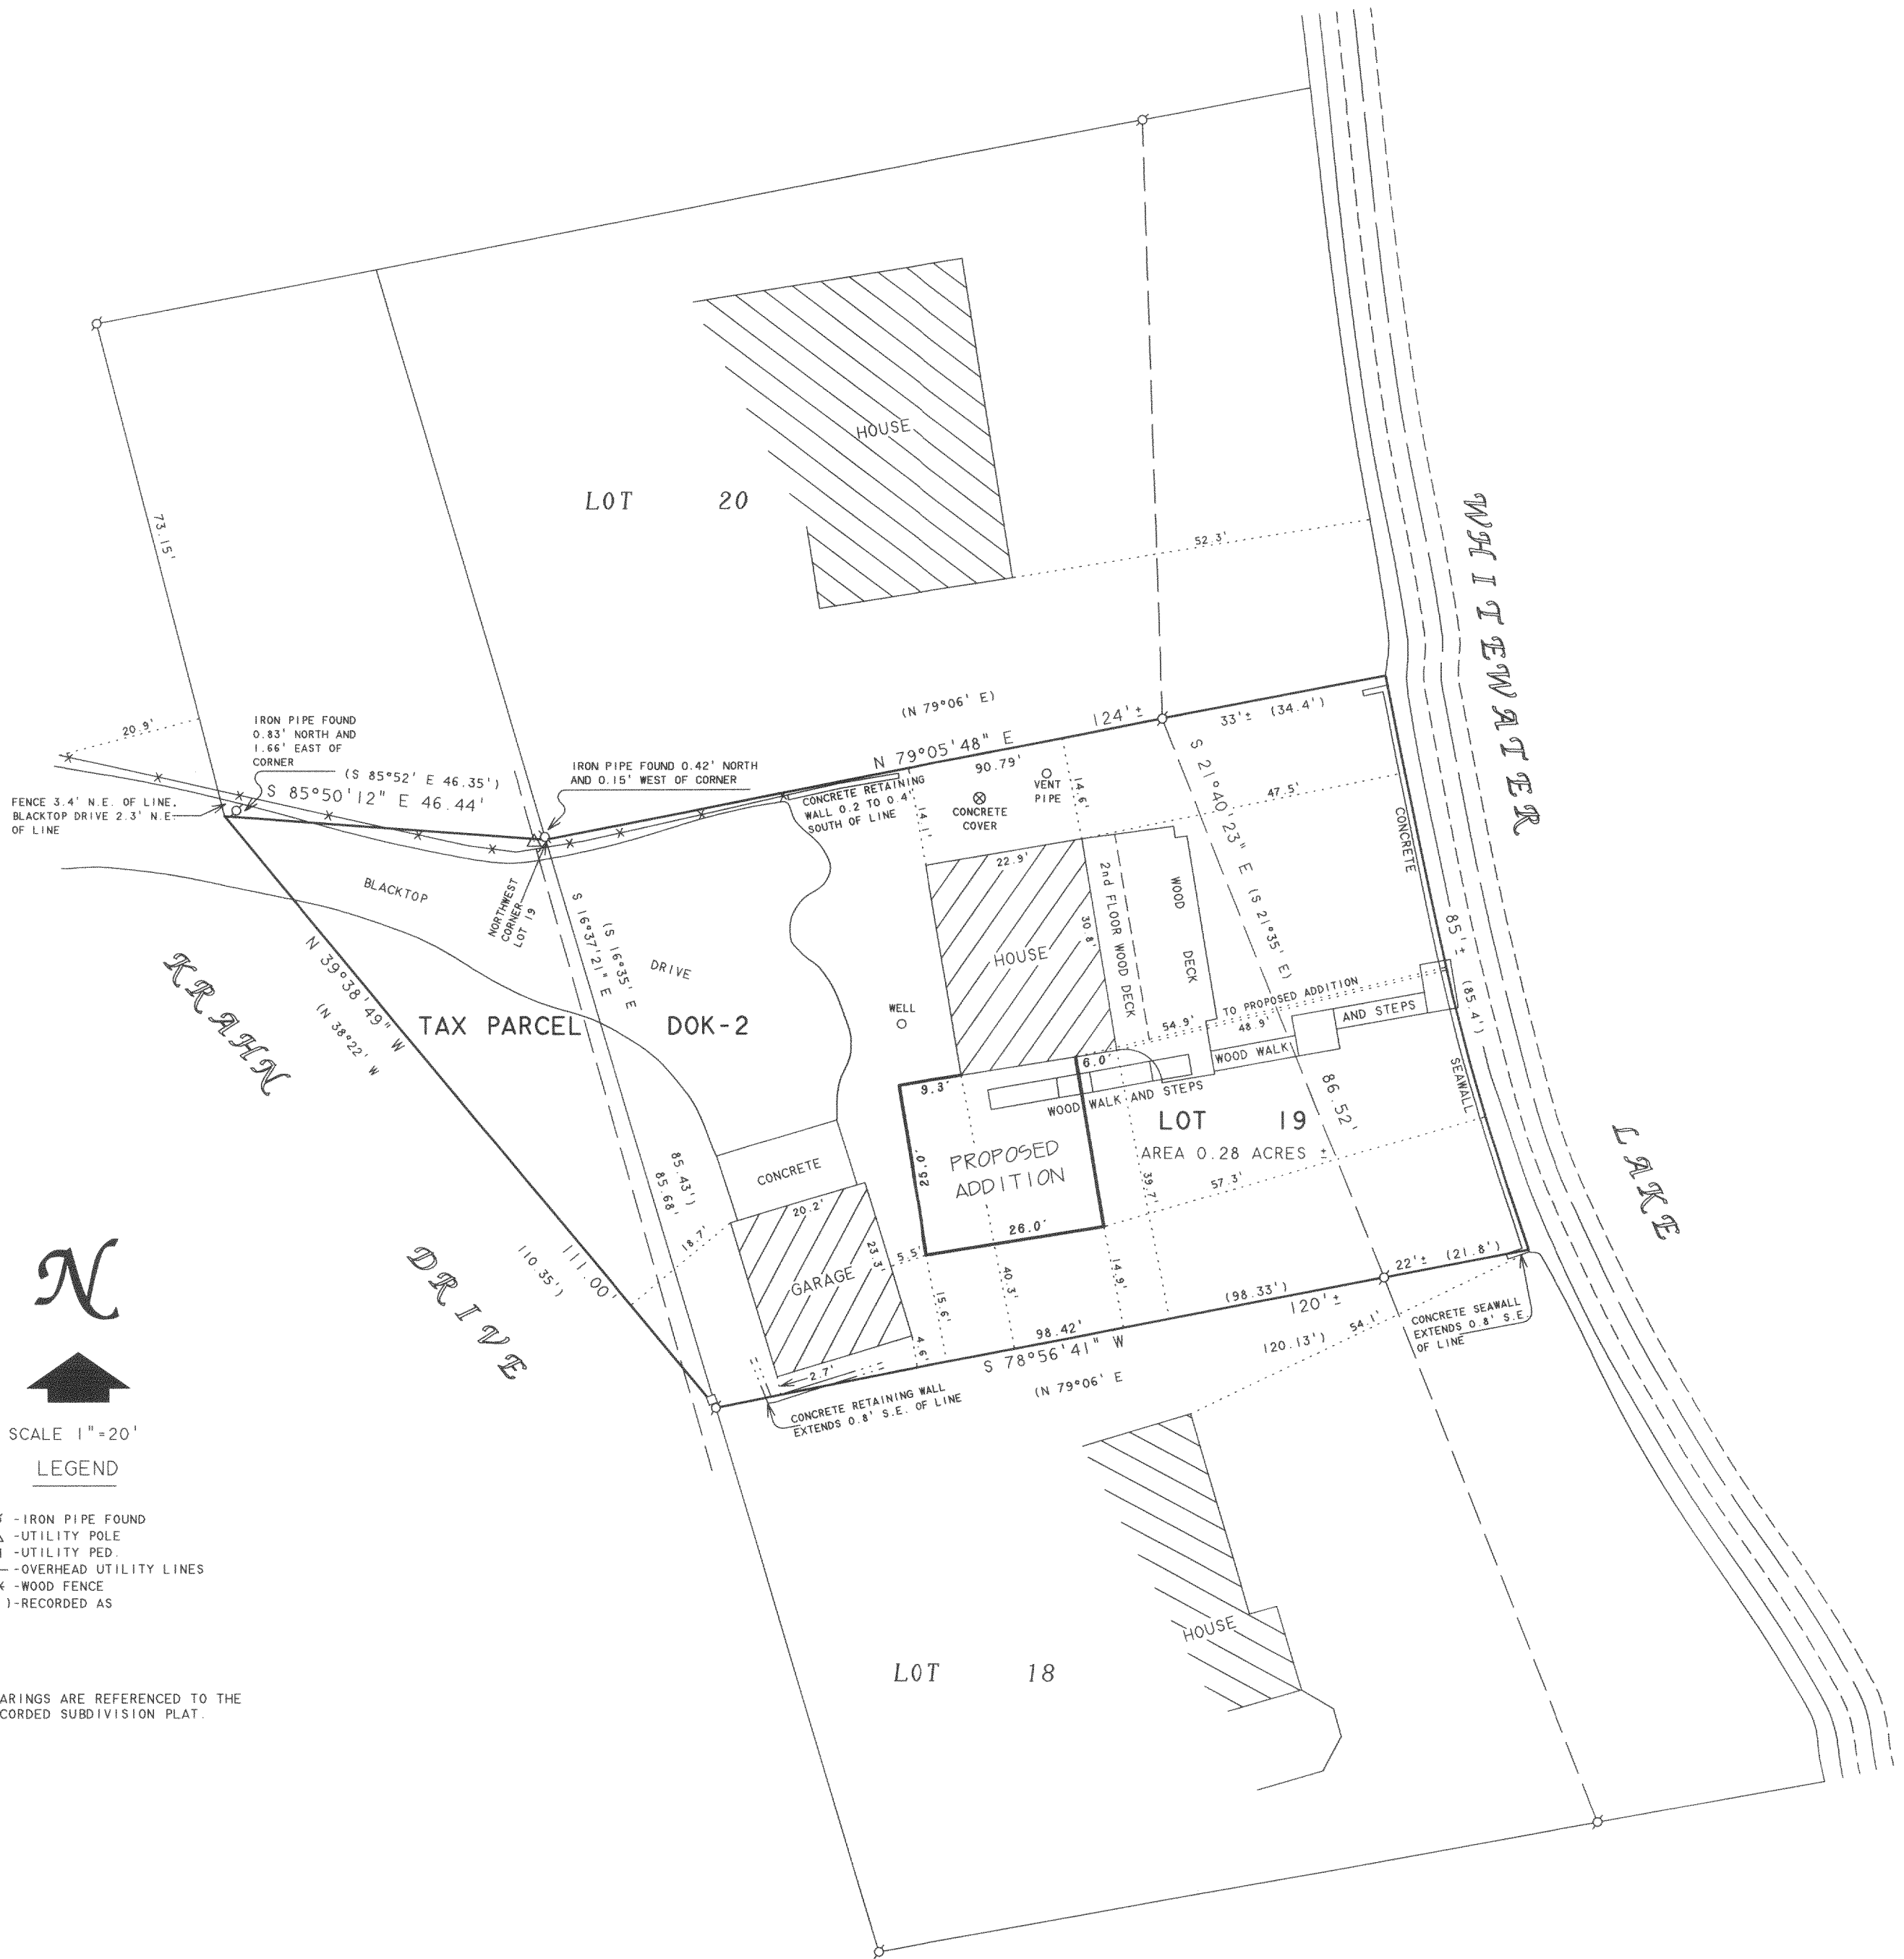

- LEGEND
- - IRON PIPE FOUND
 - △ - UTILITY POLE
 - - UTILITY PED.
 - - OVERHEAD UTILITY LINES
 - x— - WOOD FENCE
 - () - RECORDED AS

NOTE: BEARINGS ARE REFERENCED TO THE RECORDED SUBDIVISION PLAT.

PLAT OF SURVEY OF

LOT 19 OF OAK KNOLL SUBDIVISION, LOCATED IN T4N, R15E, WALWORTH COUNTY, WISCONSIN, AND ALSO A PARCEL OF LAND LOCATED ADJACENT TO AND WEST OF SAID LOT 19 AS DESCRIBED IN QUIT-CLAIM DEED RECORDED IN VOLUME 664 OF DEEDS ON PAGE 614 AS DOCUMENT NUMBER 604322 ON JULY 16, 1968 AND DESCRIBED AS FOLLOWS: COMMENCING AT THE NORTHWEST CORNER OF LOT 23: THENCE S 28°14' E 161.49 FEET; THENCE S 16°35' E 170.86 FEET TO THE NORTHWEST CORNER OF LOT 19 AND THE PLACE OF BEGINNING; THENCE CONTINUE S 16°35' E 85.43 FEET; THENCE N 38°22' W 110.35 FEET; THENCE S 85°52' E 46.35 FEET TO THE PLACE OF BEGINNING.

I HEREBY CERTIFY THAT I HAVE SURVEYED THE ABOVE DESCRIBED PROPERTY AND THAT THE ABOVE MAP IS A TRUE REPRESENTATION THEREOF AND SHOWS THE SIZE AND LOCATION OF THE PROPERTY, ITS EXTERIOR BOUNDARIES, THE LOCATION OF ALL VISIBLE STRUCTURES AND DIMENSIONS OF ALL PRINCIPAL BUILDINGS THEREON, BOUNDARY FENCES, APPARENT EASEMENTS, ROADWAYS AND VISIBLE ENCROACHMENTS, IF ANY, TO THE BEST OF MY KNOWLEDGE AND BELIEF.

THIS SURVEY IS MADE FOR THE USE OF THE PRESENT OWNERS OF THE PROPERTY, AND ALSO THOSE WHO PURCHASE, MORTGAGE, OR GUARANTEE THE TITLE THERETO WITHIN ONE (1) YEAR FROM DATE HEREON.

David F. Abell
DAVID F. ABELL
WISCONSIN REGISTERED LAND SURVEYOR, S-1596

January 17, 2006
DATE: _____ JOB NUMBER - 98074B
NOTE: THIS IS NOT A CERTIFIED COPY UNLESS SEALED.

ORDERED BY: ROBERT KUCHAN
551 SUNNYSIDE
ELMHURST, IL 60126

DOK-2

415-1064