

ABELL SURVEYING & MAPPING

1140 SEQUOIA STREET • DELAVAN, WISCONSIN 53115
262-728-6737

NOTE: BEARINGS ARE REFERENCED TO THE
RECORDED SUBDIVISION PLAT.



N



SCALE 1" = 40'

LEGEND

- - IRON ROD FOUND
- - IRON BAR FOUND
- CS - CONCRETE STOOP
- * - WOOD FENCE
- ▲ - GAS PIPELINE SIGN
- - UTILITY PED.
- () - RECORDED AS

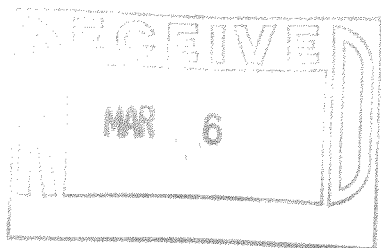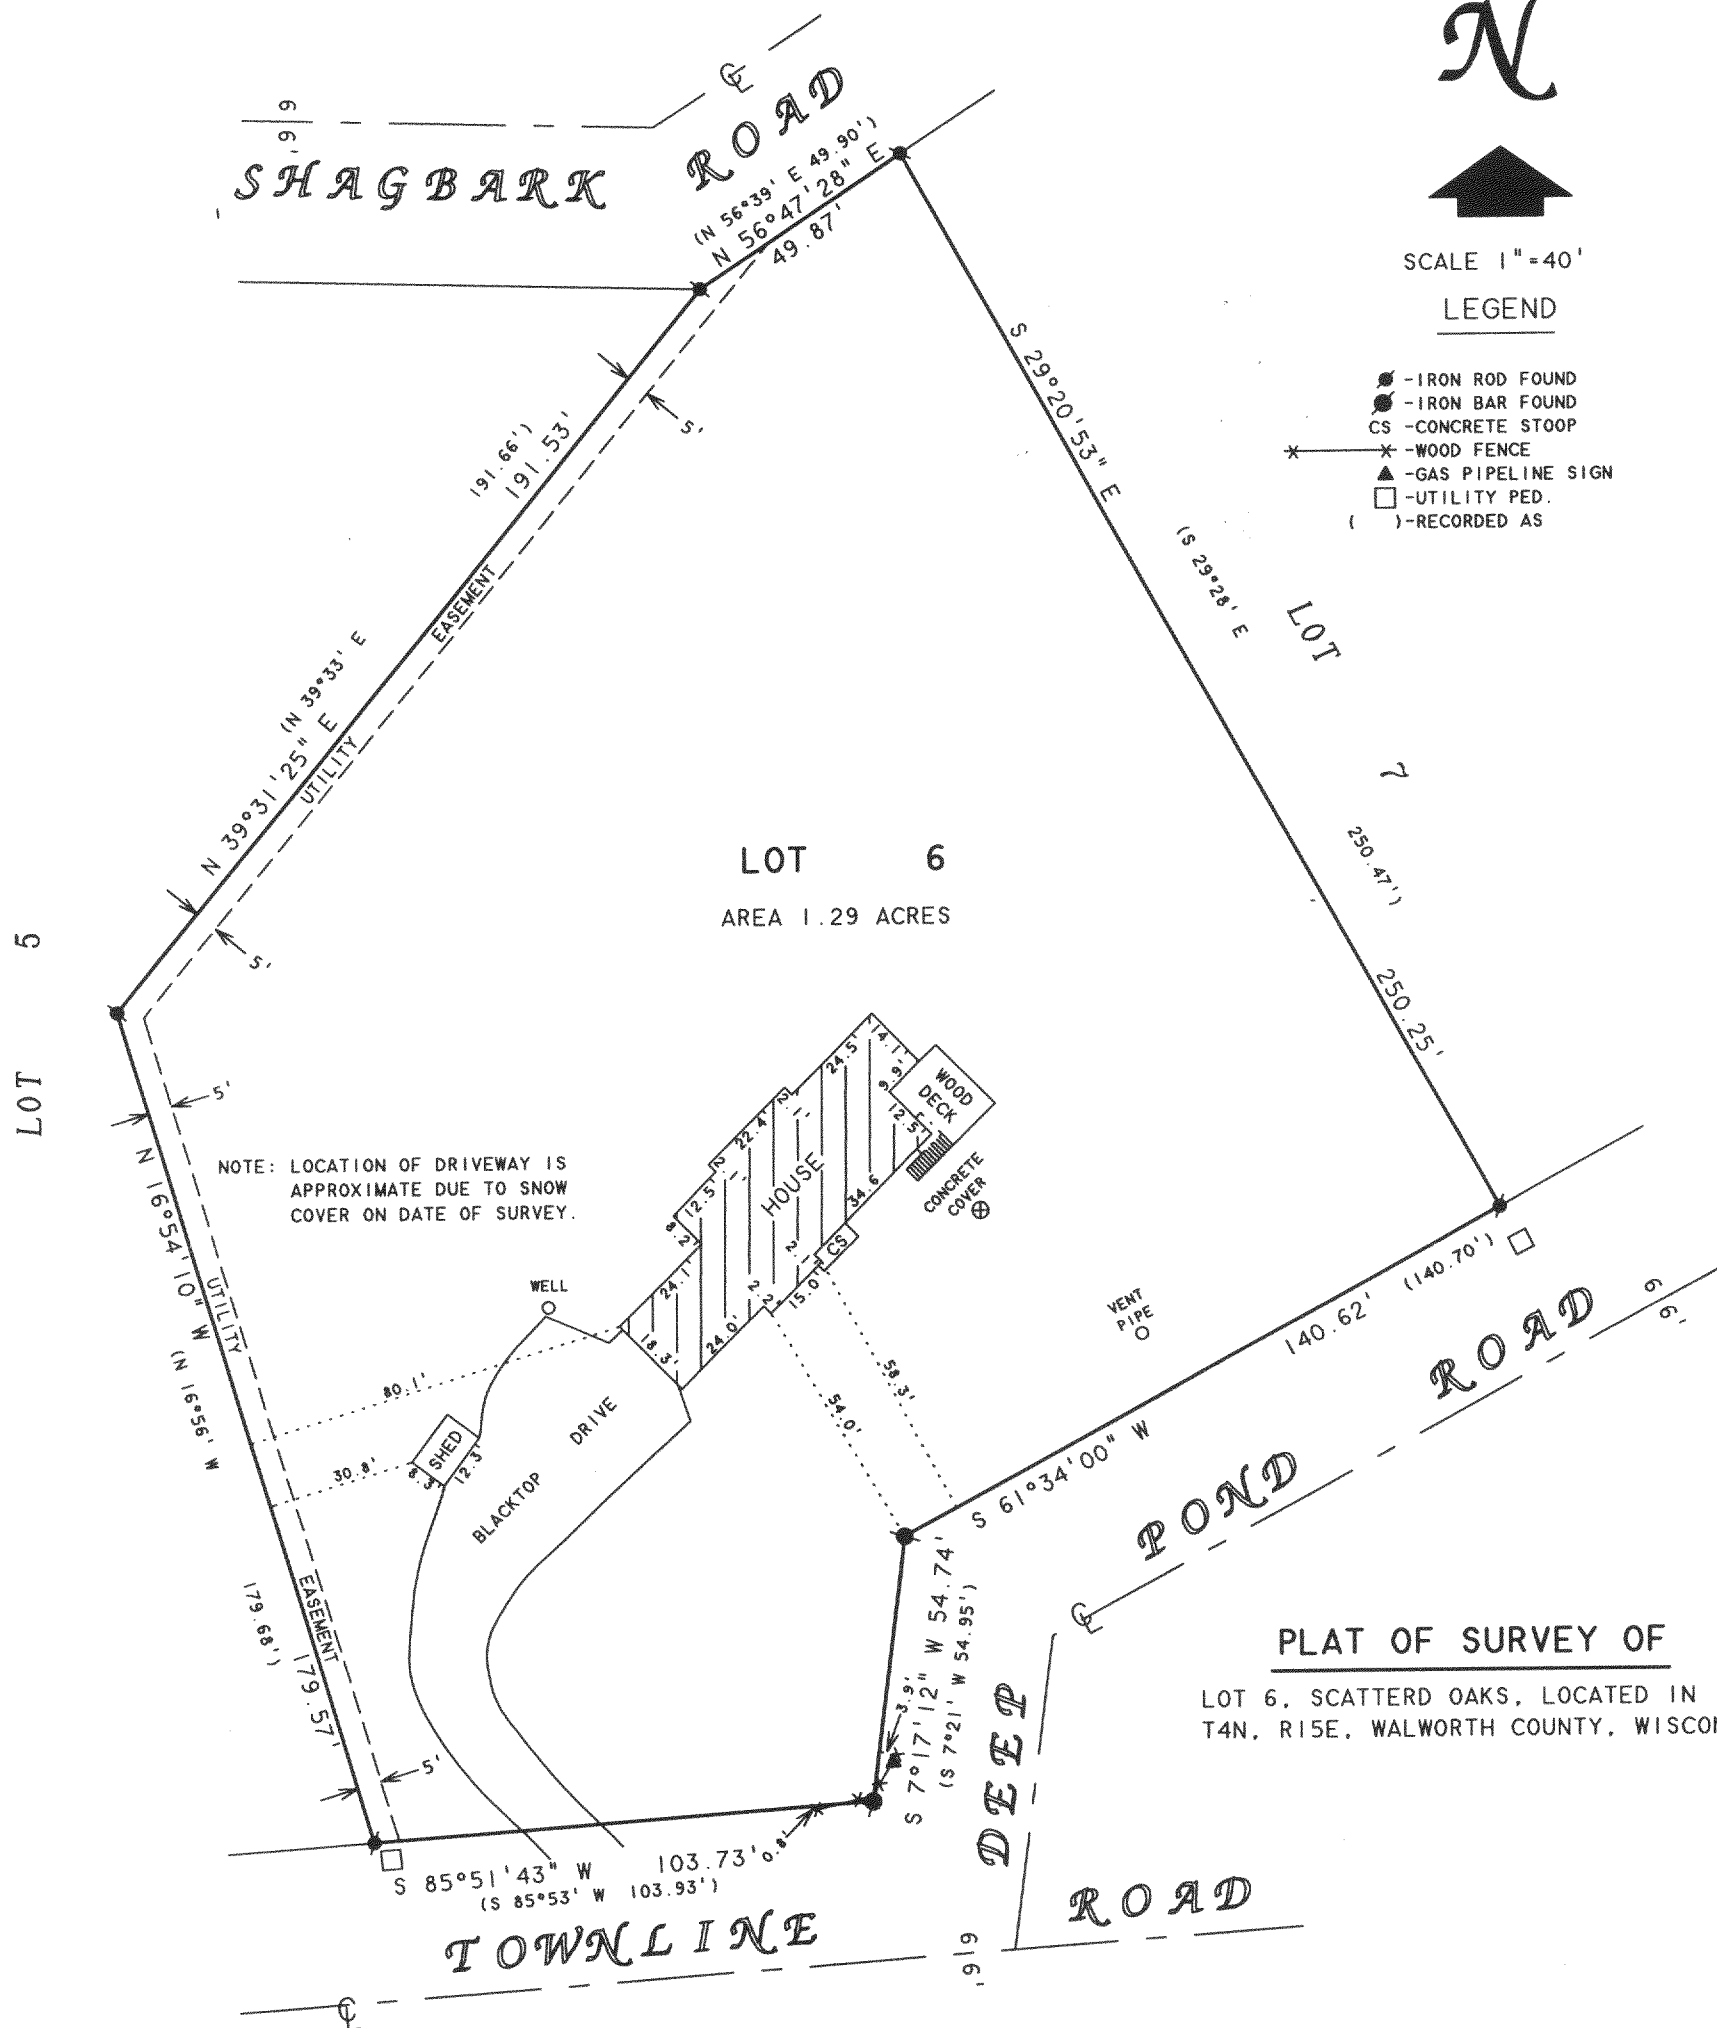

I HEREBY CERTIFY THAT I HAVE SURVEYED THE ABOVE DESCRIBED PROPERTY AND THAT THE ABOVE MAP IS A TRUE REPRESENTATION THEREOF AND SHOWS THE SIZE AND LOCATION OF THE PROPERTY, ITS EXTERIOR BOUNDARIES, THE LOCATION OF ALL VISIBLE STRUCTURES AND DIMENSIONS OF ALL PRINCIPAL BUILDINGS THEREON, BOUNDARY FENCES, APPARENT EASEMENTS, ROADWAYS AND VISIBLE ENCROACHMENTS, IF ANY, TO THE BEST OF MY KNOWLEDGE AND BELIEF.

THIS SURVEY IS MADE FOR THE USE OF THE PRESENT OWNERS OF THE PROPERTY, AND ALSO THOSE WHO PURCHASE, MORTGAGE, OR GUARANTEE THE TITLE THERETO WITHIN ONE (1) YEAR FROM DATE HEREON.

David F. Abell

DAVID F. ABELL
WISCONSIN REGISTERED LAND SURVEYOR, S-1596

ORDERED BY: HANK KINSON
RE/MAX - HEARTLAND REALTY

FOR: MIKE CAMPBELL
W7782 R & W TOWNLINE ROAD
WHITEWATER, WI 53190

December 13, 2005

DATE JOB NUMBER - 05149
NOTE: THIS IS NOT A CERTIFIED COPY UNLESS SEALED.

D50-6

415-1067