

# LAND-MARK SURVEYING

Mark L. Miritz

Wisconsin Registered Land Surveyor S-2582

N9330 Knuteson Drive  
Whitewater, WI 53190  
Phone: (262) 495-3284  
FAX : (262) 495-8421  
LAND-MARKSURVEYING.COM



OWNER: JAMES ALLER

SITE ADDRESS: N7833 EAST LAKESHORE

## PLAT OF SURVEY

LOT 7, BLOCK 2 OF GUTZMER'S SUBDIVISION  
LOCATED IN THE NW 1/4 & THE SW 1/4 SECTION  
25, TOWN 4 NORTH, RANGE 15 EAST, WHITEWATER  
TOWNSHIP, WALWORTH COUNTY, WISCONSIN.


ORDERED BY:  
TOM DUVAL  
DUVAL CONSTRUCTION  
W7793 HACKETT ROAD  
WHITEWATER, WI 53190

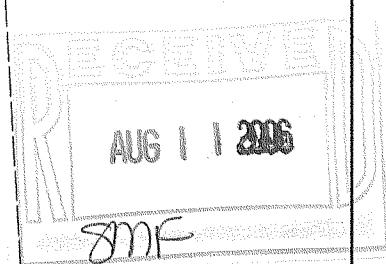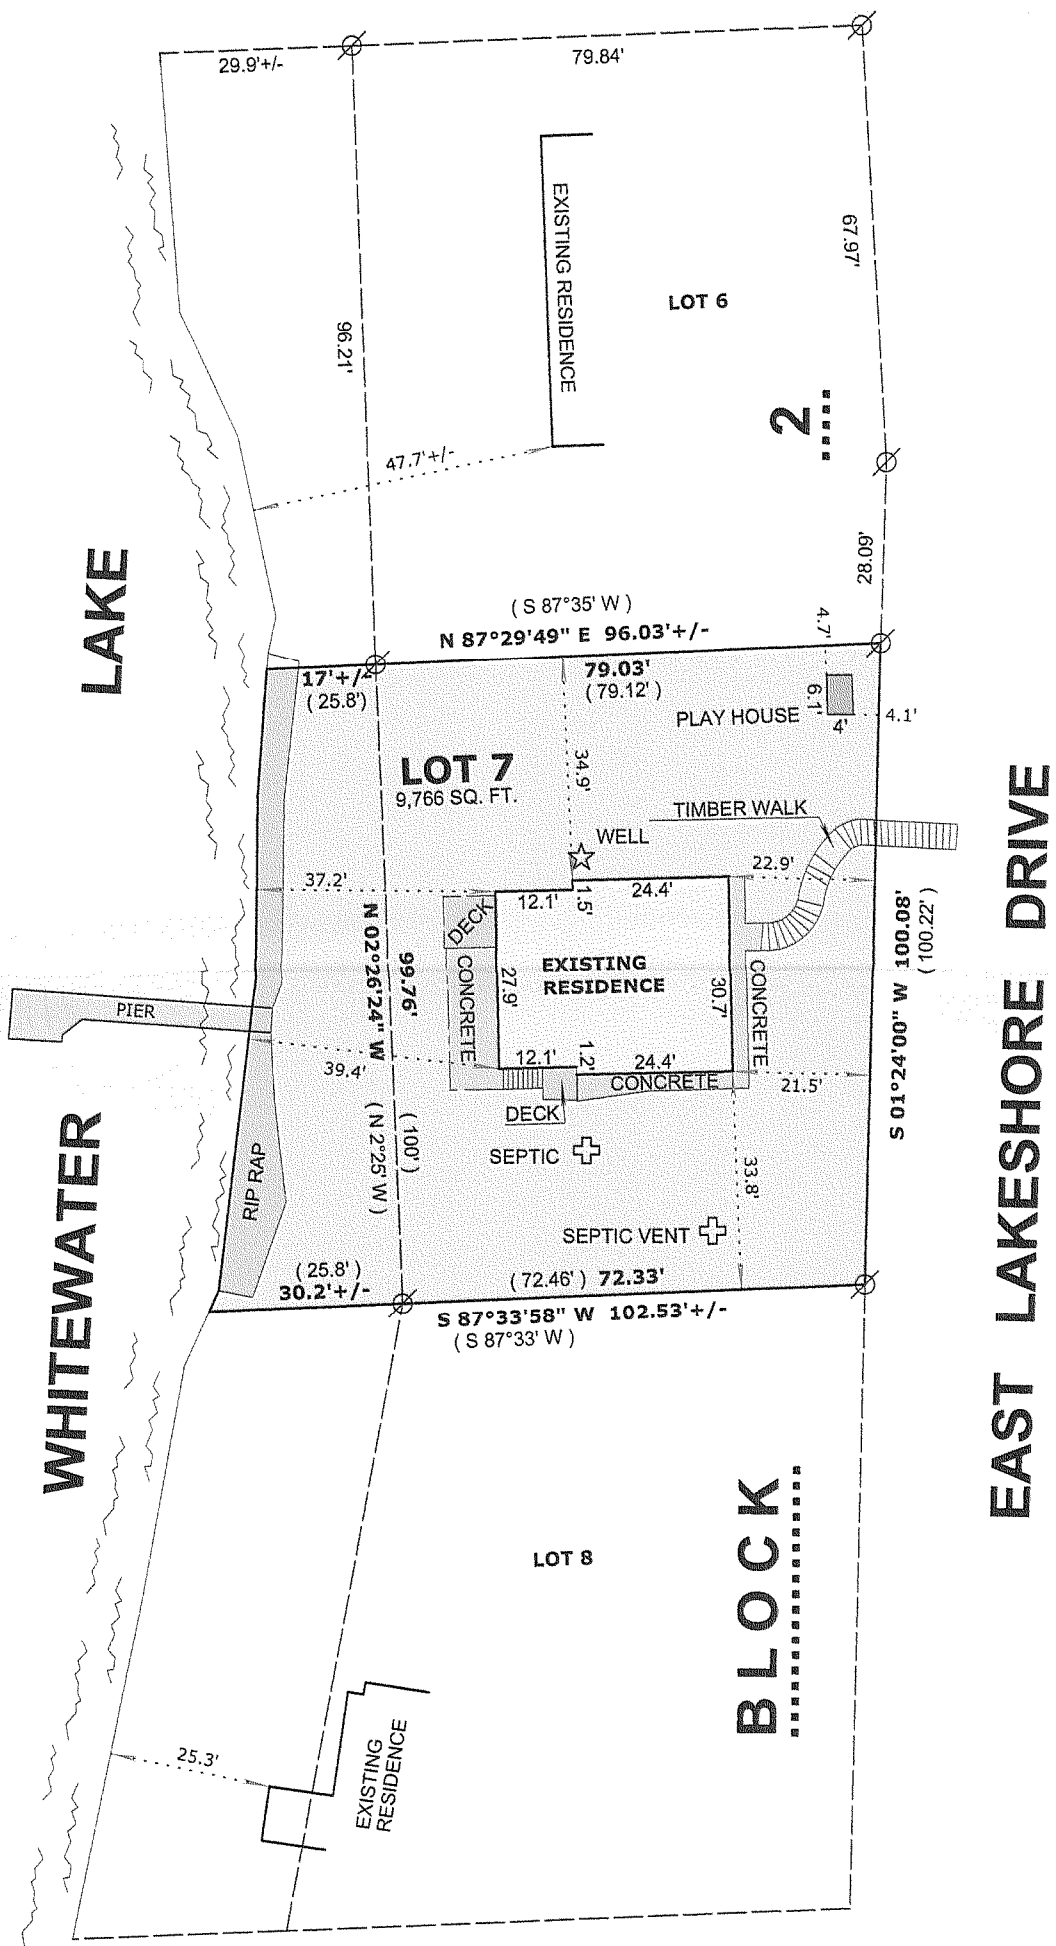

### AVERAGE SHOREYARD SETBACK


LOT 8 25.3'  
LOT 6 47.7'  
73.0' / 2

SHOREYARD 36.5'  
SETBACK

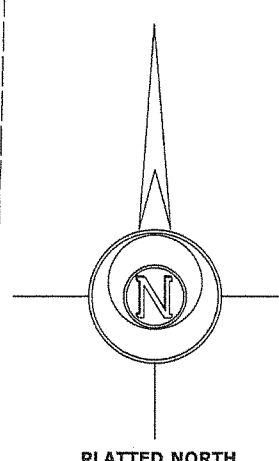

### LEGEND

- FOUND IRON PIPE
- FOUND IRON ROD
- FOUND COUNTY MONUMENT
- FOUND CONCRETE MONUMENT
- CHISEL CUT IN CONCRETE
- SET IRON ROD, 24" LONG, WEIGHING 1.5 LBS./LINEAL FT., 3/4" DIA.
- ( x x ) RECORDED AS DIMENSION
- EXISTING FENCE

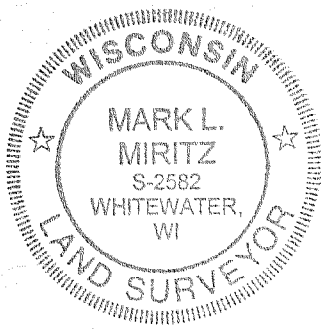

SCALE: 1" = 30 FEET

"I hereby certify that the above described property has been surveyed by me or under my direction and that the above map is a true representation thereof and shows the size and location of the property, its exterior boundaries, the location of all visible structures and dimensions of all principal buildings thereon, boundary fences, apparent easements, roadways and visible encroachments, if any."  
"This survey is made for the use of the present owners of the property, and also those who purchase, mortgage, or guarantee the title thereto within one year from date hereof."

MARK L. MIRITZ  
WISCONSIN REGISTERED  
LAND SURVEYOR S-2582

DATE: JUNE 8, 2006 JOB NO. 06.605

DGS-16

415-1083