

Plat of Survey

of

Lot 8 of Glacial Forest Subdivision,



located in the Northeast 1/4 of Section 33, Town 4 North, Range 15 East, Town of Whitewater, Walworth County, Wisconsin.

also

Lot 1 of Certified Survey Map No. 1016,


recorded in Vol. 4 of Certified Survey Maps of Walworth County on Page 294 and located in the Southeast 1/4 of Section 33, Town 4 North, Range 15 East, Town of Whitewater, Walworth County, Wisconsin.

Surveyed for: **Phyllis Batra**
N7545 Esker Court
Whitewater, Wisconsin. 53190

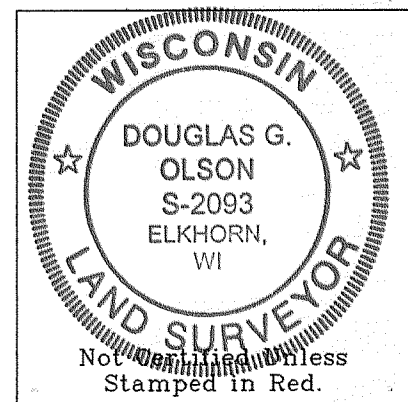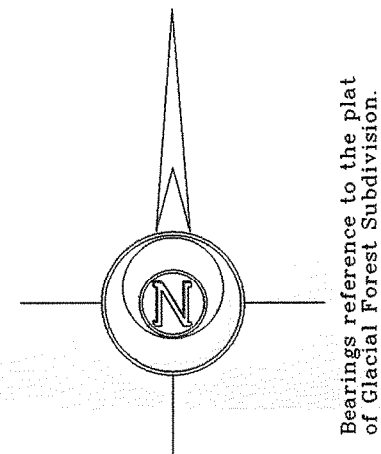

Notes: 1) This survey plat is not certified unless signed and sealed in red ink.

2) This survey is subject to Wisconsin lien laws. This Plat of Survey is the notice of intent to file lien. Lien waiver required.

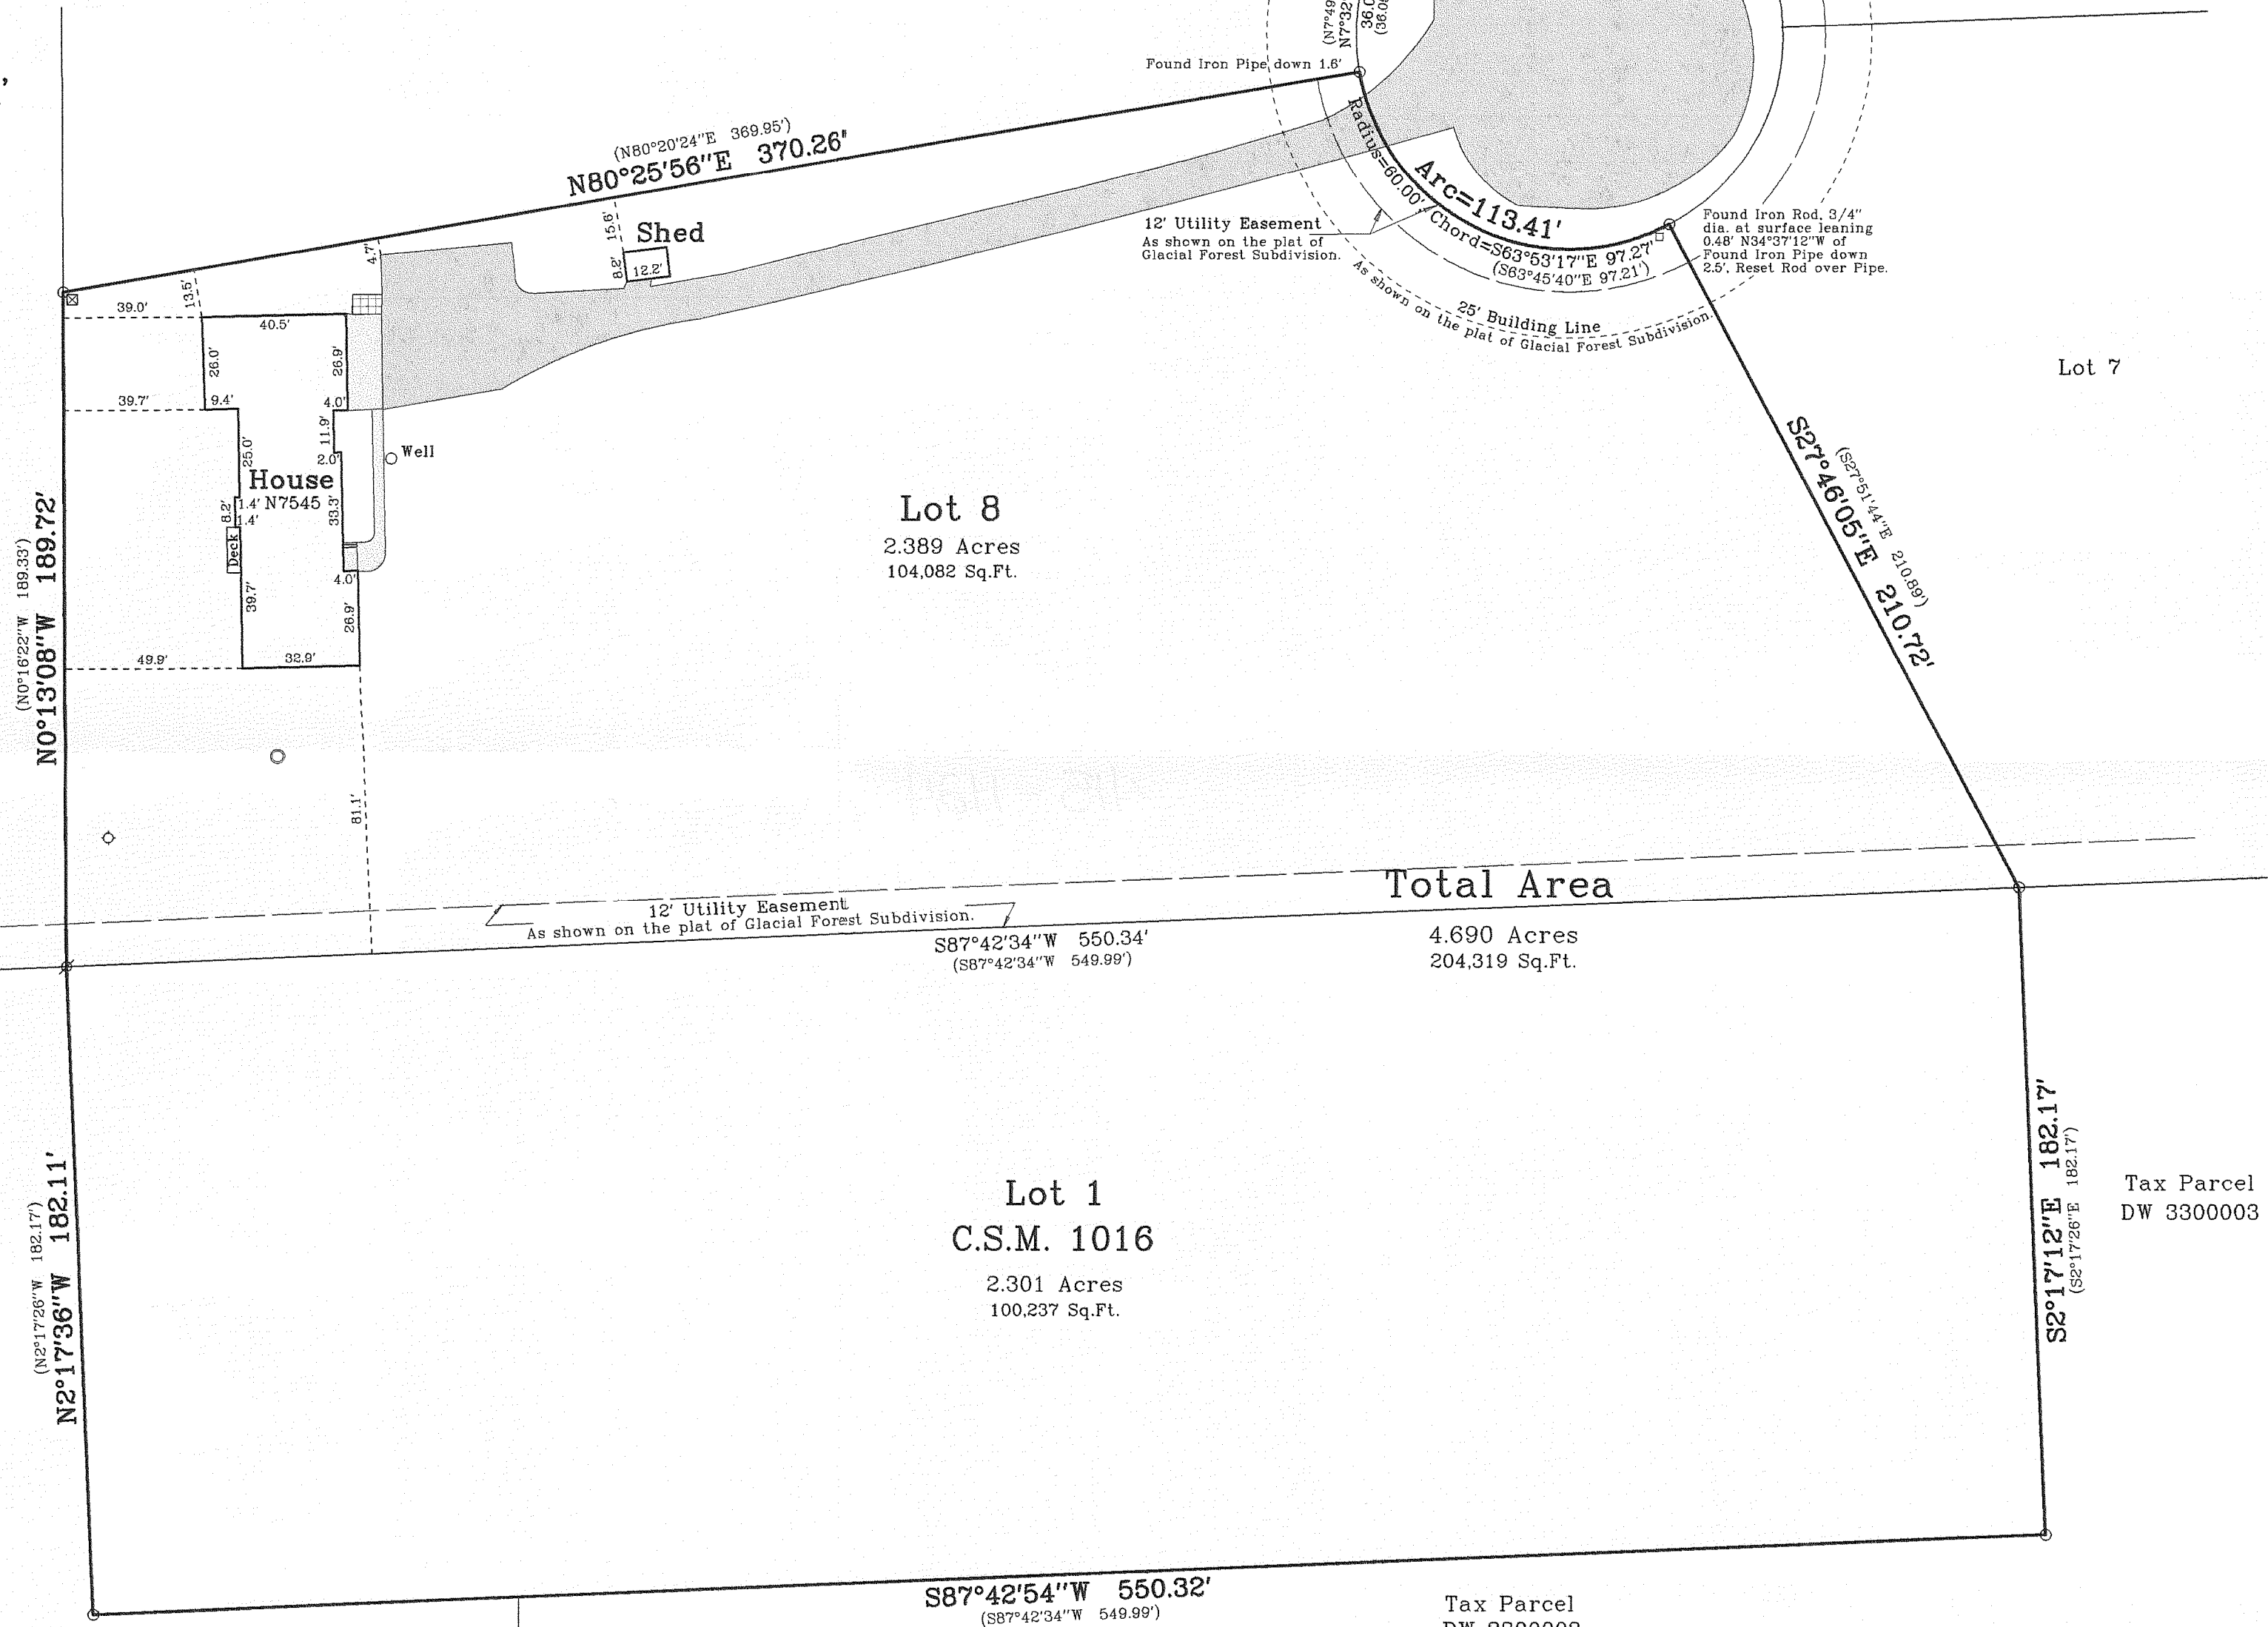

Tax Parcel
DW 3300008

Copyright © 2007 by Jensen & Olson Land Surveying, LLC.

All rights reserved. No part of this survey plat may be reproduced or transmitted in any form by any means - graphic, electronic, or mechanical, including photocopying, tracing, or information storage and retrieval systems - without permission in writing from Douglas G. Olson, Jensen & Olson Land Surveying, LLC.




Tax Parcel
DW 3300003

I hereby certify that I have surveyed the above described property and the map hereon is correct to the best of my professional knowledge and belief and shows the size and location of the property, its exterior boundaries, the location and dimensions of all visible structures thereon, boundary fences, apparent easements and roadways and visible encroachments, if any.
This survey is made for the exclusive use of the present owners of property, and also those who purchase, mortgage or guarantee title thereto, within one year from the date hereof.

Douglas G. Olson
Wisconsin Registered Land Surveyor - 2093

Survey Date: May 22, 2007.
Revisions:

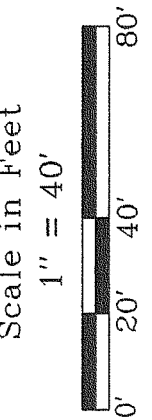

Jensen & Olson Land Surveying, LLC



45 South Wisconsin Street P.O. Box 322
Elkhorn, Wisconsin 53121
Telephone (262) 723-3434
Facsimile (262) 723-8044

Legend

Found Iron Pipe, 3/4" dia.
Recorded Information
Concrete Cover
Utility Box or Pedestal
Gas Warning Sign
Asphalt Surface
Concrete Surface
Brick

Sheet 1 of 1 Sheets

Job Reference Number
2007.052

2007.052

DG-8 ' DA 1016-1

415-1124 412-1151