

# Plat of Survey

of



Lots 2, 3, & 4 of Certified Survey Map No. 2207,

recorded in Vol. 10 of Certified Survey Maps of Walworth County on Page 312 and located in the Northwest 1/4 and the Southwest 1/4 of Section 25, Town 4 North, Range 15 East, Town of Whitewater, Walworth County, Wisconsin.


Surveyed for: **Mill Creek Log Homes**  
517 Commerce Court  
Bonduel, Wisconsin. 54107

## Detail of Foundation

1"=20'

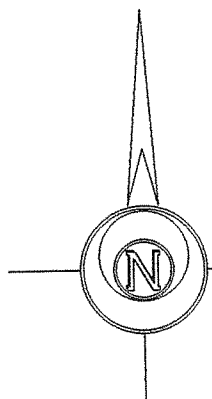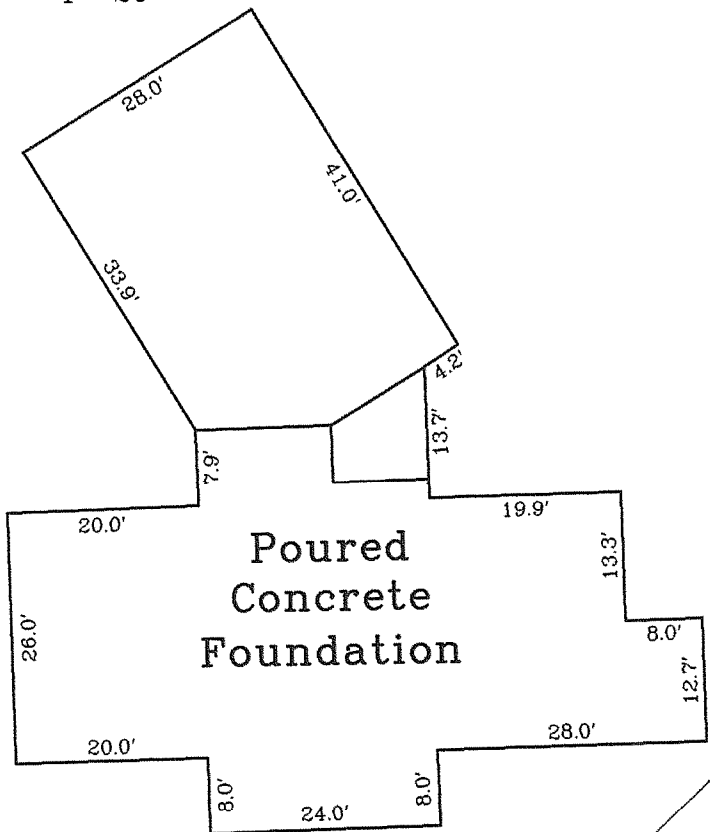

Bearings reference to Certified Survey Map No. 2207.

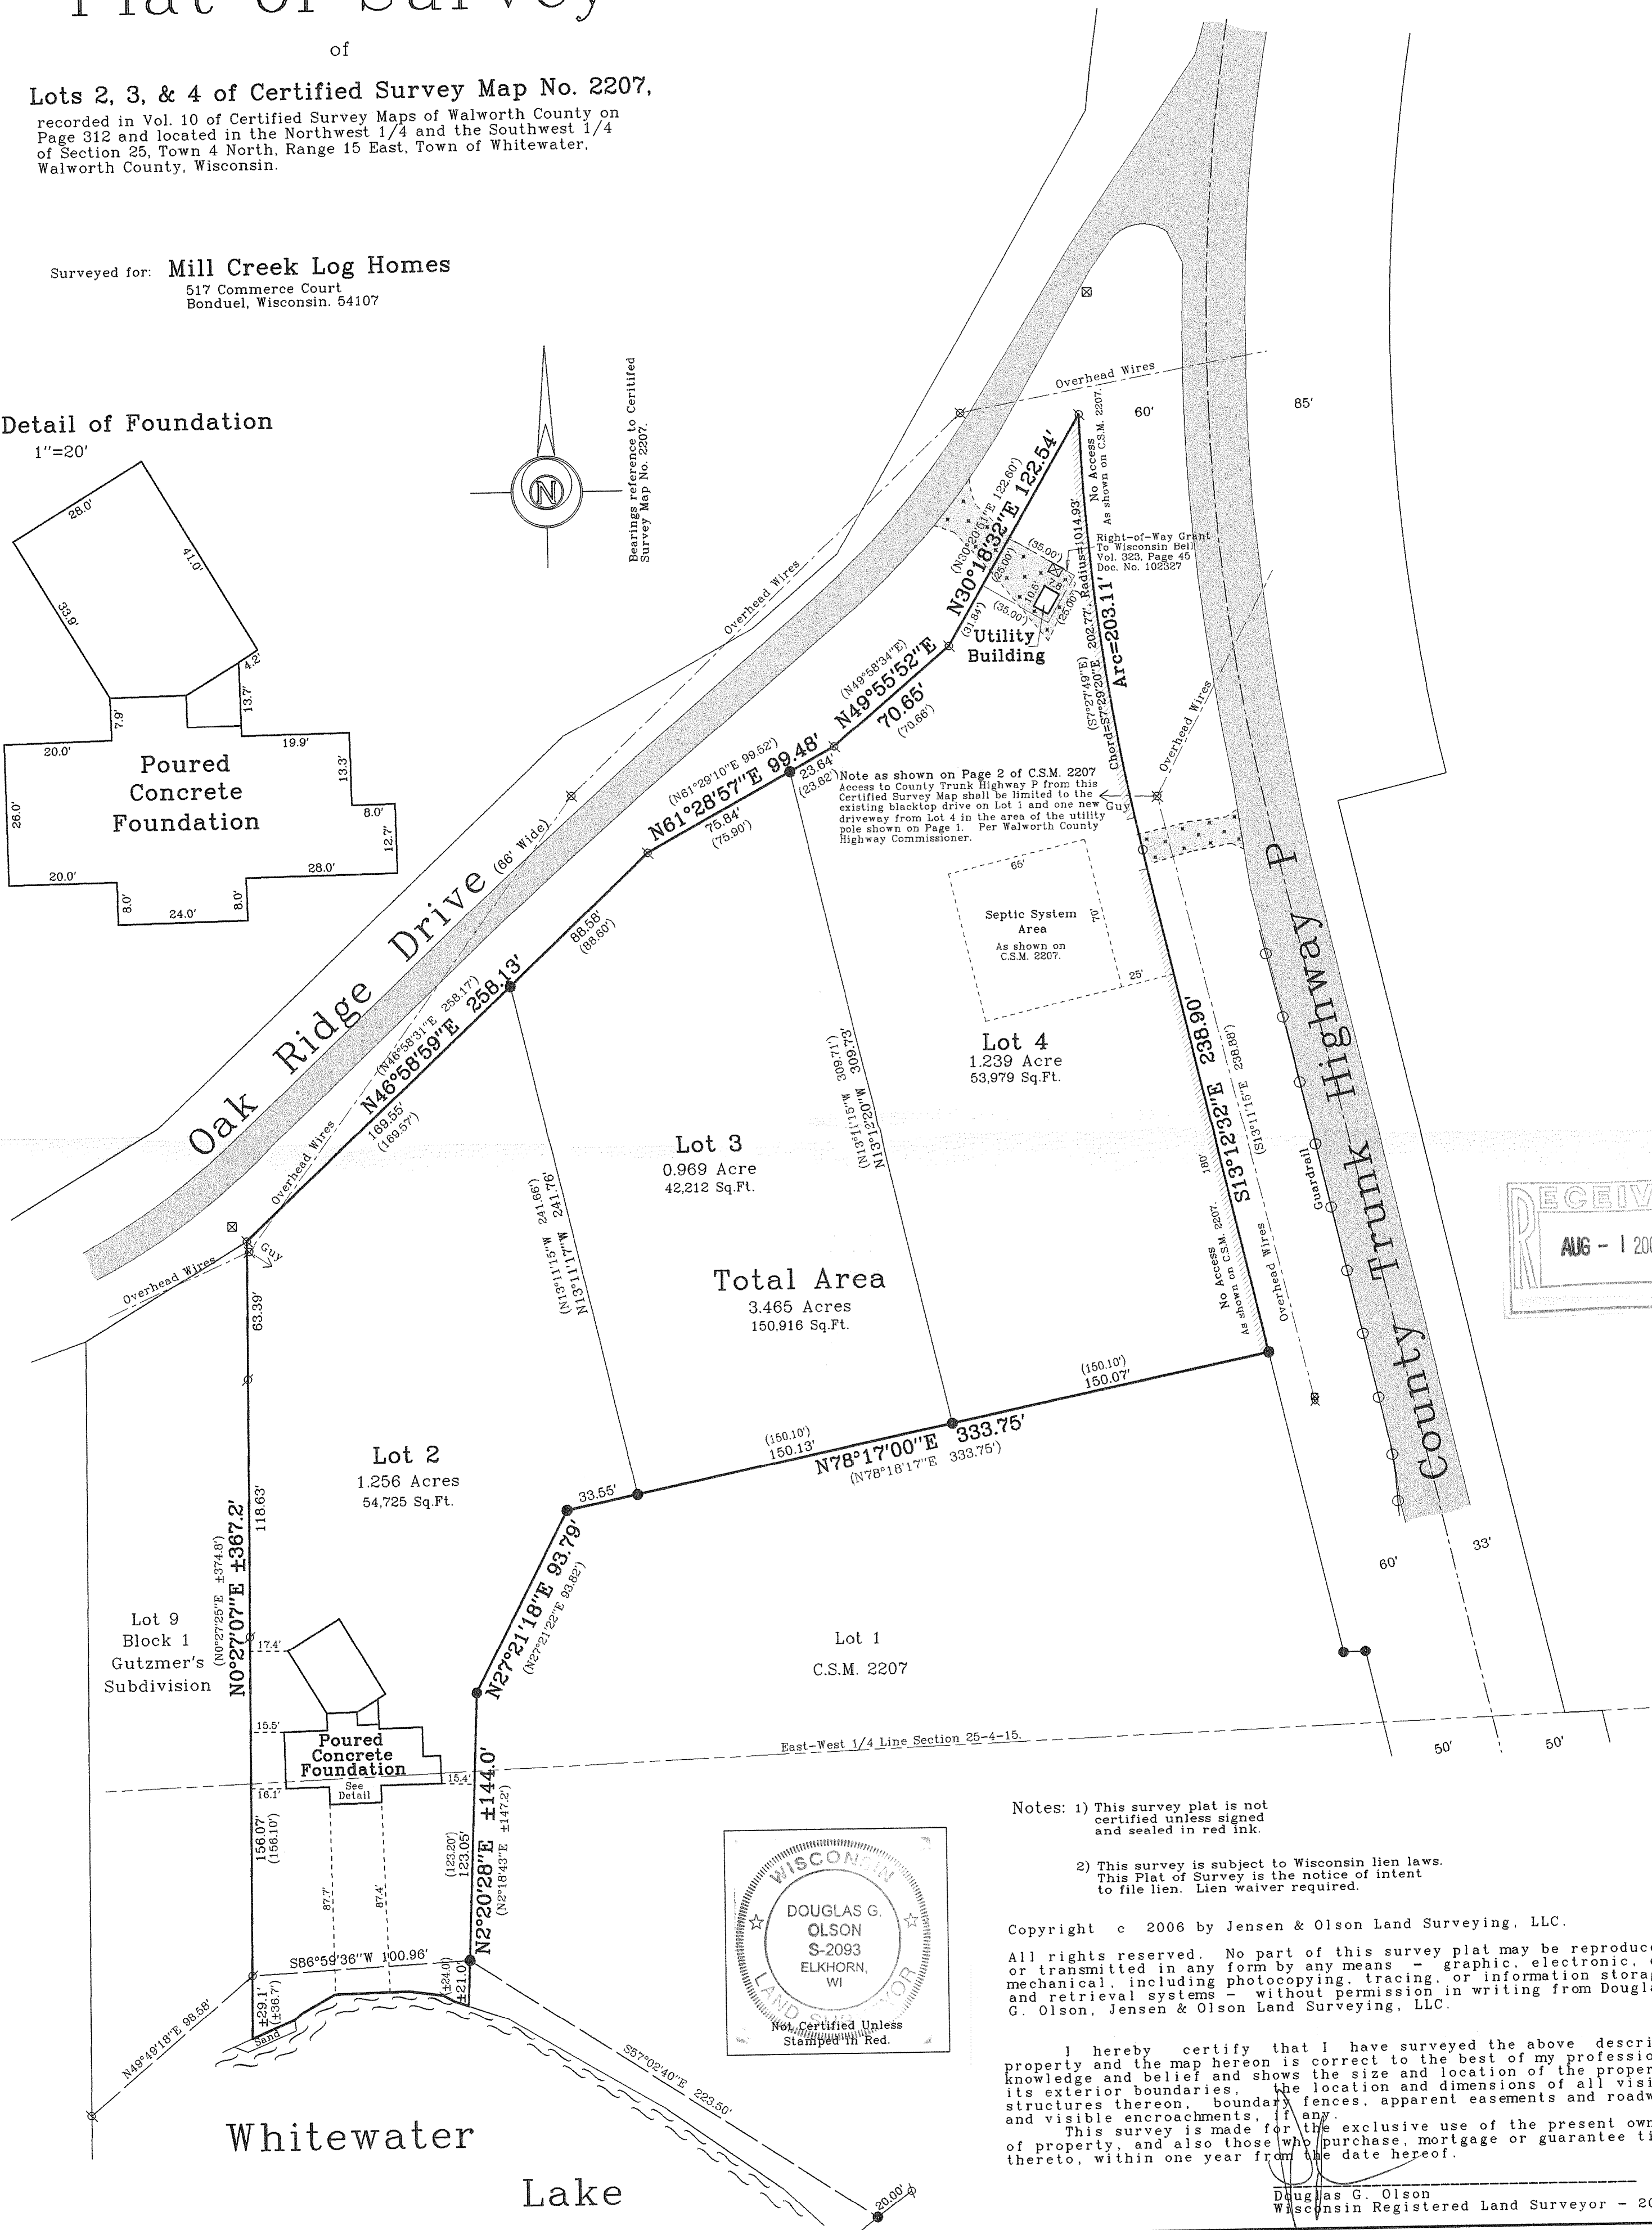

**Total Area**  
3.465 Acres  
150,916 Sq.Ft.

**Lot 2**  
1.256 Acres  
54,725 Sq.Ft.


**Lot 3**  
0.969 Acres  
42,212 Sq.Ft.

**Lot 4**  
1.239 Acres  
53,979 Sq.Ft.

**Lot 1**  
C.S.M. 2207

**Lot 9**  
Block 1  
Gutzmer's  
Subdivision

**Poured  
Concrete  
Foundation**

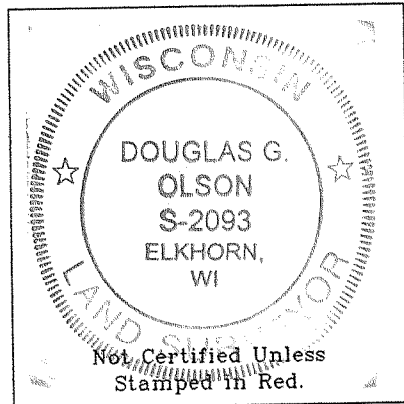

Notes: 1) This survey plat is not certified unless signed and sealed in red ink.

2) This survey is subject to Wisconsin lien laws. This Plat of Survey is the notice of intent to file lien. Lien waiver required.

Copyright © 2006 by Jensen & Olson Land Surveying, LLC.

All rights reserved. No part of this survey plat may be reproduced or transmitted in any form by any means - graphic, electronic, or mechanical, including photocopying, tracing, or information storage and retrieval systems - without permission in writing from Douglas G. Olson, Jensen & Olson Land Surveying, LLC.

I hereby certify that I have surveyed the above described property and the map hereon is correct to the best of my professional knowledge and belief and shows the size and location of the property, its exterior boundaries, the location and dimensions of all visible structures thereon, boundary fences, apparent easements and roadways and visible encroachments, if any.  
This survey is made for the exclusive use of the present owners of property, and also those who purchase, mortgage or guarantee title thereto, within one year from the date hereof.

Douglas G. Olson  
Wisconsin Registered Land Surveyor - 2093

2006.135

Sheet 1 of 1 Sheets

Job Reference Number

2006.135

### Legend

- Found Iron Pipe
- Found Iron Rod
- ( ) Recorded Information
- ⊗ Utility Pole
- ⊕ Utility Pedestal
- ▨ Asphalt Surface
- ▨ Gravel Surface




**Jensen & Olson Land Surveying, LLC**

45 South Wisconsin Street P.O. Box 322  
Elkhorn, Wisconsin. 53121  
Telephone (262) 723-3434  
Facsimile (262) 723-8044

Scale in Feet

1" = 50'

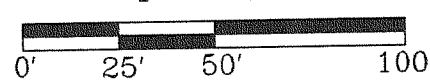

Survey Date: Sept. 27, 2004.

Revisions: No. 1 - Proposed House  
No. 2 - Foundation

DA2207-2 DA2207-3 DA2207-4

415-1125