




PREPARED FOR  
 STEBNITZ BUILDERS  
 C/O DAVE STEBNITZ  
 1102 ANN ST.  
 DELAVAN WI. 53115

# PLAT OF SURVEY

PATHFINDER SURVEYING INC.  
 W2888 KRUEGER RD. UNIT "D"  
 LAKE GENEVA WI. 53147  
 (262) 248-3697

- OF -

LOT 7, BAYVIEW ESTATES, LOCATED IN SECTION 26 TOWN 4  
 NORTH, RANGE 15 EAST, WALWORTH COUNTY, WISCONSIN.

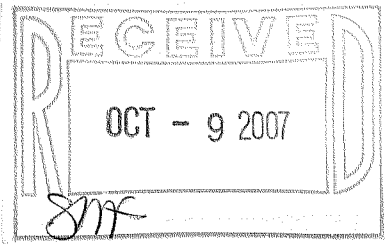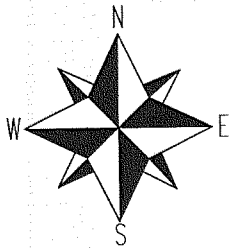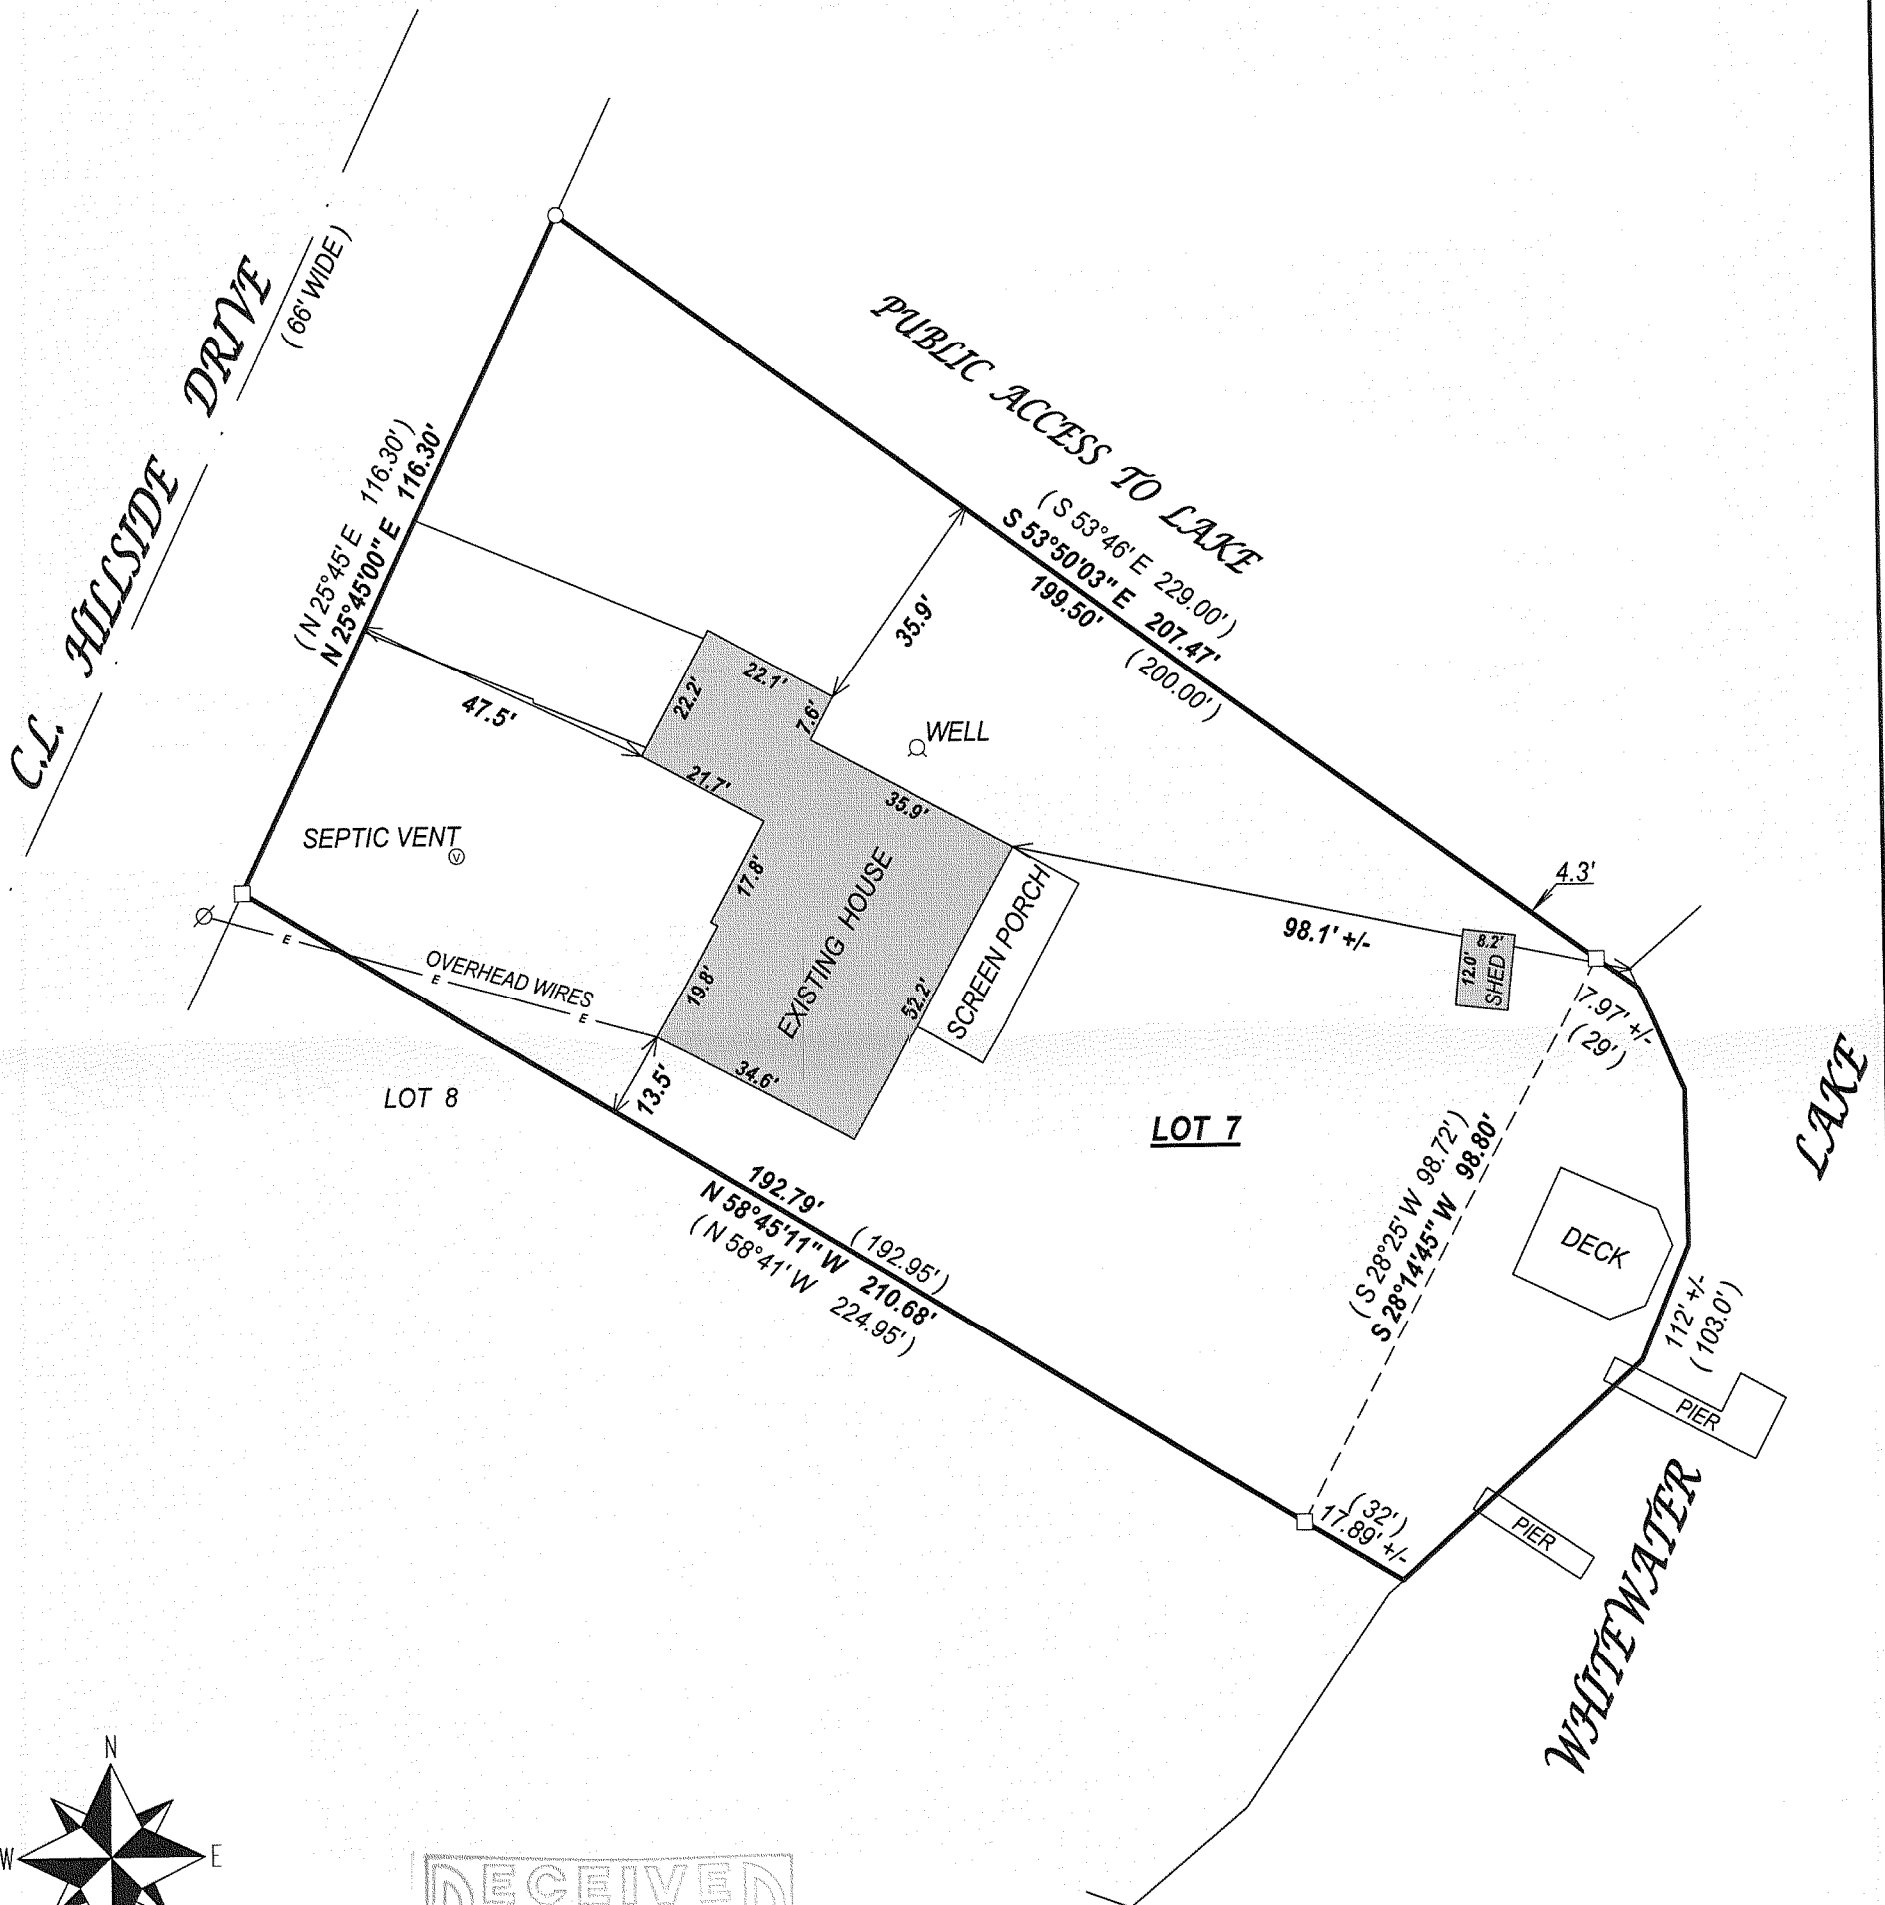

- ( ) = RECORDED AS
- = FOUND IRON BAR
- = FOUND IRON PIPE
- = SET IRON BAR


SCALE 1" = 30'

JOB # 07-346

TAX ID # DBVE00007

COMPARE LEGAL DESCRIPTION ABOVE AND DRAWING WITH DEED. FOR BUILDING RESTRICTIONS AND EASEMENTS NOT SHOWN, REFER TO DEED, ABSTRACT SOURCES AND LOCAL MUNICIPAL CODES. NOTIFY THE SURVEYOR IMMEDIATELY OF ANY DISCREPANCY.

"I hereby certify that I have surveyed the above described property and that the above map, to the best of my knowledge and belief, is a true representation thereof and shows the size and location of all visible structures, apparent easements and encroachments if any."  
 This survey is made for the present owners of the property, and those who purchase, mortgage, or guarantee the title thereto, within one year from the date hereof.

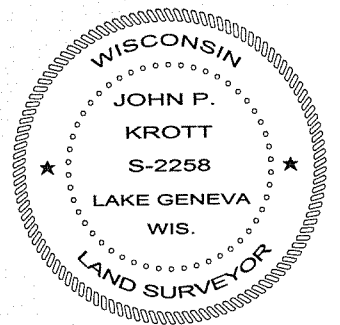

*John P. Krott*

JOHN KROTT S - 2258  
 Wisconsin Registered Land Surveyor  
 (original if signed in red)

DATED THIS THE 13th DAY OF AUGUST 2007.

415-1133