
AS BUILT MAPPING LOT 5 SCATTERED OAKS LOCATED IN THE SE 1/4 SECTION 35 TOWN 4 NORTH, RANGE 15 EAST WALWORTH COUNTY, WISCONSIN

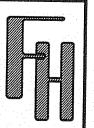


REVISIONS

NOTE: COPIES OF THIS MAP TO WHICH THE FOLLOWING CERTIFICATE WILL APPLY SHOW SURVEYOR'S ORIGINAL SEAL AND SIGNATURE IN RED INK. COPIES BY ANY OTHER MEANS MAY HAVE ALTERATIONS WHICH DO NOT REPRESENT THE SURVEYOR'S WORK PRODUCT.

I HEREBY CERTIFY THAT THIS MAP IS A TRUE AND ACCURATE REPRESENTATION OF THE LOCATION OF THE AS BUILT FOUNDATION IN RELATION TO THE MONUMENTS FOUND AND SHOWN REPRESENTING THE NORTHERLY AND EAST CORNERS TO THE BEST OF MY PROFESSIONAL KNOWLEDGE AND BELIEF. THE SURVEYED BOUNDARY INFORMATION SHOWN IS IN RELATION TO A PLAT OF SURVEY OF THE SUBJECT LOT BY PATHFINDER SURVEYING DATED APRIL 10, 2007. NOTE THIS IS NOT A PLAT OF SURVEY AS DEFINED IN CHAPTER A-E 7 OF WISCONSIN ADMINISTRATIVE CODE

PETER S. GORDON RLS 2101

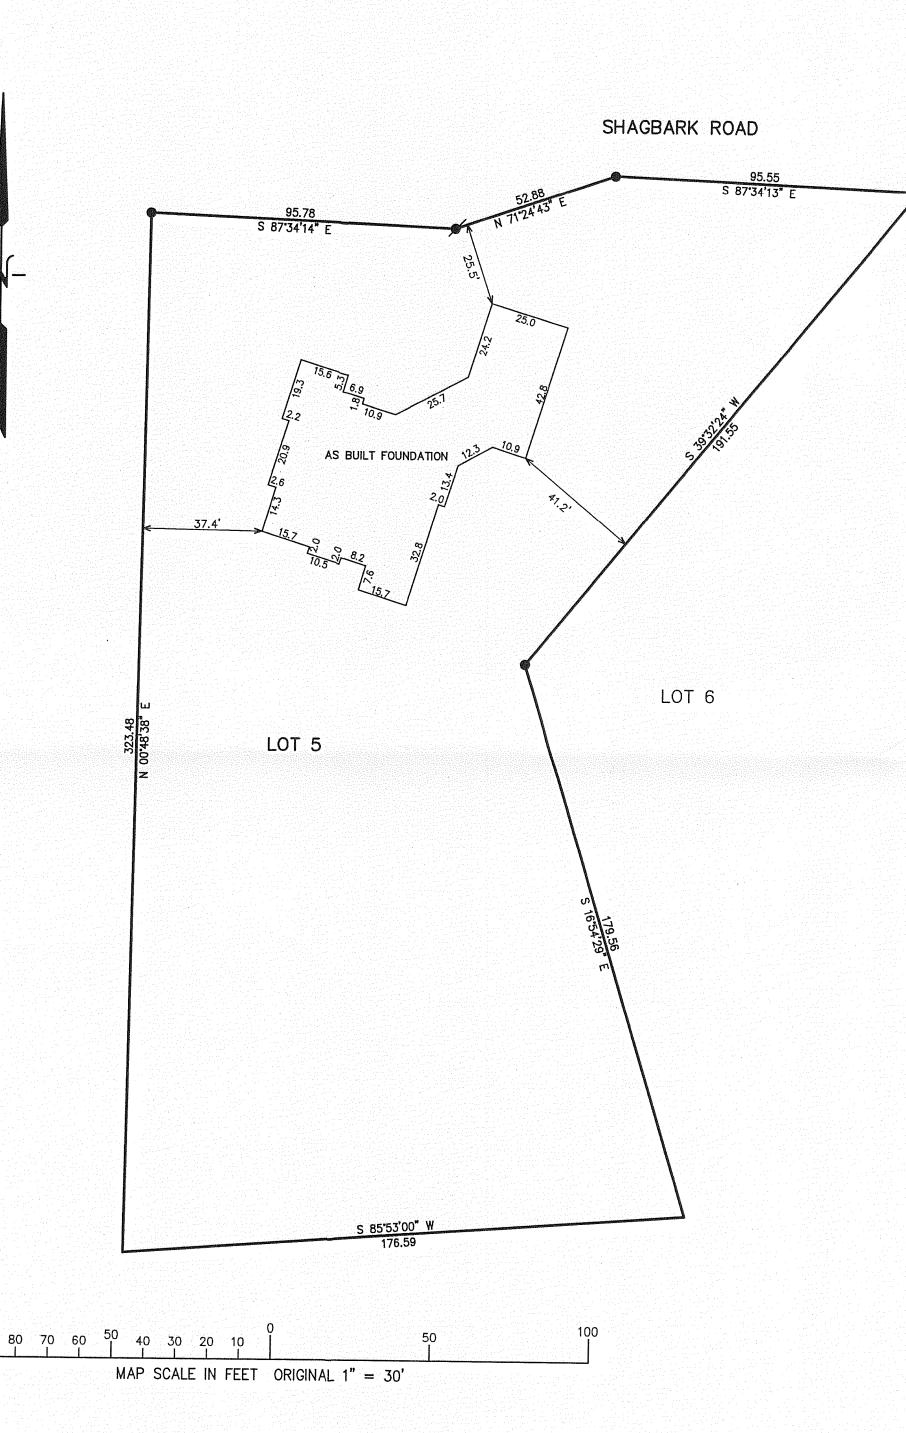

• = FOUND IRON REBAR STAKE ✓ = SET IRON REBAR STAKE

DATED: NOVEMBER 12, 2007

7428 DATE: 11-12-07 SHEET NO.

PROJECT NO.

1 OF 1

english english english english