

Plat of Survey



of

Lots 2, 3, & 4 of Certified Survey Map No. 2207,



recorded in Vol. 10 of Certified Survey Maps of Walworth County on Page 312 and located in the Northwest 1/4 and the Southwest 1/4 of Section 25, Town 4 North, Range 15 East, Town of Whitewater, Walworth County, Wisconsin.

Surveyed for: Maurice Loeffel
7818 Newbold Road
Cary, Illinois. 60013

Detail of House
1"=20'

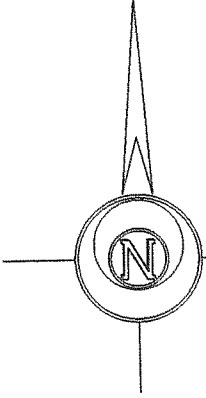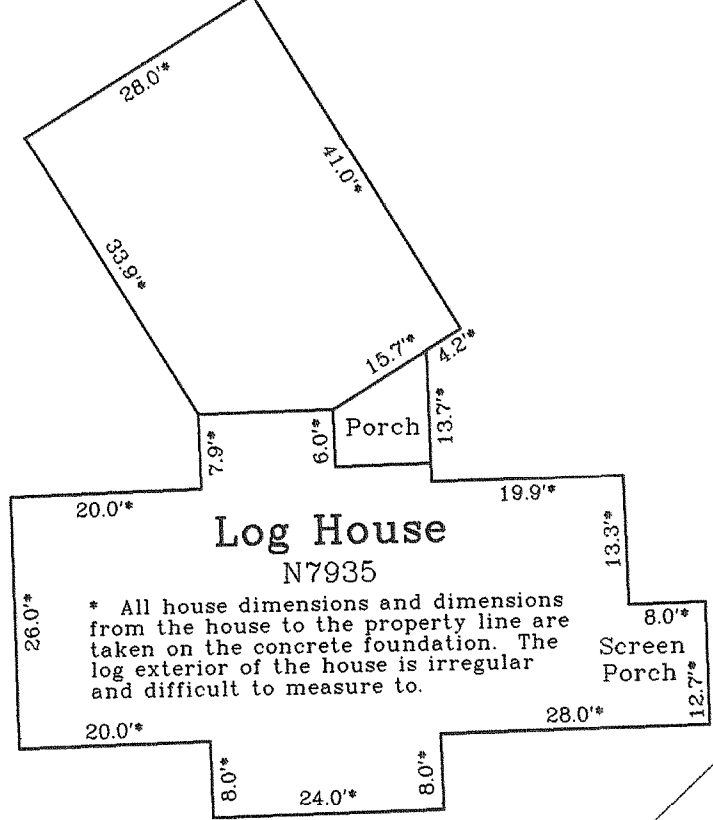

Bearings reference to Certified Survey Map No. 2207.

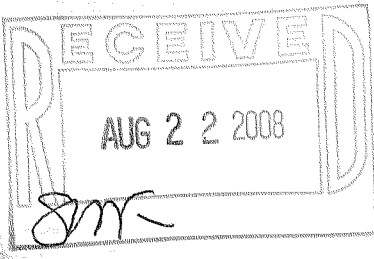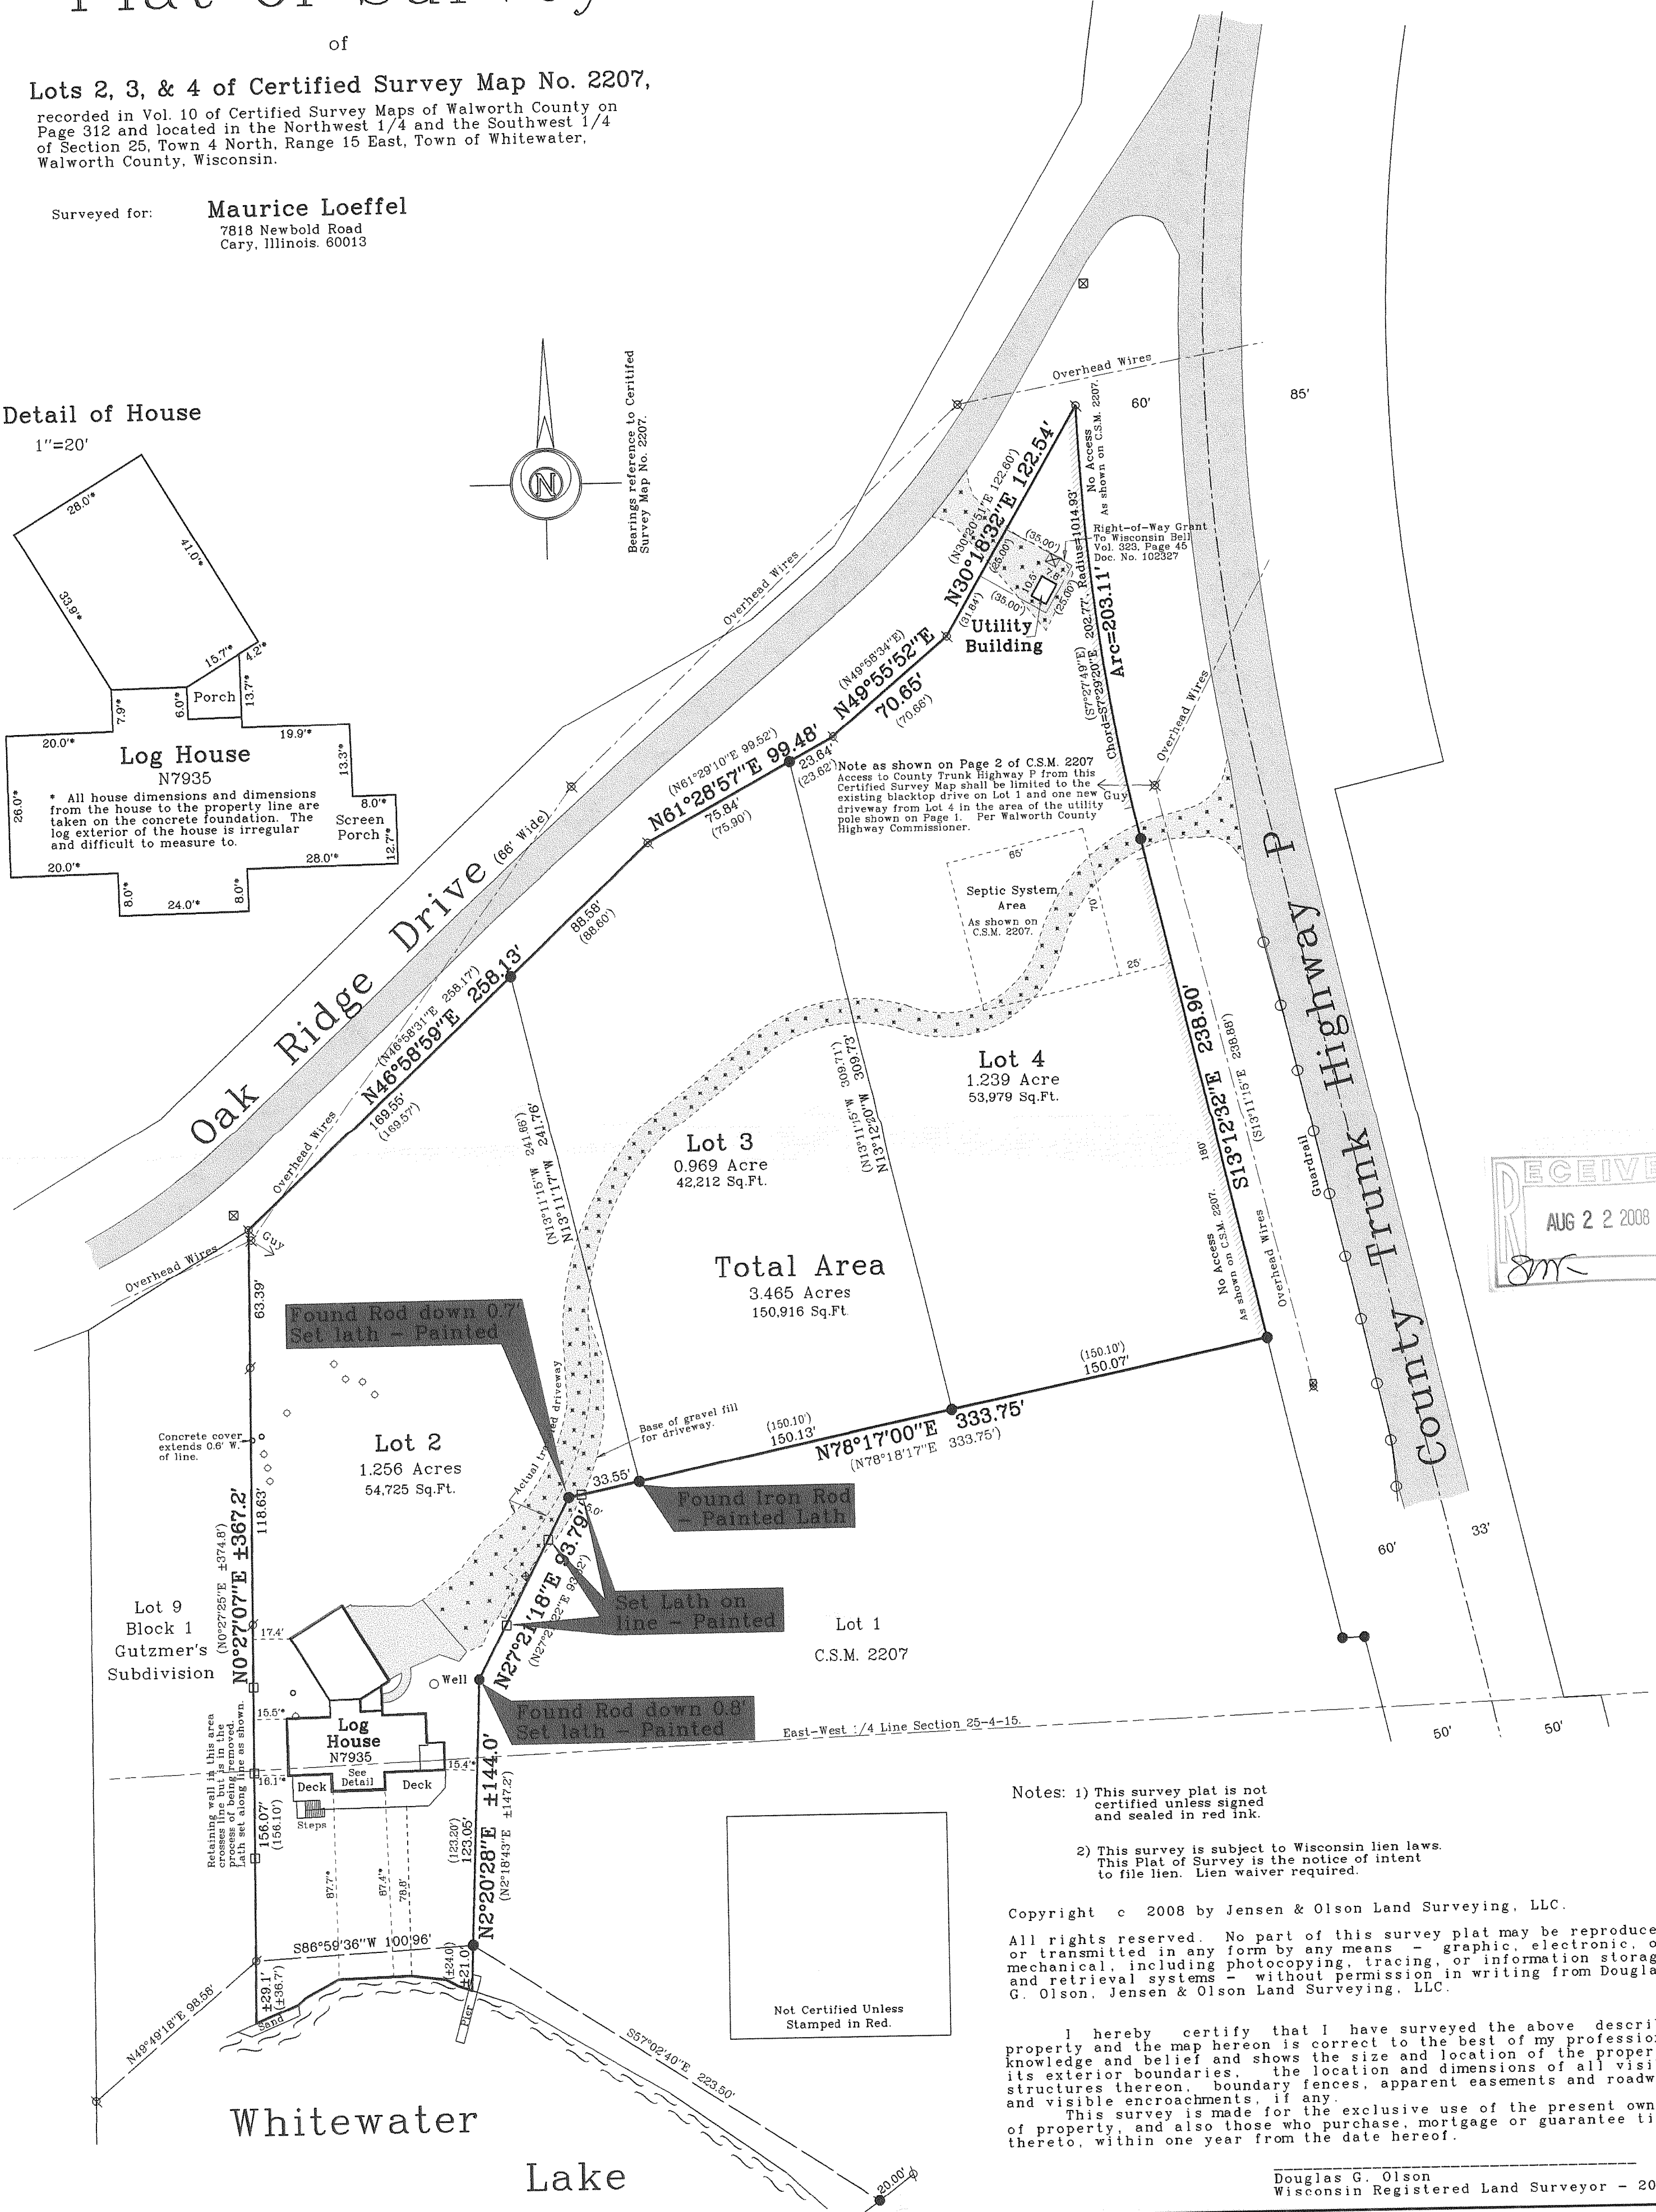

Notes: 1) This survey plat is not certified unless signed and sealed in red ink.

2) This survey is subject to Wisconsin lien laws. This Plat of Survey is the notice of intent to file lien. Lien waiver required.

Copyright c 2008 by Jensen & Olson Land Surveying, LLC.

All rights reserved. No part of this survey plat may be reproduced or transmitted in any form by any means - graphic, electronic, or mechanical, including photocopying, tracing, or information storage and retrieval systems - without permission in writing from Douglas G. Olson, Jensen & Olson Land Surveying, LLC.

I hereby certify that I have surveyed the above described property and the map hereon is correct to the best of my professional knowledge and belief and shows the size and location of the property, its exterior boundaries, the location and dimensions of all visible structures thereon, boundary fences, apparent easements and roadways and visible encroachments, if any.
This survey is made for the exclusive use of the present owners of property, and also those who purchase, mortgage or guarantee title thereto, within one year from the date hereof.

Douglas G. Olson
Wisconsin Registered Land Surveyor - 2093

2008.072
Sheet 1 of 1 Sheets
Job Reference Number
2008.072

Legend
○ Concrete Cover
○ Septic Cap or Vent
○ Found Iron Pipe
○ Found Iron Rod
() Recorded Information
x Utility Pole
x Utility Pedestal
x Asphalt Surface
x Gravel Surface
□ Wood Lath Set on line
□ Concrete



Jensen & Olson Land Surveying, LLC

45 South Wisconsin Street P.O. Box 322
Elkhorn, Wisconsin. 53121
Telephone (262) 723-3434
Facsimile (262) 723-8044

Scale in Feet
1" = 50'
0' 25' 50' 100'

Survey Date: April 4, 2008.
Revisions: No. 1 - Points marked

DA2207-2 DA2207-3 DA2207-4

415-1168