
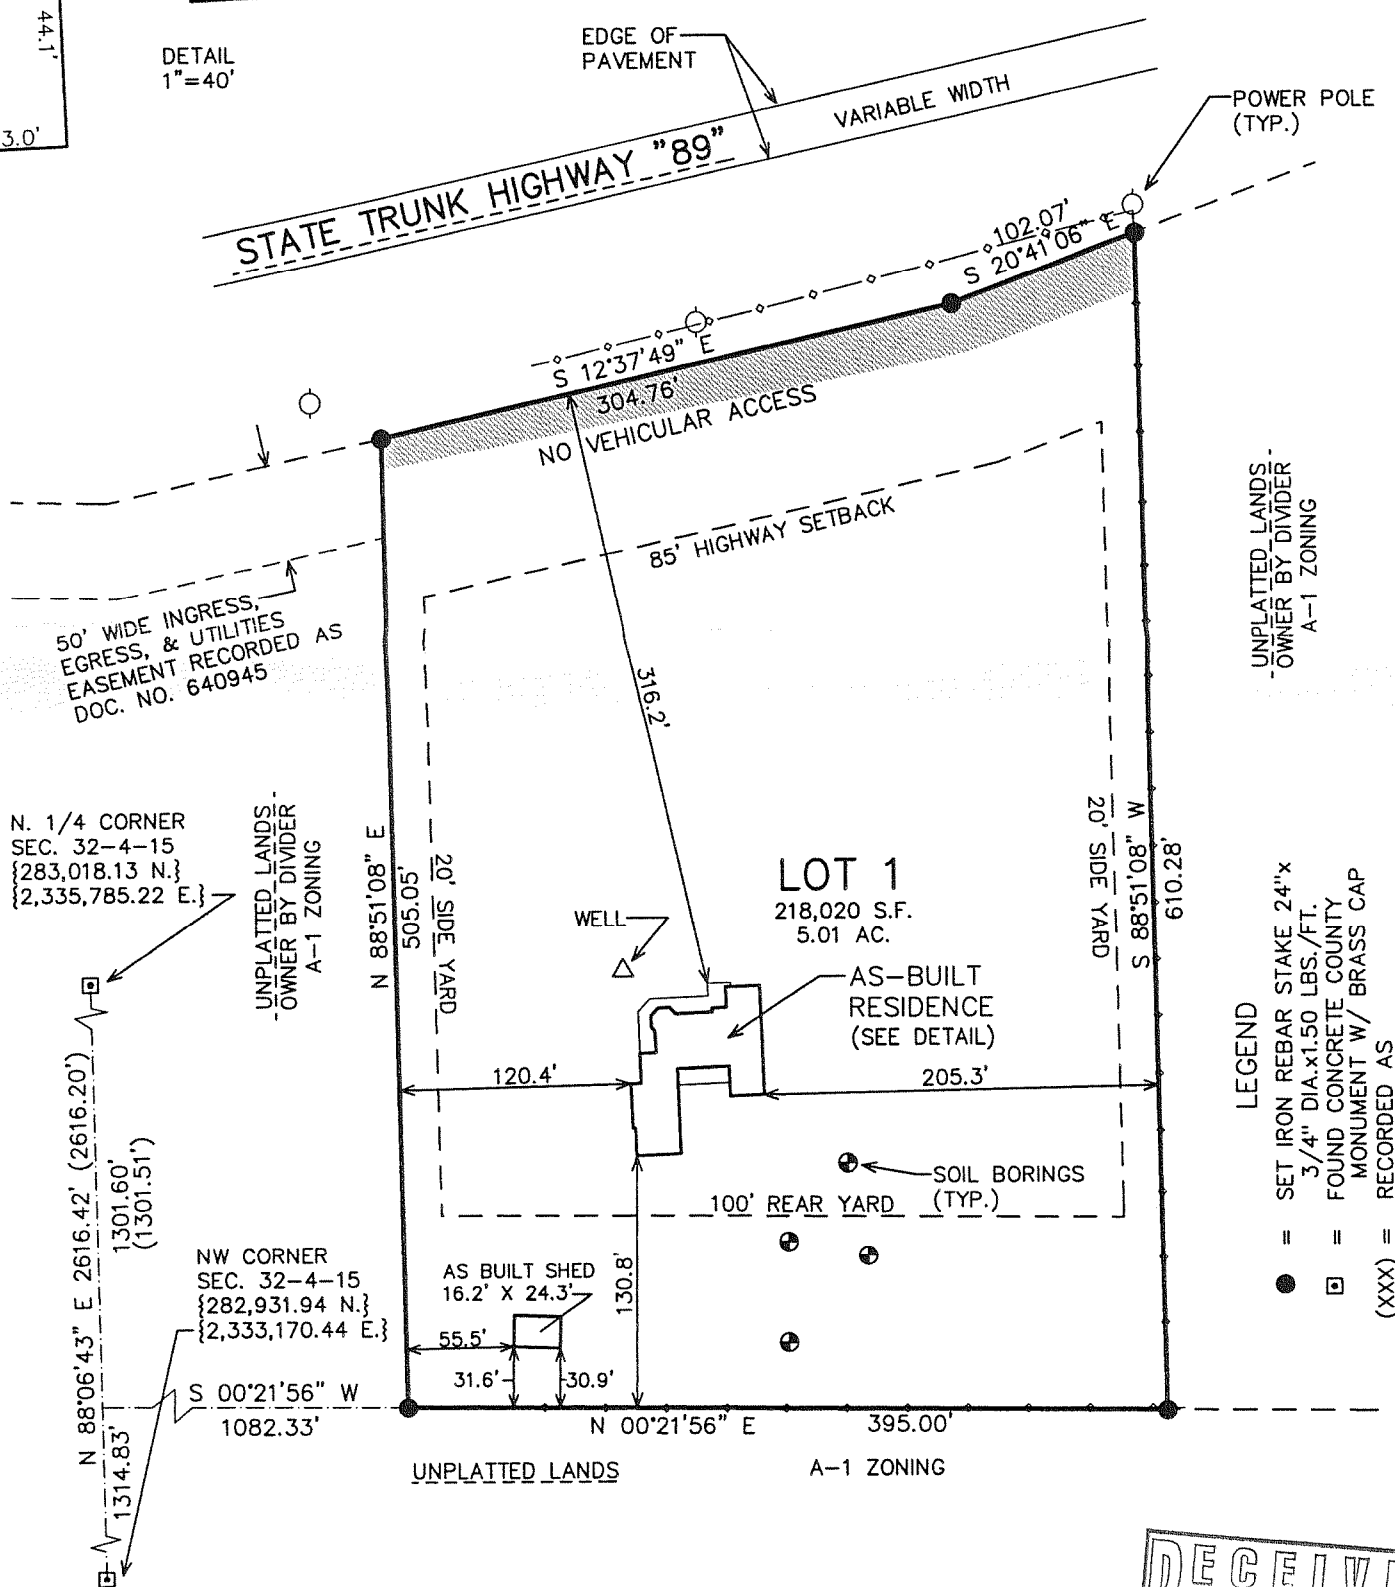


ENGINEERING — ARCHITECTURE — SURVEYING
7 RIDGWAY COURT — P.O. BOX 437 — ELKHORN, WISCONSIN 53121
PHONE: (262) 723-2098 FAX: (262) 723-5886

LOCATED IN THE NE 1/4 AND SE 1/4 OF
THE NW 1/4 OF SECTION 32, TOWN 4 NORTH,
RANGE 15 EAST, WALWORTH COUNTY, WISCONSIN

GRID NORTH
W. COORD. SYSTEM
SOUTH ZONE
ASSIGNED N. LINE NW 1/4
N 88 06' 43" E

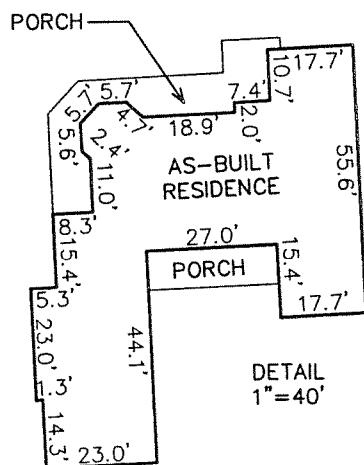


I HEREBY CERTIFY THAT THE ABOVE DESCRIBED PROPERTY HAS BEEN SURVEYED UNDER MY DIRECTION AND THAT THE ABOVE MAP IS A TRUE REPRESENTATION THEREOF AND SHOWS THE SIZE AND LOCATION OF THE PROPERTY AND ITS EXTERIOR BOUNDARIES. THIS SURVEY IS MADE FOR THE USE OF THE PRESENT OWNERS OF THE PROPERTY, AND ALSO THOSE WHO PURCHASE, MORTGAGE, OR GUARANTEE THE TITLE THERETO WITHIN ONE YEAR FROM THE DATE HEREOF.

REVISED: JULY 7, 2005 TO SHOW SIZE & LOCATION OF AS-BUILT RESIDENCE
REVISED 12-08-2008 TO SHOW SIZE & LOCATION OF AS BUILT SHED

PETER S. GORDON R.L.S. 2101

RECEIVED
JAN 9 2009
By SMF

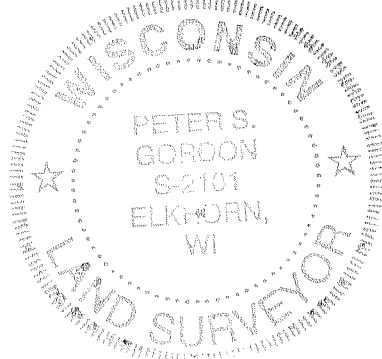

PROJECT: 4270.04
DATE: 04/13/2005
SHEET 1 OF 1