

# Plat of Survey


of

## Lot 17 of Block 2 of Ludtke Subdivision,


located in the Southwest 1/4 of Section 26, Town 4 North, Range 15 East,  
Town of Whitewater, Walworth County, Wisconsin.

Surveyed for: **David & Linda Finn**

97 Forestview Drive  
Elgin, Illinois. 60120

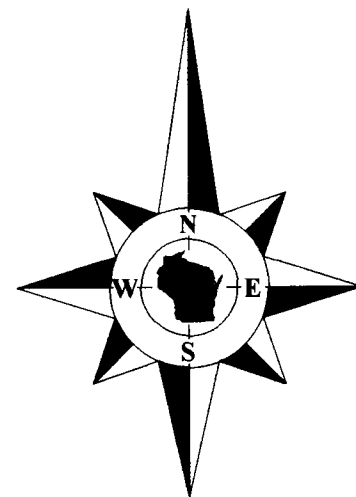


Bearings reference to the plat  
of Ludtke Subdivision.

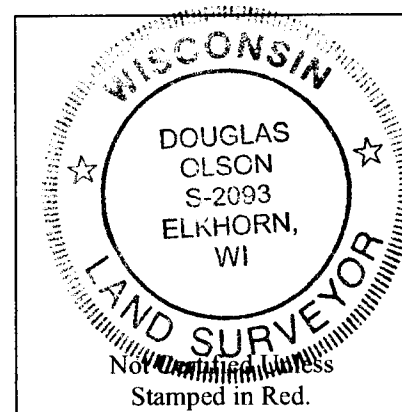

### Notes:

- 1) This survey plat is not certified unless signed and sealed in red ink.
- 2) This survey is subject to Wisconsin lien laws. This Plat of Survey is the notice of intent to file lien. Lien waiver required.

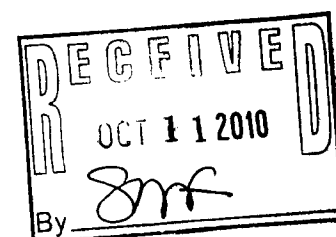


Copyright 2004 by Jensen & Olson Land Surveying, LLC.

All rights reserved. No part of this survey plat may be reproduced or transmitted in any form by any means - graphic, electronic, or mechanical, including photocopying, tracing, or information storage and retrieval systems - without permission in writing from Douglas G. Olson, Jensen & Olson Land Surveying, LLC.


I hereby certify that I have surveyed the above described property and the map hereon is correct to the best of my professional knowledge and belief and shows the size and location of the property, its exterior boundaries, the location and dimensions of all visible structures thereon, boundary fences, apparent easements and roadways and visible encroachments, if any.

This survey is made for the exclusive use of the present owners of the property, and also those who purchase, mortgage or guarantee title thereto, within one year from the date hereof.

Douglas G. Olson  
Wisconsin Registered Land Surveyor - 2093

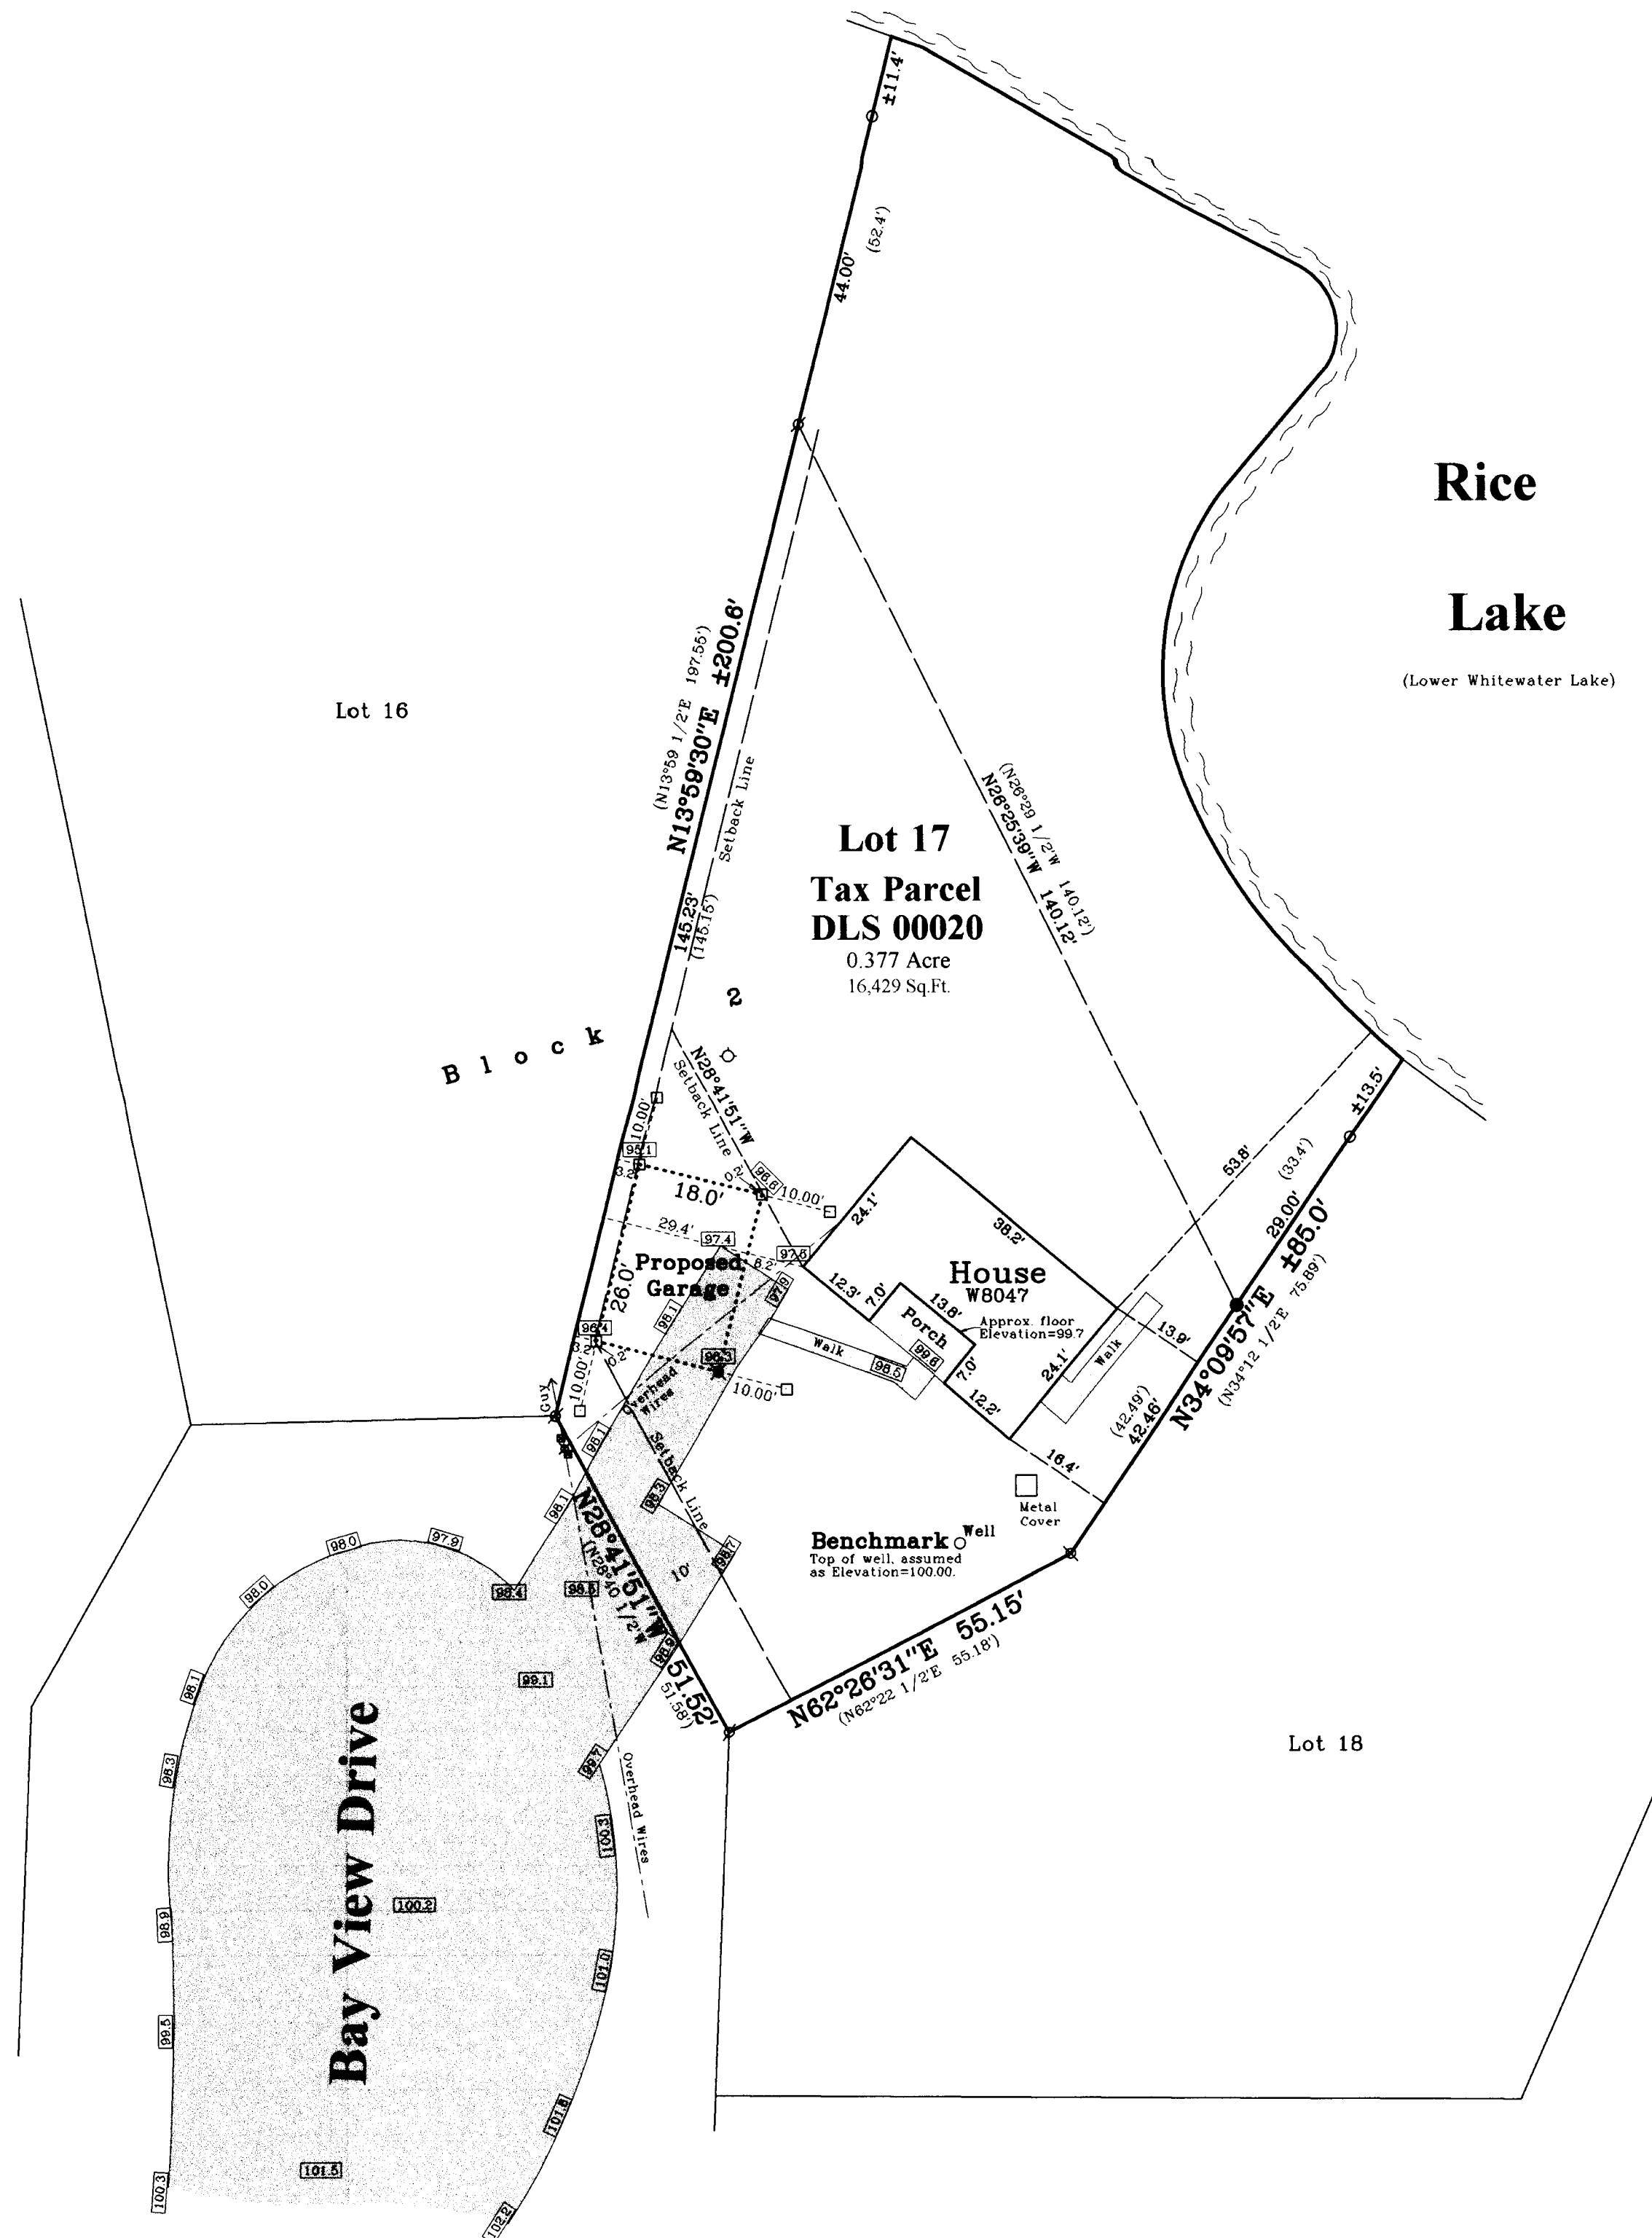

Survey Date: November 2, 2004.  
Revisions: No. 1 - Proposed Garage  
No. 2 - Garage Slaked  
Spot elevations

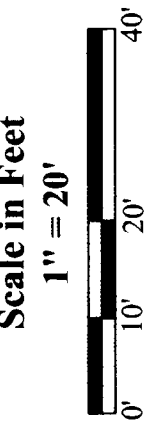

**Jensen & Olson Land Surveying, LLC**  
45 South Wisconsin Street \* P.O. Box 322 \* Elkhorn, Wisconsin. 53121  
Telephone: (262) 723-3434 \* Facsimile: (262) 723-8044  
Email: jensen.olson@elknet.net

**Legend**  
Found Iron Pipe □ Set Wood  
Found Iron Rod □ Stake  
Set Mag Nail  
( ) Recorded Information  
Septic Vent ■ Utility Pedestal  
Asphalt Surface ■ Utility Pole  
Concrete Surface

Sheet 1 of 1 Sheets  
Drawing Name: ddr15c-2010032-2010032Pdrn-2-  
Job Reference Number  
**2010.032**

2010.032