




PREPARED FOR
RUCK FAMILY TRUST
41709 N SIGNAL HILL CT.
ANTHEM AZ. 85086

PLAT OF SURVEY

-OF-

LOT 13 OF SHEREDA WOODS SUBDIVISION LOCATED
IN THE SOUTHWEST 1/4 OF SECTION 25, TOWN 4 NORTH,
RANGE 15 EAST, WALWORTH COUNTY, WISCONSIN.

KROTT SURVEYING INC.
N3705 WILLOW BEND LANE
LAKE GENEVA WI. 53147
PHONE # (262)248-3697
FAX # (262)249-0639

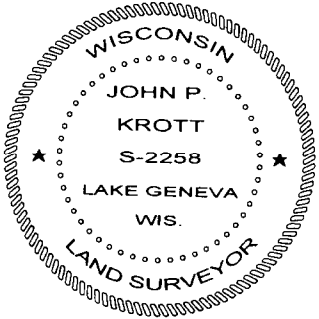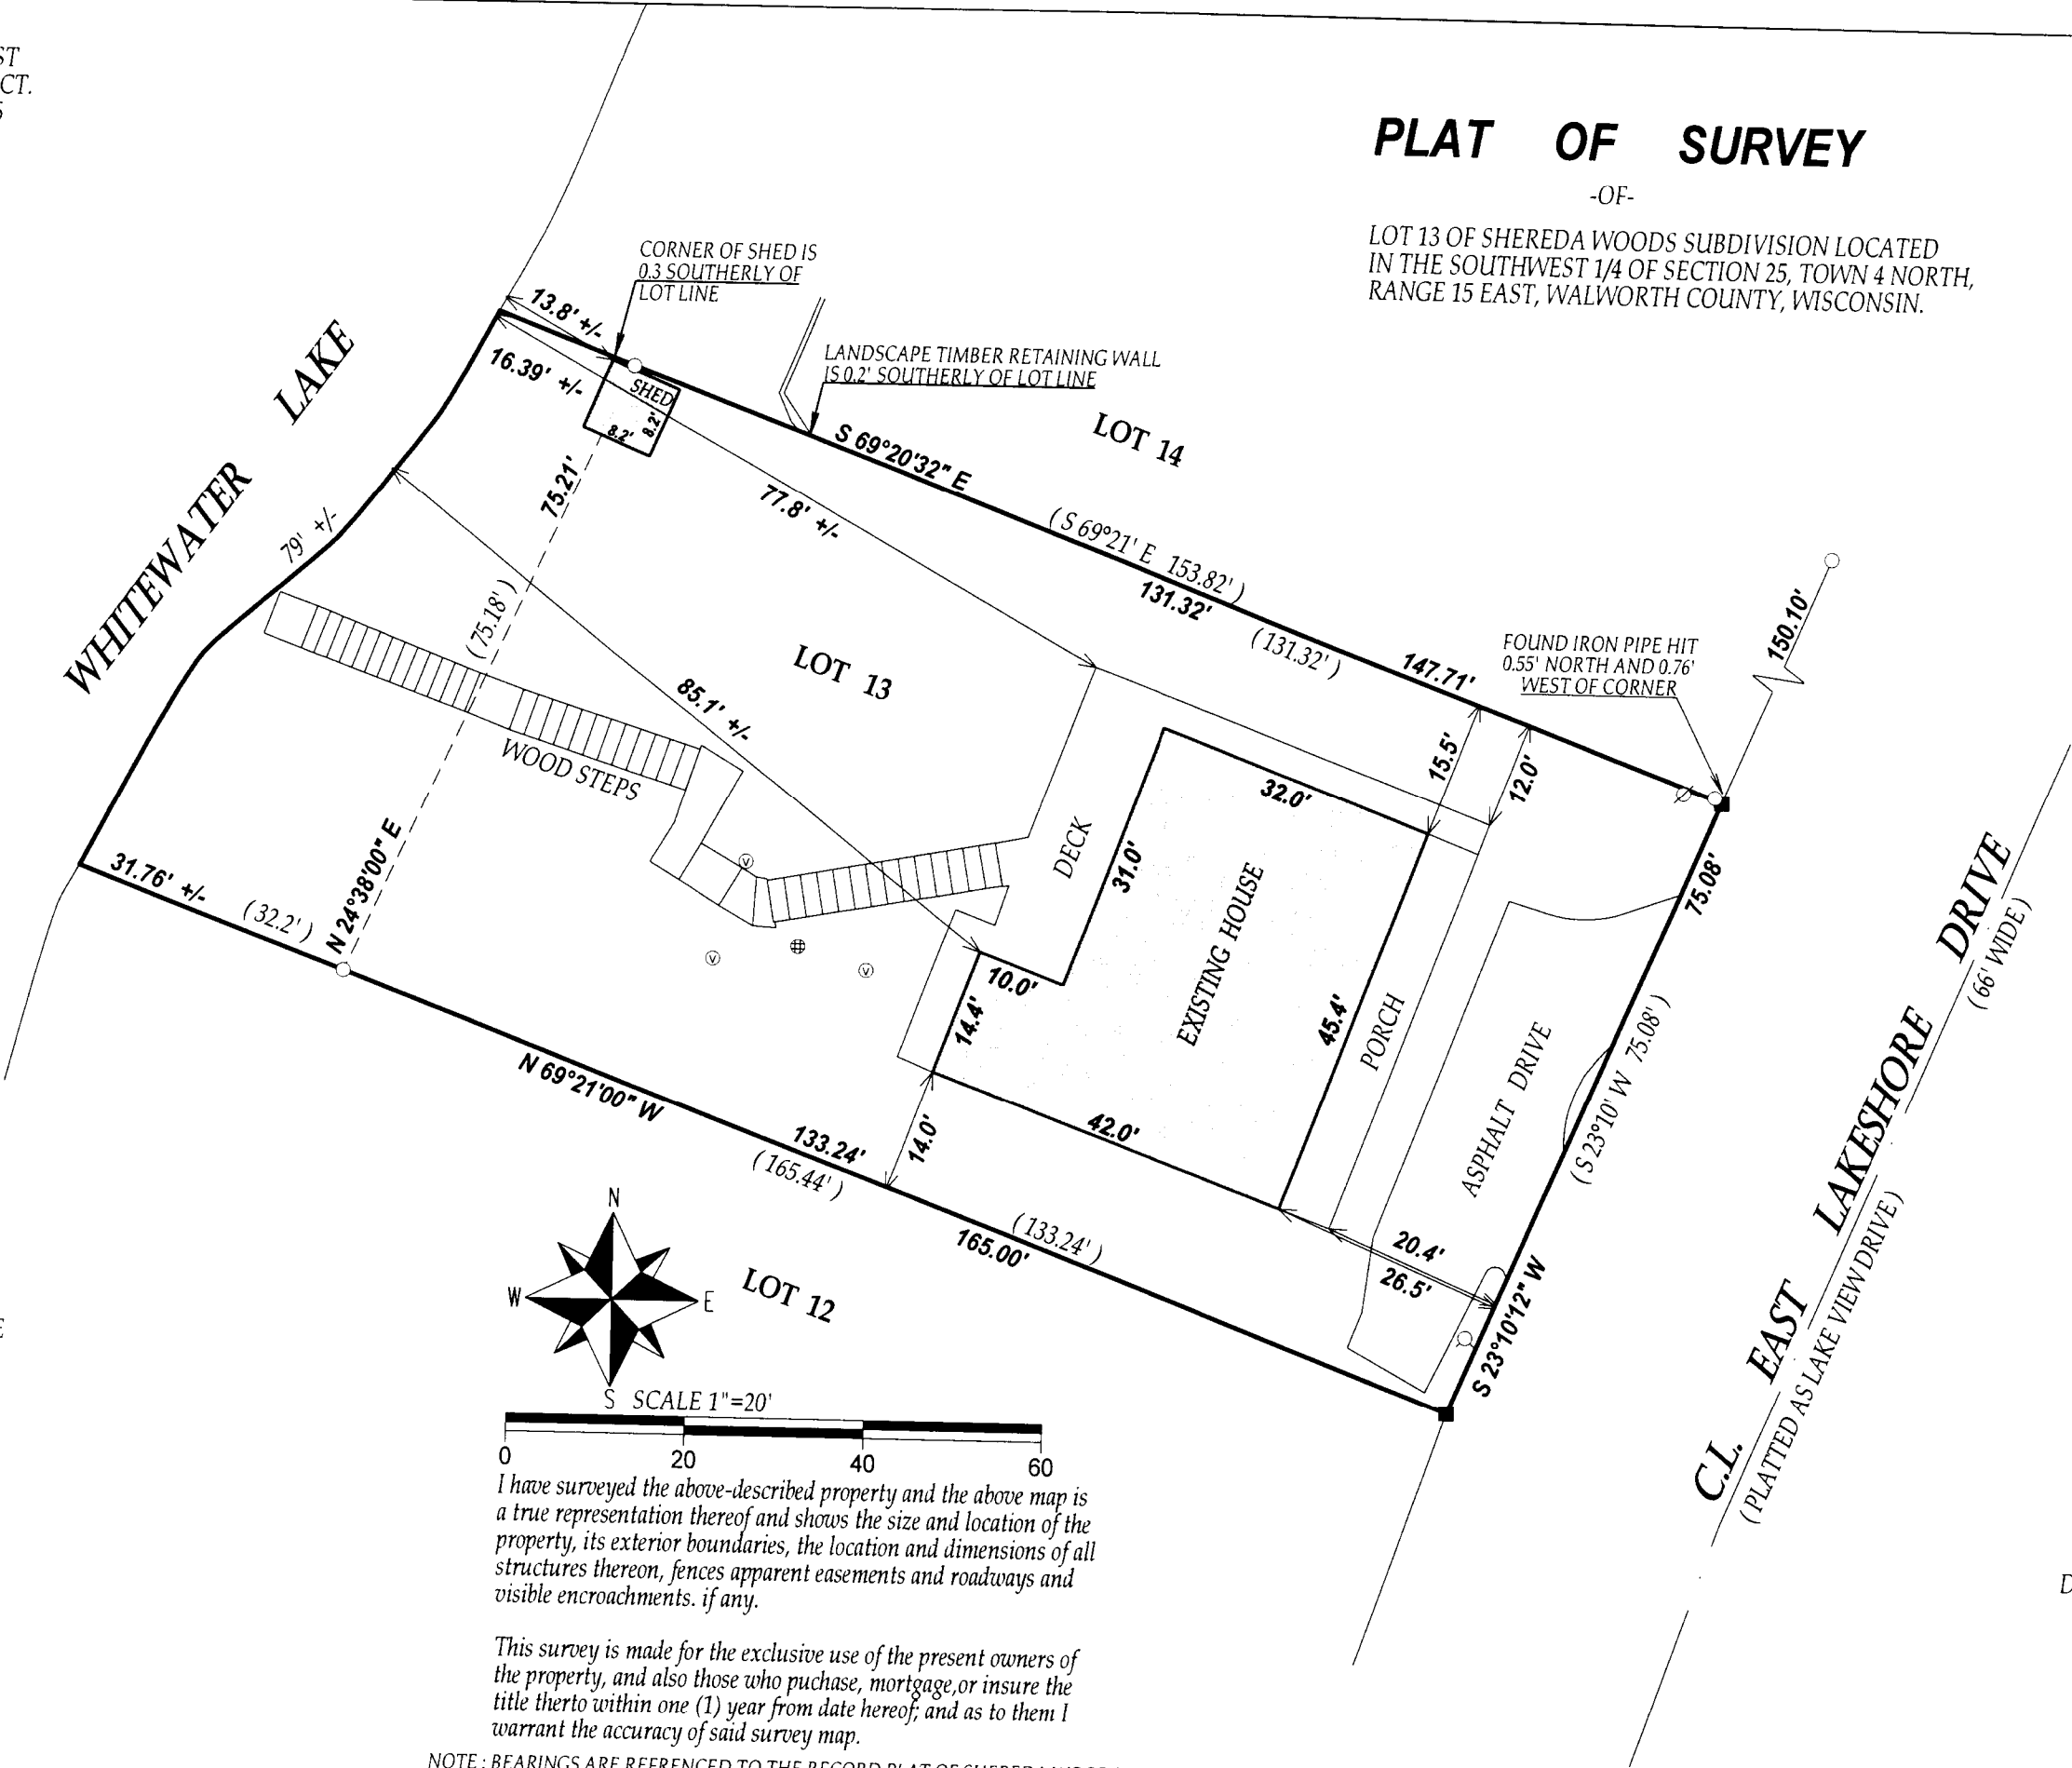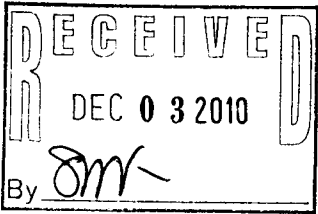

DATED THIS 22nd DAY OF NOVEMBER 2010.

John P. Krott

JOHN KROTT S - 2258
Wisconsin Registered Land Surveyor
(original if signed in red)