


1140 SEQUOIA STREET • DELAVAN, WISCONSIN 53115  
262-728-6737


 



BEARINGS ARE REFERENCED TO THE  
RECORDED SUBDIVISION PLAT.

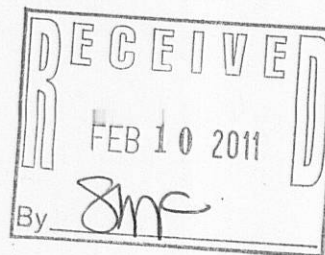

SCALE 1" = 20'

### LEGEND

-  - IRON PIPE FOUND  
 - IRON ROD FOUND  
 - UTILITY POLE  
 ( ) - RECORDED AS

LOT 31

DISTANCE FROM HOUSE TO SHORE  
ON LOT 31 ON 3/24/10 IS 58.7'±

DISTANCE FROM HOUSE TO SHORE  
ON LOT 30 ON 3/24/10 IS 59.7'±

LOT 33

DISTANCE FROM HOUSE TO SHORE  
ON LOT 33 ON 3/24/10 IS 56.5'±

DISTANCE FROM HOUSE TO SHORE  
ON LOT 34 ON 3/24/10 IS 39.5'

LOT 32, BLOCK 1, MORaine HEIGHTS, LOCATED  
IN T4N. R15E. TOWN OF WHITEWATER, WALWORTH  
COUNTY, WISCONSIN.

ORDERED BY: KEEFE REAL ESTATE  
P.O. BOX 460  
LAKE GENEVA, WI 53147

REVISED: MARCH 24, 2010 TO SHOW DISTANCES  
FROM THE DECKS ON LOT 32 TO THE SHORE.  
TO SHOW DISTANCES FROM THE HOUSES ON LOTS  
30, 31, 33 AND 34 TO THE SHORE FROM THE CLOSEST  
CORNER OF THE HOUSES.

REVISED: JUNE 1, 2010 TO SHOW WOOD DECK TO BE  
REMOVED. 1.0' TO BE REMOVED FROM WOOD DECK  
ABOVE AND LOCATION OF PROPOSED CONCRETE PATIO.

REVISED: JUNE 28, 2010 TO SHOW AS-BUILT ON  
BLOCK PATIO AND WOOD DECK UNDER  
CONSTRUCTION.

REVISED: JANUARY 3, 2011 TO SHOW PROPOSED  
PORCH.

ORDERED BY: GAIL WEBER  
C. WEBER BUILDERS  
W7990 COUNTY ROAD A  
DELAVER, WI 53115

OWNER : JEFFREY BELLINGER

I HEREBY CERTIFY THAT I HAVE SURVEYED THE ABOVE DESCRIBED PROPERTY AND THAT THE ABOVE MAP IS A TRUE REPRESENTATION THEREOF AND SHOWS THE SIZE AND LOCATION OF THE PROPERTY, ITS EXTERIOR BOUNDARIES, THE LOCATION OF ALL VISIBLE STRUCTURES AND DIMENSIONS OF ALL PRINCIPAL BUILDINGS THEREON, BOUNDARY FENCES, APPARENT EASEMENTS, ROADWAYS AND VISIBLE ENCROACHMENTS, IF ANY, TO THE BEST OF MY KNOWLEDGE AND BELIEF.

THIS SURVEY IS MADE FOR THE USE OF THE PRESENT OWNERS OF THE PROPERTY, AND ALSO THOSE WHO PURCHASE, MORTGAGE, OR GUARANTEE THE TITLE THERETO WITHIN ONE (1) YEAR FROM DATE HEREON.

DAVID F. ABELL  
WISCONSIN REGISTERED LAND SURVEYOR, S-1596

June 8, 2009

DATE \_\_\_\_\_ JOB NUMBER - 94134E  
NOTE: THIS IS NOT A CERTIFIED COPY UNLESS SEALED.