

**LAND-MARK SURVEYING**  
**Mark L. Miritz**  
Wisconsin Registered Land Surveyor S-2582

N9330 Knuteson Drive  
Whitewater, WI 53190  
Phone: (262) 495-3284  
MARKMIRITZ@  
LAND-MARKSURVEYING.COM


**PLAT OF SURVEY**

LEGAL DESCRIPTION AS FOUND IN VOLUME 28, PAGE 327,  
DOCUMENT NO. 624624 OF WALWORTH COUNTY RECORDS

A PART OF LOTS 10 AND 11 OF THORNE HEIGHTS, A SUBDIVISION LOCATED IN SECTION 35, TOWN 4 NORTH, RANGE 15 EAST, WALWORTH COUNTY, WISCONSIN, DESCRIBED AS FOLLOWS, TO-WIT: BEGINNING AT THE MOST SOUTHERLY CORNER OF SAID LOT 10; THENCE NORTH 39°33' EAST ALONG THE SOUTHEASTERLY LINE OF SAID LOT 10, 120.00 FEET; THENCE NORTH 38°30' WEST 159.28 FEET TO THE IRON PIPE ON THE LAKE SHORE BASE LINE OF SAID SUBDIVISION LOCATED BETWEEN SAID LOTS 10 AND 11 AND CONTINUE ON THE SAME COURSE, NORTH 38°30' WEST 91.39 FEET MORE OR LESS TO THE SHORE OF WHITEWATER LAKE; THENCE SOUTHWESTERLY ALONG THE SHORE OF WHITEWATER LAKE 122.4 FEET MORE OR LESS TO A POINT LOCATED NORTH 39°41' WEST FROM THE PLACE OF BEGINNING; THENCE SOUTH 39°41' EAST ALONG THE LINE DIVIDING LOTS 9 AND 10 OF SAID SUBDIVISION 292.11 FEET MORE OR LESS TO THE PLACE OF BEGINNING.

ORDERED BY:  
RON SIMON  
REALTY EXECUTIVES ELITE

SITE ADDRESS:  
N7395 EAST LAKE SHORE DR.  
WHITEWATER, WI 53190

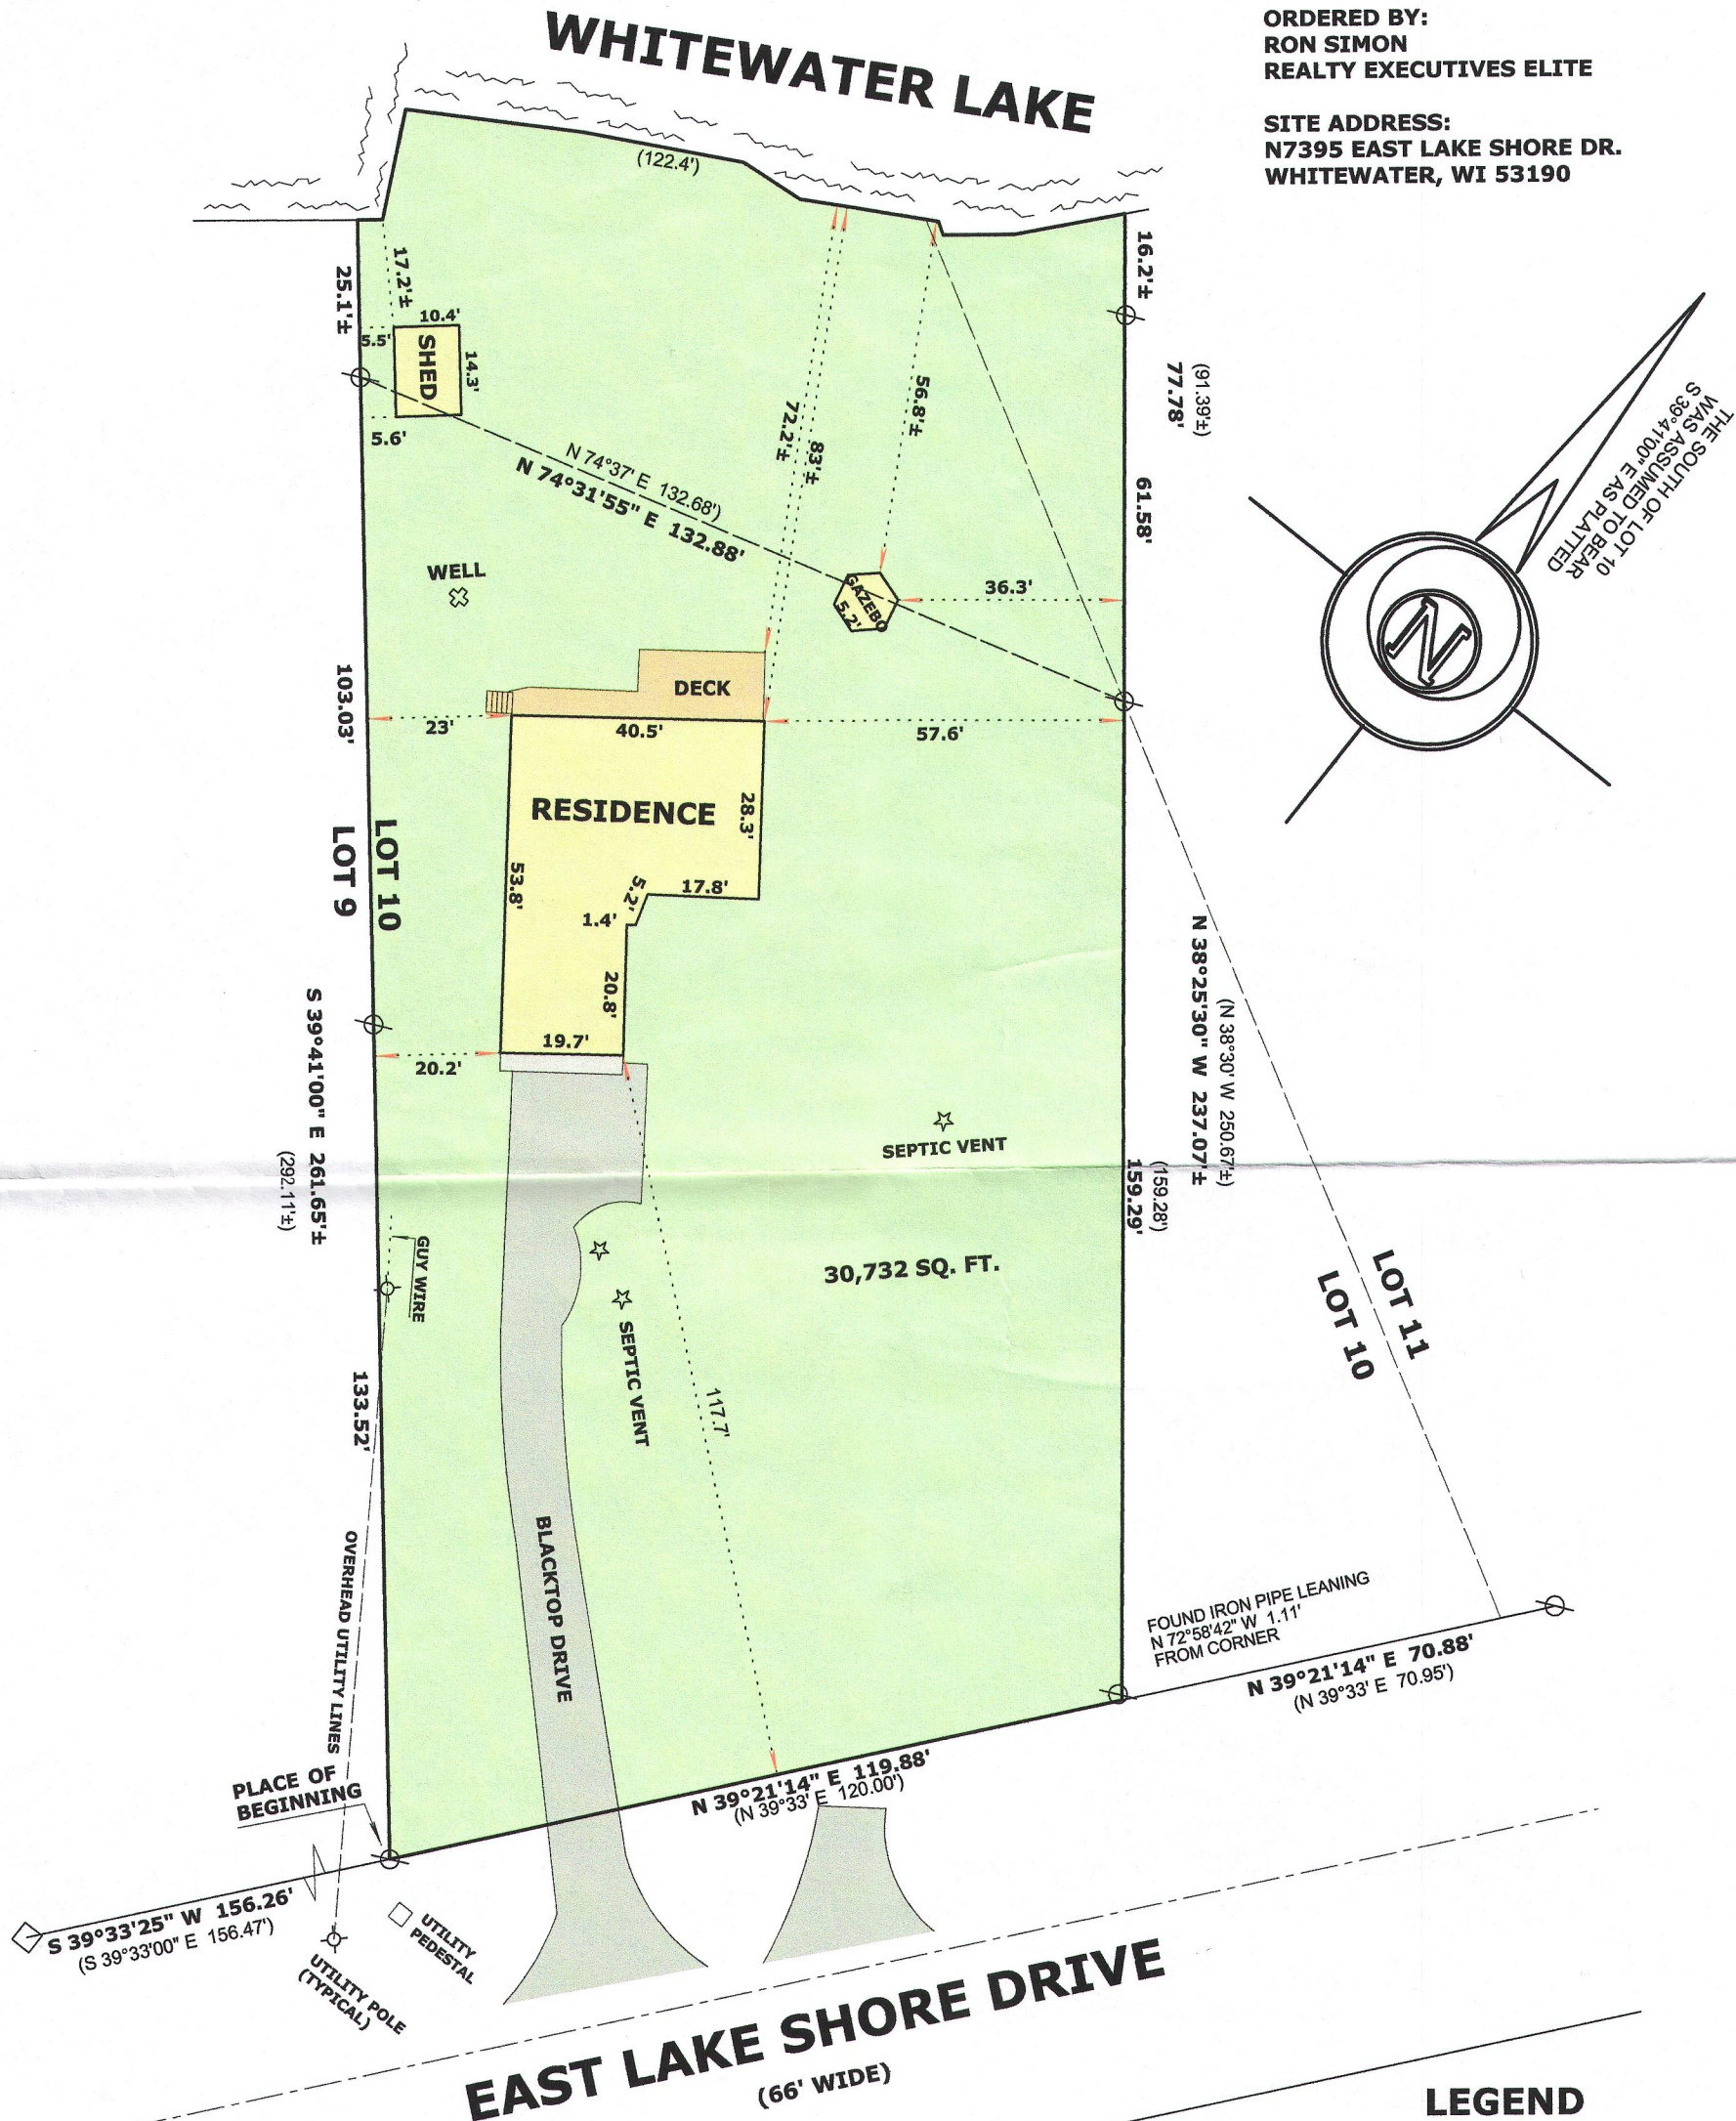

**LEGEND**

- ⊗ FOUND IRON PIPE
- FOUND CONCRETE MONUMENT
- ( x x ) RECORDED AS DIMENSION

SCALE: 1 INCH = 30 FEET


"I hereby certify that the above described property has been surveyed by me or under my direction and that the above map is a true representation thereof and shows the size and location of the property, its exterior boundaries, the location of all visible structures and dimensions of all principal buildings thereon, boundary fences, apparent easements, roadways and visible encroachments, if any."  
"This survey is made for the use of the present owners of the property, and also those who purchase, mortgage, or guarantee the title thereto within one year from date hereof."

MARK L. MIRITZ  
WISCONSIN REGISTERED  
LAND SURVEYOR S-2582

DATE: MAY 17, 2013 JOB NO. 13.507

**SURVEYOR'S NOTE:**

THE OWNER STATED THAT THERE ARE  
TWO SEPTIC SYSTEMS ON THE PROPERTY  
NO TANKS FOUND.

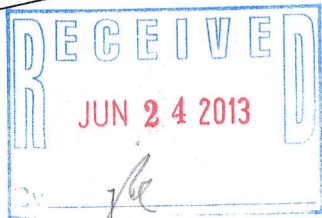

dth 00010 415-1285