

# Plat of Survey

of

## Lots 61 & 62 of Scattered Oaks,

a subdivision located in the Southwest 1/4 of Section 36, Town 4 North,  
Range 15 East, Town of Whitewater, Walworth County, Wisconsin.

Surveyed for: **Francine Pease**  
N7431 Burr Oak Road  
Whitewater, Wisconsin. 53190

Lot 60  
Scattered Oaks

Lot 61  
Tax Parcel  
DSO 00061  
0.796 Acre  
34,679 Sq.Ft.

Lot 62  
Tax Parcel  
DSO 00062  
1.156 Acre  
50,336 Sq.Ft.

Lot 14  
Blue Heron Hills

Lot 43  
Scattered Oaks

Lot 42  
Scattered Oaks

Lot 66  
Scattered Oaks

### Notes:

- 1) This survey plat is not certified unless signed and sealed in red ink.
- 2) This survey is subject to Wisconsin lien laws. This Plat of Survey is the notice of intent to file lien. Lien waiver required.


Copyright 2013 by Jensen & Olson Land Surveying, LLC.

All rights reserved. No part of this survey plat may be reproduced or transmitted in any form by any means - graphic, electronic, or mechanical, including photocopying, tracing, or information storage and retrieval systems - without permission in writing from Douglas G. Olson, Jensen & Olson Land Surveying, LLC.


I hereby certify that I have surveyed the above described property and the map hereon is correct to the best of my professional knowledge and belief and shows the size and location of the property, its exterior boundaries, the location and dimensions of all visible structures thereon, boundary fences, apparent easements and roadways and visible encroachments, if any.

This survey is made for the exclusive use of the present owners of the property, and also those who purchase, mortgage or guarantee title thereto, within one year from the date hereof.

Douglas G. Olson  
Wisconsin Registered Land Surveyor - 2093

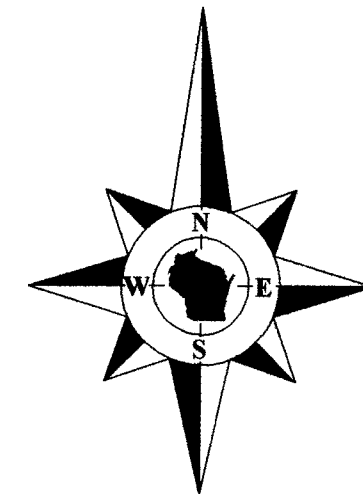

Bearings reference to the  
plat of Scattered Oaks.

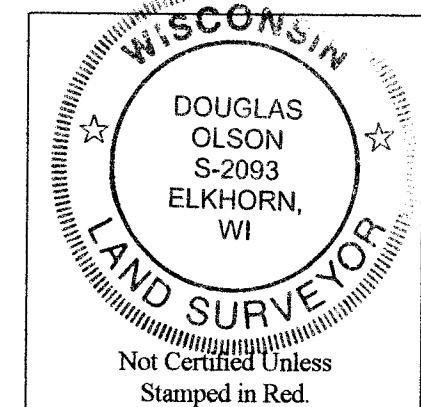

Survey Date: November 4, 2013  
Revisions:

Scale in Feet  
1" = 30'  
0' 15' 30' 60'

**Jensen & Olson Land Surveying, LLC**  
45 South Wisconsin Street \* P.O. Box 322 \* Elkhorn, Wisconsin. 53121  
Telephone: (262) 723-3434 \* Facsimile: (262) 723-8044  
Email: jensen.olson@elknet.net

**Legend**  
Found Iron Pipe 1-3/16" dia.  
Found Iron Rod 3/4" dia.  
Set Iron Pipe 1" dia.  
Utility Information  
Concrete Cover  
Septic Vent  
Asphalt Surface  
Concrete

Sheet 1 of 1 Sheets  
Drawing Name: d80-62  
Job Reference Number  
**2013.117**

2013.117

d80-62

d80 -61

415-1299