



PREPARED FOR  
KRISTA MIKULSKI  
W7778 DEERWOOD DR  
WHITEWATER WI 53190

# PLAT OF SURVEY

PATHFINDER SURVEYING INC.  
(formerly)  
J.K. SURVEYING INC.  
P.O BOX 322  
LAKE GENEVA, WI. 53147  
WWW.PATHFINDERSURVEYING.NET  
262-248-8303

- OF -

LOT 13 BAYVIEW ESTATES, A SUBDIVISION LOCATED IN PART OF  
SECTION 26, TOWN 4 NORTH, RANGE 15 EAST, TOWN OF WHITEWATER,  
COUNTY OF WALWORTH AND STATE OF WISCONSIN.

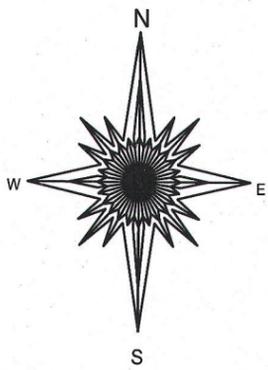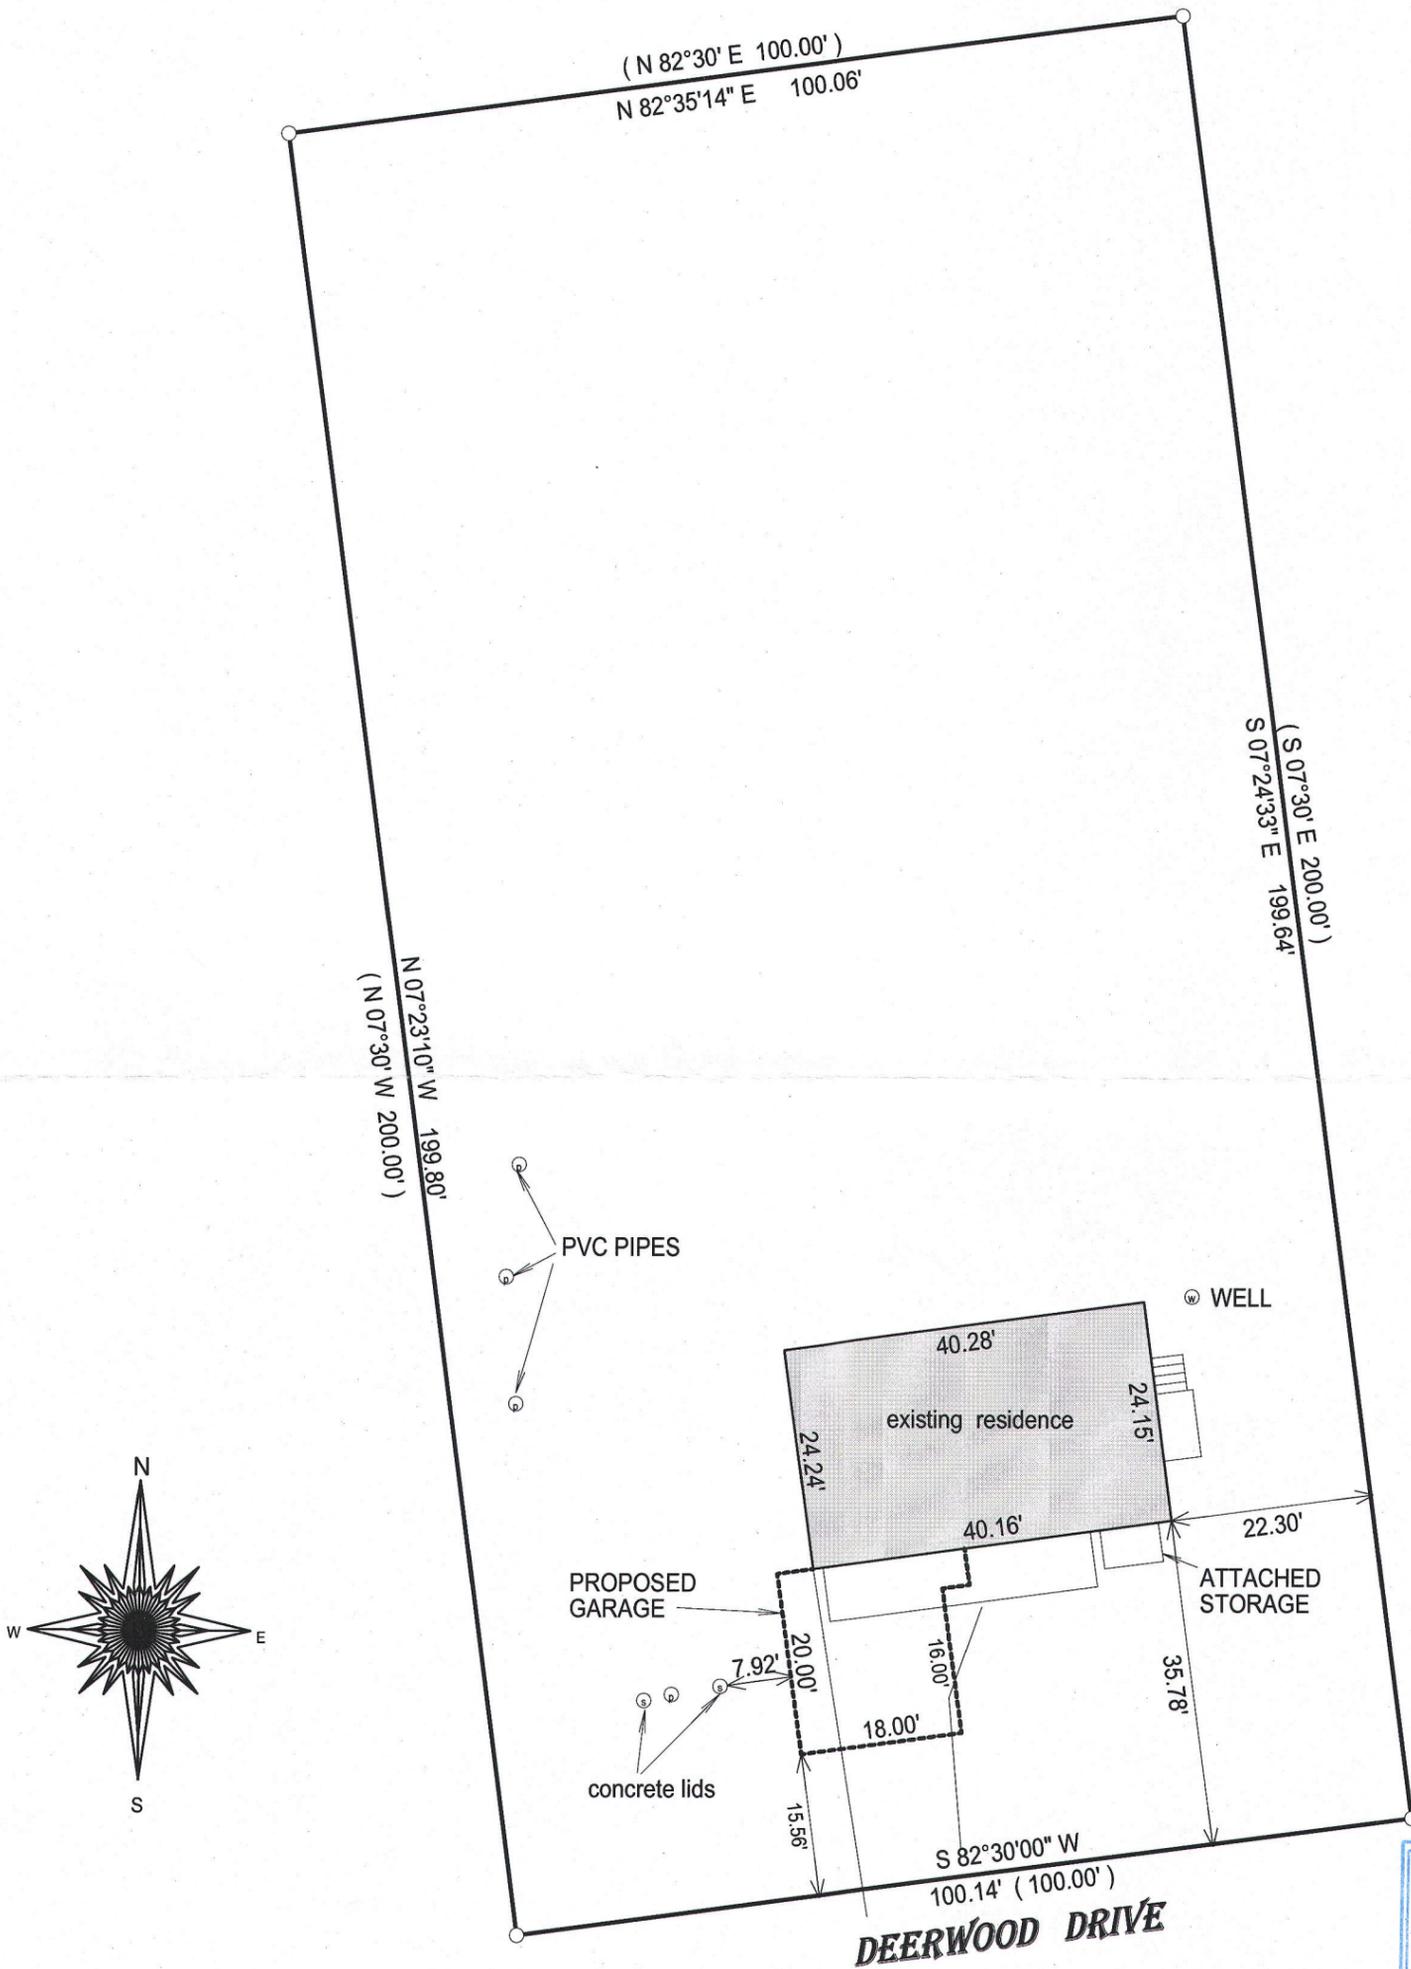


- ( ) = recorded as
- = found iron bar
- = found iron pipe
- = set iron pipe
- = set iron bar

SCALE 1" = 20'

JOB # 15-102

TAX ID # DBVE00013


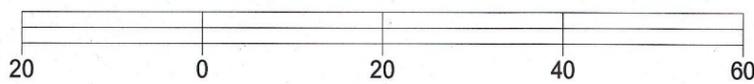


BASIS OF BEARING OF THIS PLAT: THE NORTHERLY LINE  
OF DEERWOOD DR WAS ASSUMED TO BEAR S 82°30' W AS RECORDED.

I hereby certify that I have surveyed the above-described property and the above map is a true representation thereof and shows the size and location of the property, its exterior boundaries, the location and dimensions of all structures thereon, fences, apparent easements and roadways and visible encroachments if any.

This survey is made for the present owners of the property, and those who purchase, mortgage, or guarantee the title thereto, within one year from the date hereof.

DATED THIS 20TH DAY OF APRIL, 2015.

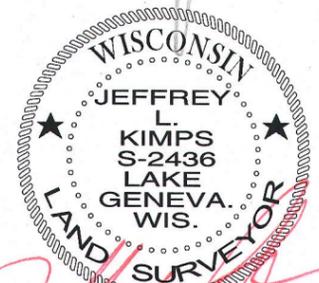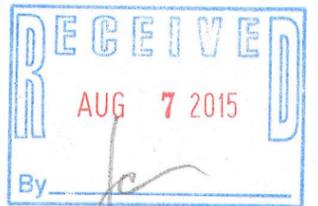

JEFFREY L. KIMPS S - 2436  
Wisconsin Registered Land Surveyor  
(original if signed in red)

dBVE-13 415-1359