

**LAND-MARK SURVEYING**  
**Mark L. Miritz**

Wisconsin Professional Land Surveyor S-2582


N9330 Knuteson Drive  
Whitewater, WI 53190  
Phone: (262) 495-3284  
MARKMIRITZ@  
LAND-MARKSURVEYING.COM

**PLAT OF SURVEY**

LOT 20, BLOCK 2, MORaine HEIGHTS SUBDIVISION,  
LOCATED IN THE NORTHWEST 1/4 OF SECTION 35,  
TOWN 4 NORTH, RANGE 16 EAST, WHITEWATER  
TOWNSHIP, WALWORTH COUNTY, WISCONSIN.

ORDERED BY: MARGARET CANFIELD  
@ PROPERTIES  
880 WEST MAIN STREET  
LAKE GENEVA, WI 53147

SITE ADDRESS:  
N7663 RIDGE ROAD  
WHITEWATER, WI 53190

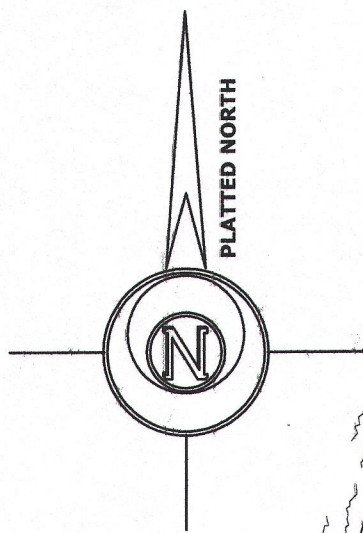

WHITEWATER LAKE

BLOCK 2

LOT 19

LOT 20  
9,318 SQ. FT.

LOT 21

RIDGE ROAD

50' WIDE

SOUTH 75.00'

**LEGEND**



FOUND IRON PIPE

( x x )

RECORDED AS DIMENSION


SCALE: 1 INCH = 20 FEET

"I hereby certify that the above described property has been surveyed by me or under my direction and that the above map is a true representation thereof and shows the size and location of the property, its exterior boundaries, the location of all visible structures and dimensions of all principal buildings thereon, boundary fences, apparent easements, roadways and visible encroachments, if any."  
"This survey is made for the use of the present owners of the property, and also those who purchase, mortgage, or guarantee the title thereto within one year from date hereof."

*Mark L. Miritz*

MARK L. MIRITZ  
WISCONSIN PROFESSIONAL  
LAND SURVEYOR S-2582

DATE: APRIL 15, 2016 JOB NO. 07.1106

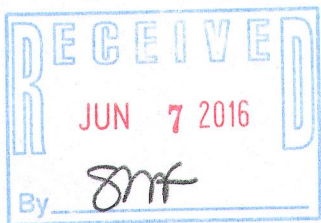

DMH-54

415-1389