

Whitewater  
Lake

# Plat of Survey


of

## Lot 10 in Block 4 of Moraine Heights,


a subdivision located in the Northwest 1/4 of Section 35, Town 4 North,  
Range 15 East, Town of Whitewater, Walworth County, Wisconsin.

Surveyed for: **Keefe Real Estate, Inc.**

416 Bauer Parkway  
Delavan, Wisconsin. 53115

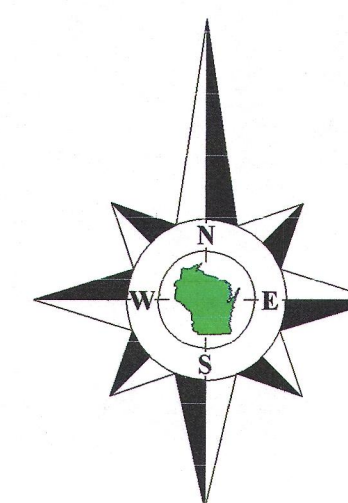

Bearings reference to the  
plat of Moraine Heights.

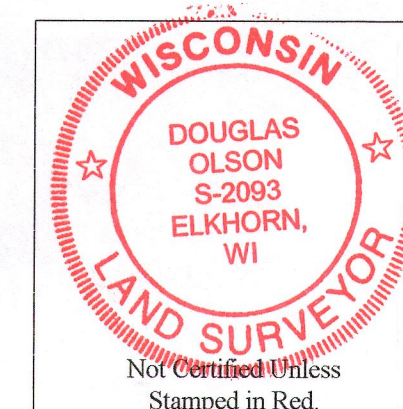

### Notes:

- 1) This survey plat is not  
certified unless signed  
and sealed in red ink.
- 2) This survey is subject to Wisconsin lien laws.  
This Plat of Survey is the notice of intent  
to file lien. Lien waiver required.

Copyright 2016 by Olson Land Surveying, LLC.


All rights reserved. No part of this survey plat may be reproduced or transmitted in  
any form by any means - graphic, electronic, or mechanical, including photocopying,  
tracing, or information storage and retrieval systems - without permission in writing  
from Douglas G. Olson, Olson Land Surveying, LLC.

I hereby certify that I have surveyed the above described property and the map  
hereon is correct to the best of my professional knowledge and belief and shows the size  
and location of the property, its exterior boundaries, the location and dimensions of all  
visible structures thereon, boundary fences, apparent easements and roadways and  
visible encroachments, if any.

This survey is made for the exclusive use of the present owners of the property,  
and also those who purchase, mortgage or guarantee title thereto, within one year from  
the date hereof.

Douglas G. Olson  
Wisconsin Professional Land Surveyor - 2093

Survey Date: February 4, 2016.  
Revisions:

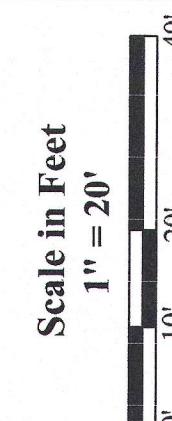

**Olson Land Surveying, LLC**

45 South Wisconsin Street \* P.O. Box 322 \* Elkhorn, Wisconsin. 53121  
Telephone: (262) 723-3434 \* Facsimile: (262) 723-8044  
Email: doug@olsonsurveying.com

**Legend**  
Found Iron Pipe  
Found Mag Nail  
Recorded Information  
Utility Pole  
Concrete Cover  
Asphalt Surface  
Concrete Surface  
Gravel  
Pedestal

Sheet 1 of 1 Sheets  
Drawing Name  
Job Reference Number  
**2016.006**

**2016.006**

DMH-93

415-1395