


**PLAT OF SURVEY**

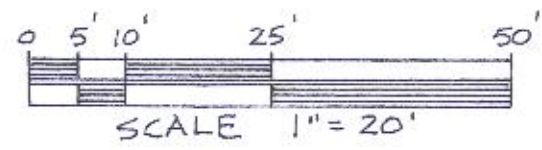

Prepared for:  
John Chitjian  
3266 Middlesax Drive  
Long Grove, IL 60047

- Found 3/4" Iron Rod In 1 1/2" Iron Pipe Leaning Westerly
- Found 1 1/2" Iron Pipe
- Found 3/4" Iron Rod

**NOTES:**

- This parcel may be subject to any and all easements or agreements either recorded or unrecorded.
- Assumed north referenced to the westerly line of East Lake Shore Drive bearing S15°07'W.

**LEGAL DESCRIPTION**  
Lot 9, SHEREDA WOODS in the SW¼ of Section 25, T4N, R15E, Town of Whitewater, Walworth County, Wisconsin.

**CERTIFICATION**  
I hereby certify that the property described above has been surveyed under my responsible direction and supervision and that this map is an accurate representation of the lot lines and dimensions and principle lines of the permanent structures thereon to the best of my knowledge and belief.

Date: 8-24-19

*Mark E. Anderson*  
Mark E. Anderson  
Professional Land Surveyor, S-1370



**ANDERSON LAND SURVEYING LLC**  
Mark E. Anderson, Professional Land Surveyor  
W6141 Star School Road, Fort Atkinson, WI 53538  
Tel: 920-563-8162 andersonlandsurvey@gmail.com

DSP-9

415-1483