
PLAT OF SURVEY

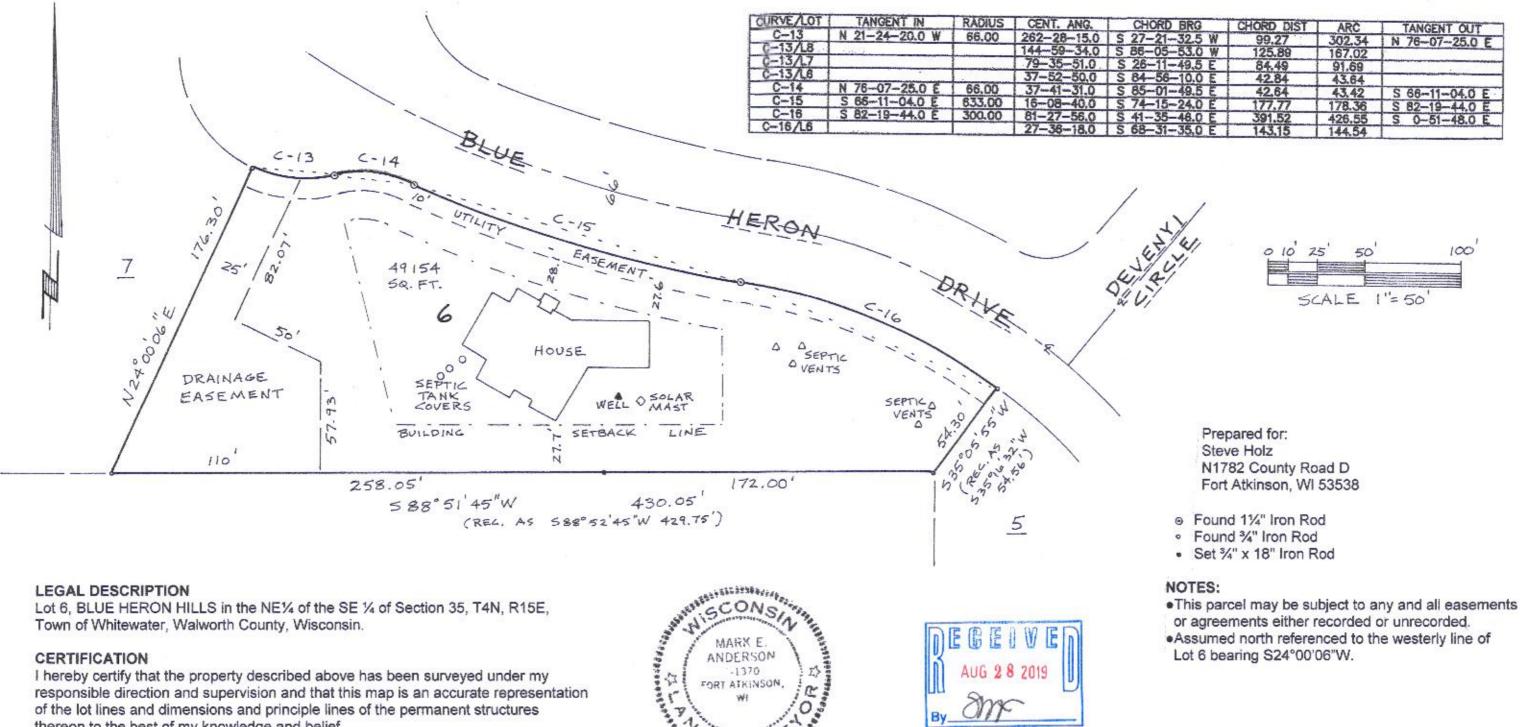

CERTIFICATION

I hereby certify that the property described above has been surveyed under my responsible direction and supervision and that this map is an accurate representation of the lot lines and dimensions and principle lines of the permanent structures thereon to the best of my knowledge and belief.

Date: 8-26-19

Mark E. Anderson

Professional Land Surveyor, S-1370



ANDERSON LAND SURVEYING LLC

Mark E. Anderson, Professional Land Surveyor W6141 Star School Road, Fort Atkinson, WI 53538 Tel: 920-563-8162 andersonlandsurvey@gmail.com

415-1484

DBHH-6

JN 18-04 Sheet 1 of 1