LAND-MARK SURVEYING Mark L. Miritz

Wisconsin Professional Land Surveyor S-2582

N9330 Knuteson Drive Whitewater, WI 53190 Phone:(262)495-3284 MARKMIRITZ@ LAND-MARKSURVEYING.COM

PLAT OF SURVEY


LOT 5, BLOCK 2 OF INDIAN TRAILS SUBDIVISION AND A PORTION OF THE VACATED KETTLE MORAINE DRIVE AS FOUND IN VOLUME 657, PAGE 1123, DOCUMENT NO. 391597 OF WALWORTH COUNTY RECORDS, ALL IN THE SOUTHEAST 1/4 OF SECTION 27, TOWN 4 NORTH, RANGE 15 EAST, TOWN OF WHITEWATER, WALWORTH COUNTY, WISCONSIN.

ORDERED BY: TOM SPEAR N6442 DELANEY ROAD DELAVAN, WI 53115

KETTLE MORAINE DRIVE

(107' WIDE)

(95' WIDE AFTER VACATION)

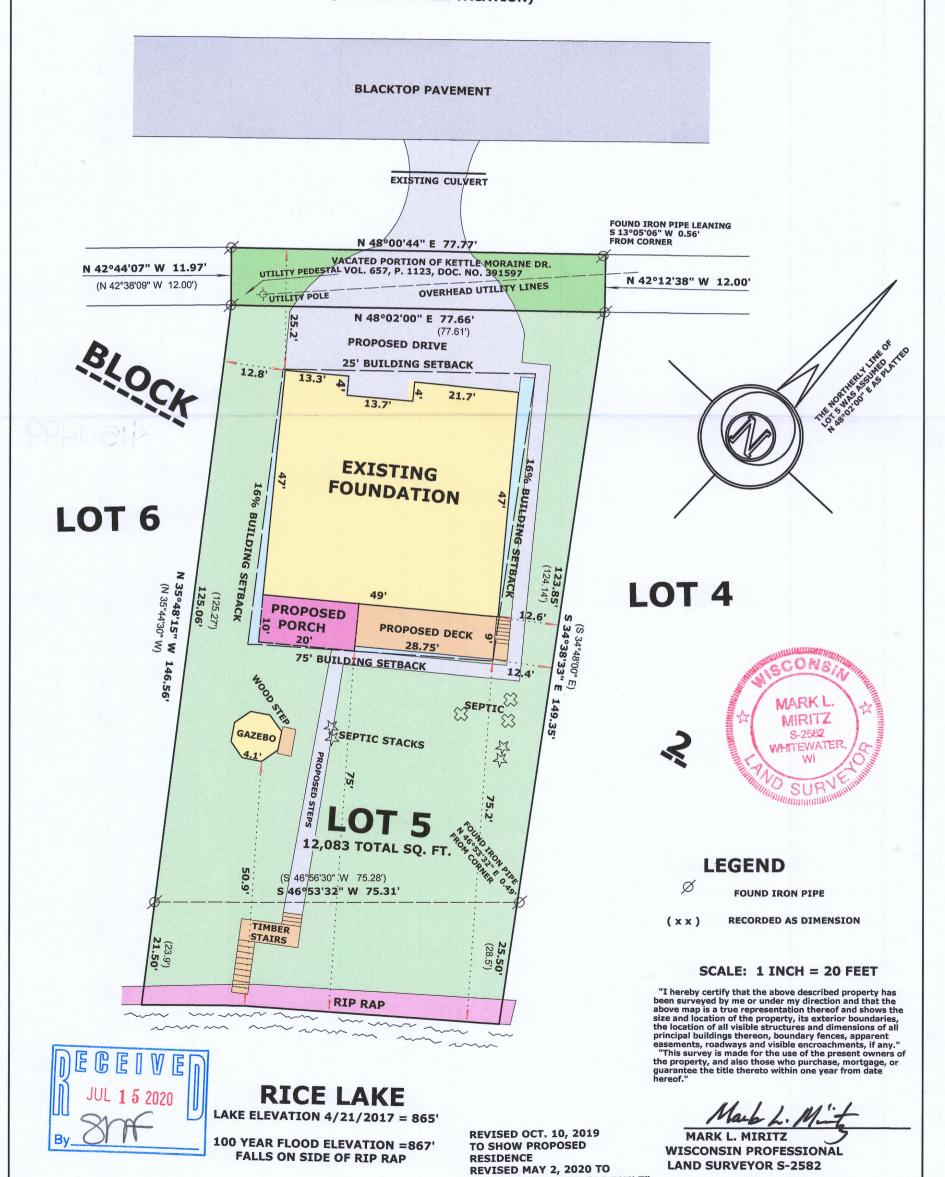

SHOW FOUNDATION "AS BUILT"

DITS - 29

JOB NO. 17.409

APRIL 23, 2017

DATE: