

LAND-MARK SURVEYING

Mark L. Miritz

Wisconsin Professional Land Surveyor S-2582

N9330 Knuteson Drive
Whitewater, WI 53190
Phone: (262) 949-1239
MARKMIRITZ@
LAND-MARKSURVEYING.COM

PLAT OF SURVEY

**LOT 35, BLOCK 2, MORaine HEIGHTS SUBDIVISION,
LOCATED IN PART OF THE NORTHWEST 1/4 OF
SECTION 35, TOWN 4 NORTH, RANGE 15 EAST,
TOWN OF WHITEWATER, WALWORTH COUNTY,
WISCONSIN.**

**OWNER:
JACK D. CERNIGLIA JOINT REVOCABLE TRUST
ELLEN CERNIGLIA JOINT REVOCABLE TRUST
1618 GREENWOOD DRIVE
MT. PROSPECT, IL 60056**



LEGEND

- ⊗ FOUND IRON PIPE 1 1/4"
- FOUND IRON ROD 1"
- (X X) RECORDED AS DIMENSION



SCALE: 1 INCH = 20 FEET

"I hereby certify that the above described property has been surveyed by me or under my direction and that the above map is a true representation thereof and shows the size and location of the property, its exterior boundaries, the location of all visible structures and dimensions of all principal buildings thereon, boundary fences, apparent easements, roadways and visible encroachments, if any."
"This survey is made for the use of the present owners of the property, and also those who purchase, mortgage, or guarantee the title thereto within one year from date hereof."



Mark L. Miritz
**MARK L. MIRITZ
WISCONSIN PROFESSIONAL
LAND SURVEYOR S-2582**

DATE: AUG. 3, 2021 JOB NO. 21.710

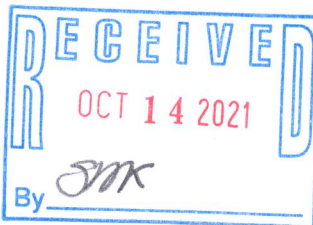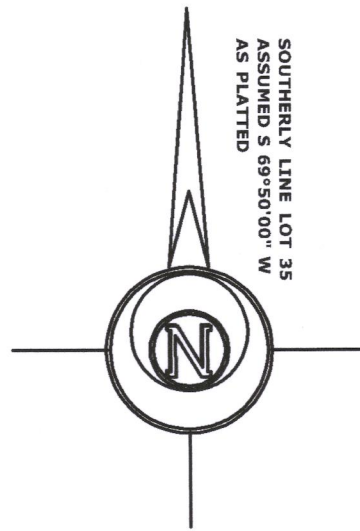

DMH-108

415-1546