
PREPARED FOR: JAMES SITTA

- OF -

Lot 6, Block 1, Minnieska Subdivision, Town of Whitewater, County of Walworth, Wisconsin.

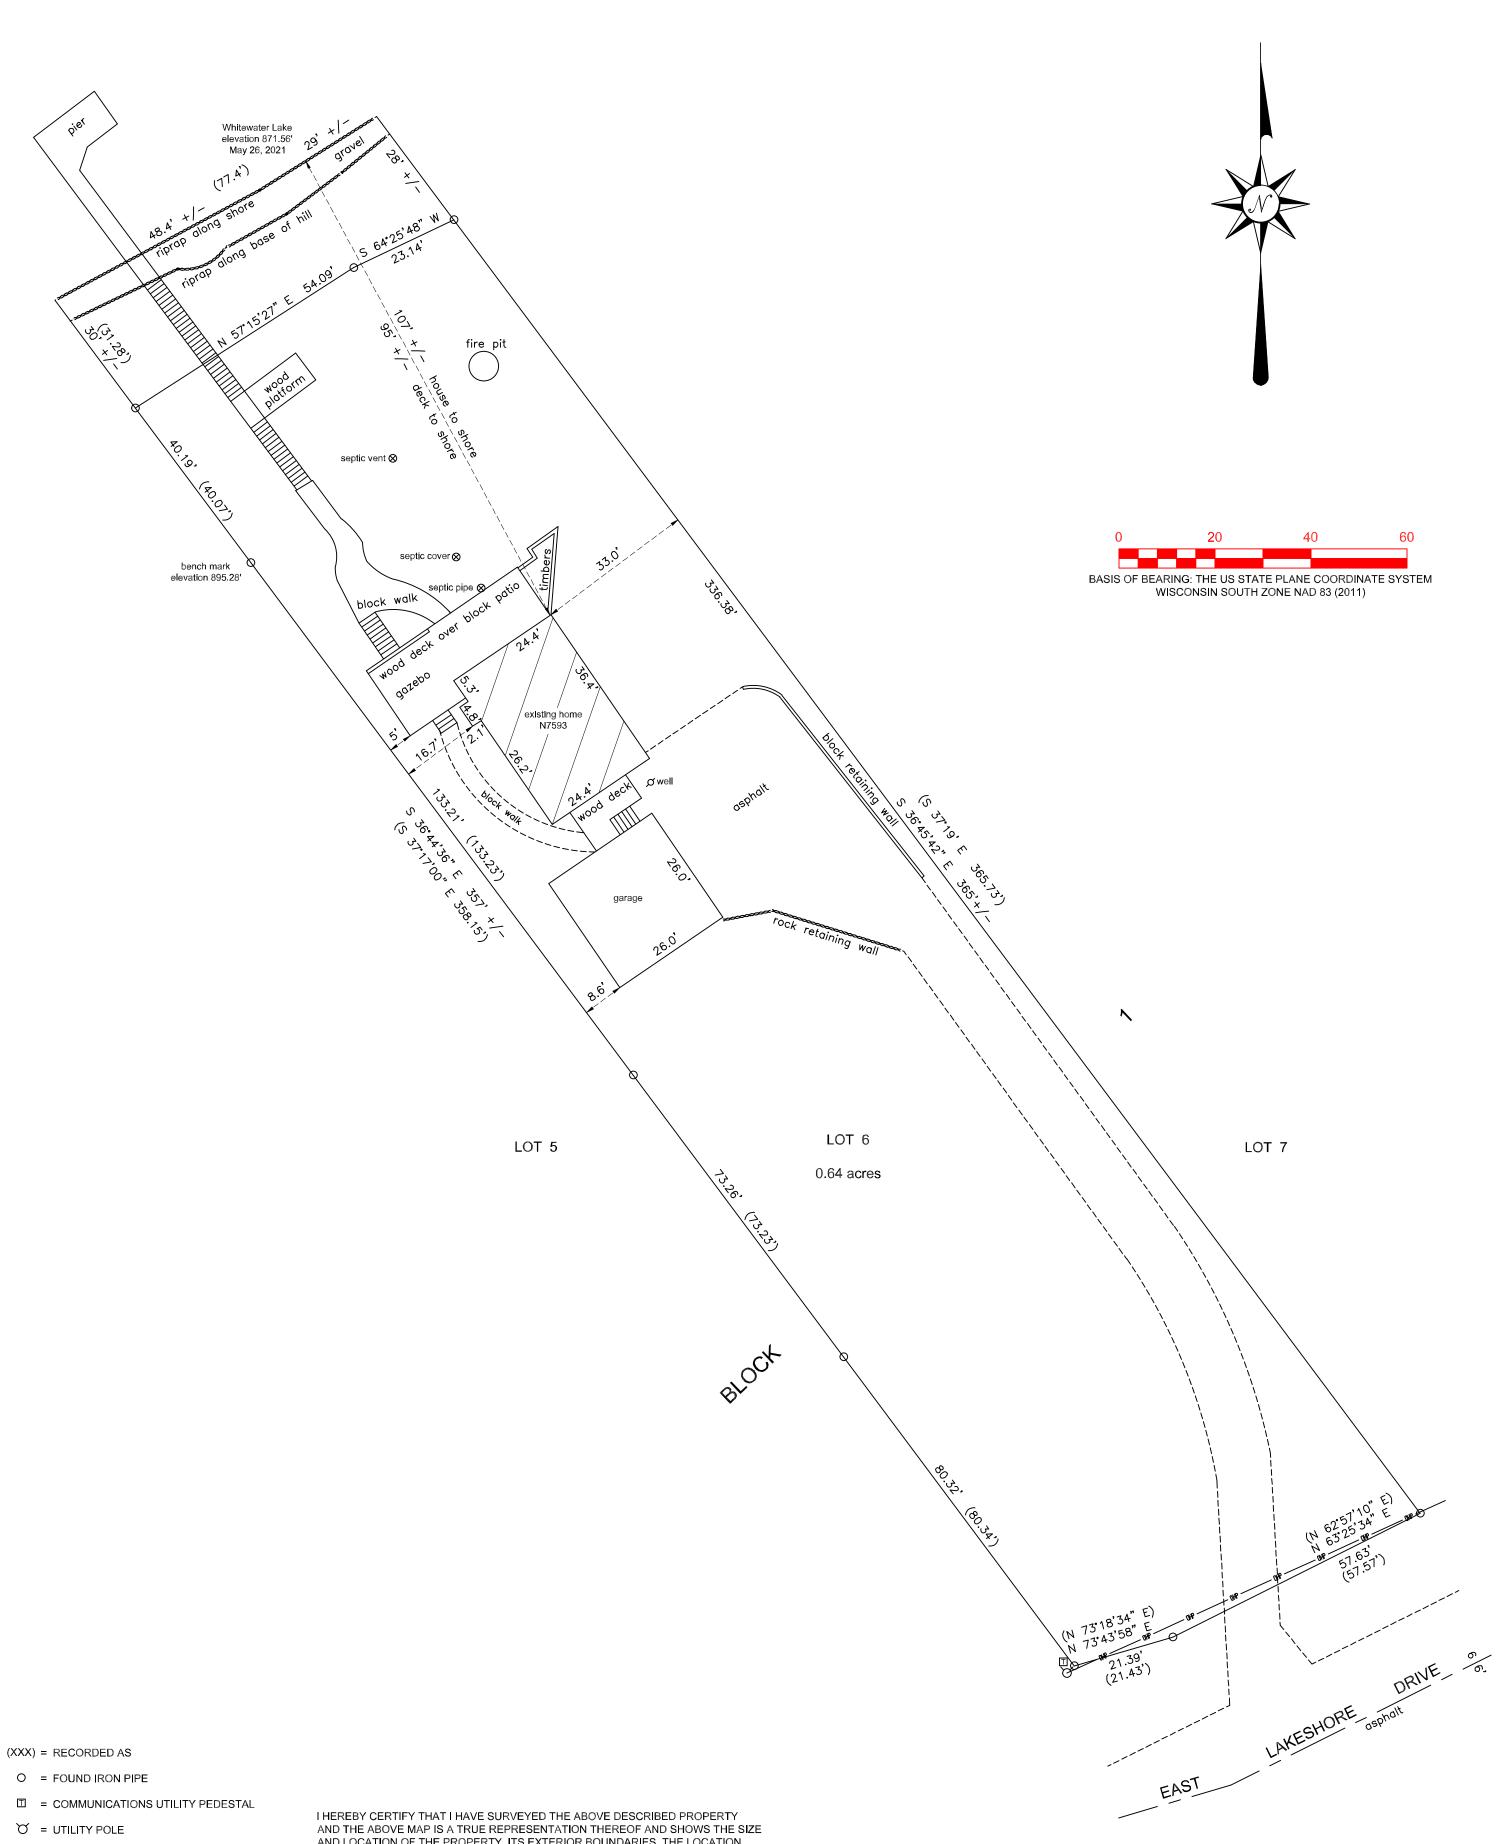

OF - OVERHEAD UTILITY LINES

SCALE 1" = 20'

JOB NO. 2021-018

TAX ID # DM 00006

AND LOCATION OF THE PROPERTY, ITS EXTERIOR BOUNDARIES, THE LOCATION AND DIMENSIONS OF ALL STRUCTURES THEREON, FENCES, APPARENT EASEMENTS, ROADWAYS, AND VISIBLE ENCROACHMENTS, IF ANY.

THIS SURVEY IS MADE FOR THE PRESENT OWNERS OF THE PROPERTY, AND THOSE WHO PURCHASE, MORTGAGE, OR GUARANTEE THE TITLE THERETO WITHIN ONE YEAR FROM THIS DATE HEREOF.

DATED THIS 22ND DAY OF JUNE 2021

STEVEN L SCHMIDT S - 2813 Wisconsin Professional Land Surveyor