


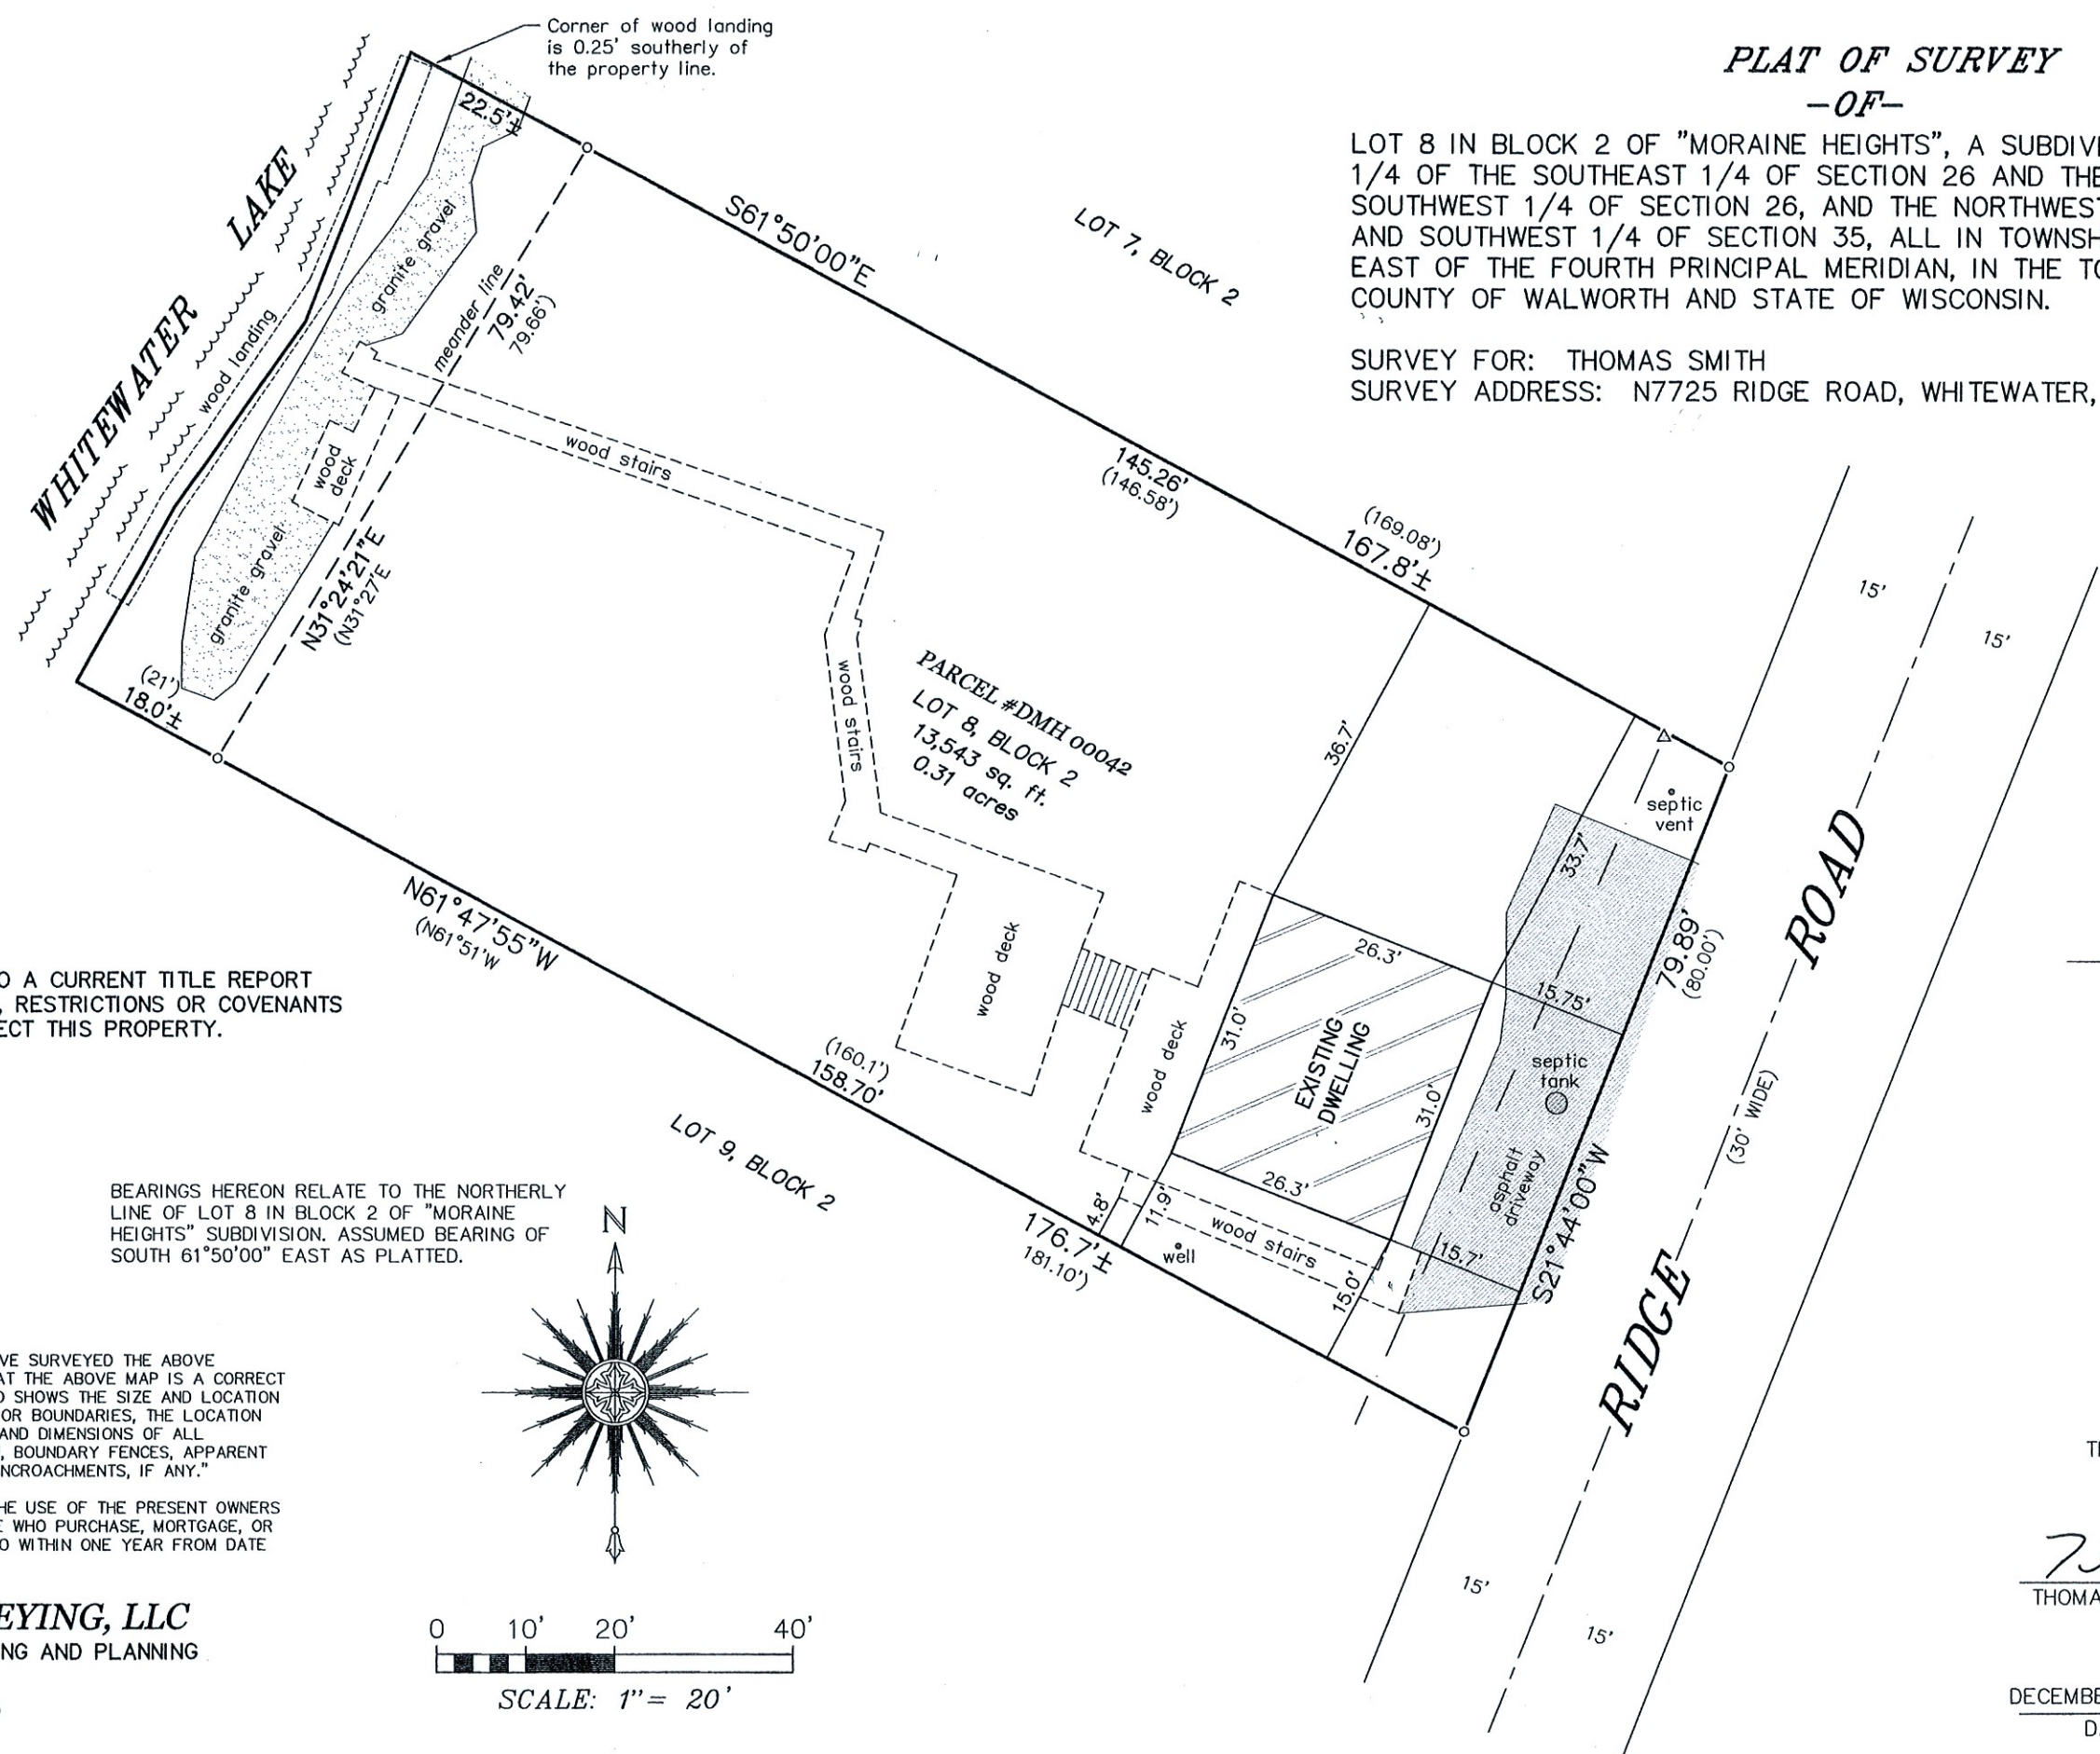

PLAT OF SURVEY
-OF-

LOT 8 IN BLOCK 2 OF "MORaine HEIGHTS", A SUBDIVISION IN THE SOUTHWEST 1/4 OF THE SOUTHEAST 1/4 OF SECTION 26 AND THE SOUTHEAST 1/4 OF THE SOUTHWEST 1/4 OF SECTION 26, AND THE NORTHWEST 1/4, NORTHEAST 1/4 AND SOUTHWEST 1/4 OF SECTION 35, ALL IN TOWNSHIP 4 NORTH, RANGE 15 EAST OF THE FOURTH PRINCIPAL MERIDIAN, IN THE TOWN OF WHITEWATER, COUNTY OF WALWORTH AND STATE OF WISCONSIN.

SURVEY FOR: THOMAS SMITH
SURVEY ADDRESS: N7725 RIDGE ROAD, WHITEWATER, WI 53190

NOTE: REFER TO A CURRENT TITLE REPORT FOR EASEMENTS, RESTRICTIONS OR COVENANTS WHICH MAY AFFECT THIS PROPERTY.

BEARINGS HEREON RELATE TO THE NORTHERLY LINE OF LOT 8 IN BLOCK 2 OF "MORaine HEIGHTS" SUBDIVISION. ASSUMED BEARING OF SOUTH 61°50'00" EAST AS PLATTED.

"I HEREBY CERTIFY THAT I HAVE SURVEYED THE ABOVE DESCRIBED PROPERTY AND THAT THE ABOVE MAP IS A CORRECT REPRESENTATION THEREOF AND SHOWS THE SIZE AND LOCATION OF THE PROPERTY, ITS EXTERIOR BOUNDARIES, THE LOCATION OF ALL VISIBLE STRUCTURES AND DIMENSIONS OF ALL PRINCIPAL BUILDINGS THEREON, BOUNDARY FENCES, APPARENT EASEMENTS, ROADWAYS AND ENCROACHMENTS, IF ANY."

"THIS SURVEY IS MADE FOR THE USE OF THE PRESENT OWNERS OF THE PROPERTY, AND THOSE WHO PURCHASE, MORTGAGE, OR GUARANTEE THE TITLE THERETO WITHIN ONE YEAR FROM DATE HEREOF."

SATTER SURVEYING, LLC
LAND SURVEYS, MAPPING AND PLANNING
272 ORIGIN STREET
BURLINGTON, WI 53105
262-661-4239

- LEGEND**
- o FOUND IRON PIPE
 - () RECORDED AS
 - Δ UTILITY POLE
 - OVERHEAD UTILITY LINES



THIS IS NOT AN ORIGINAL PRINT
UNLESS THIS SEAL IS RED.

Thomas L. Satter
THOMAS L. SATTER S-2850

DECEMBER 7, 2021
DATE

092117
JOB NUMBER