

ASSUMED ROAD
Road lines & 20' road


SCALE 1" = 20'
X - IRON PIPE FOUND
X - IRON ROOF FOUND
X - 60 PEN. SPIKE FOUND

• - IRON ROOF SET
 $\frac{3}{4}$ " DIA. X 24"

OWNER: G. L. JOHNSON
SURVEYED FOR:
H. KINSON
RR 3 WHITELATER,
WIS.

DMH-39


LAND DESCRIBED TO THE PUBLIC
FOR 055 ACRES & ROAD

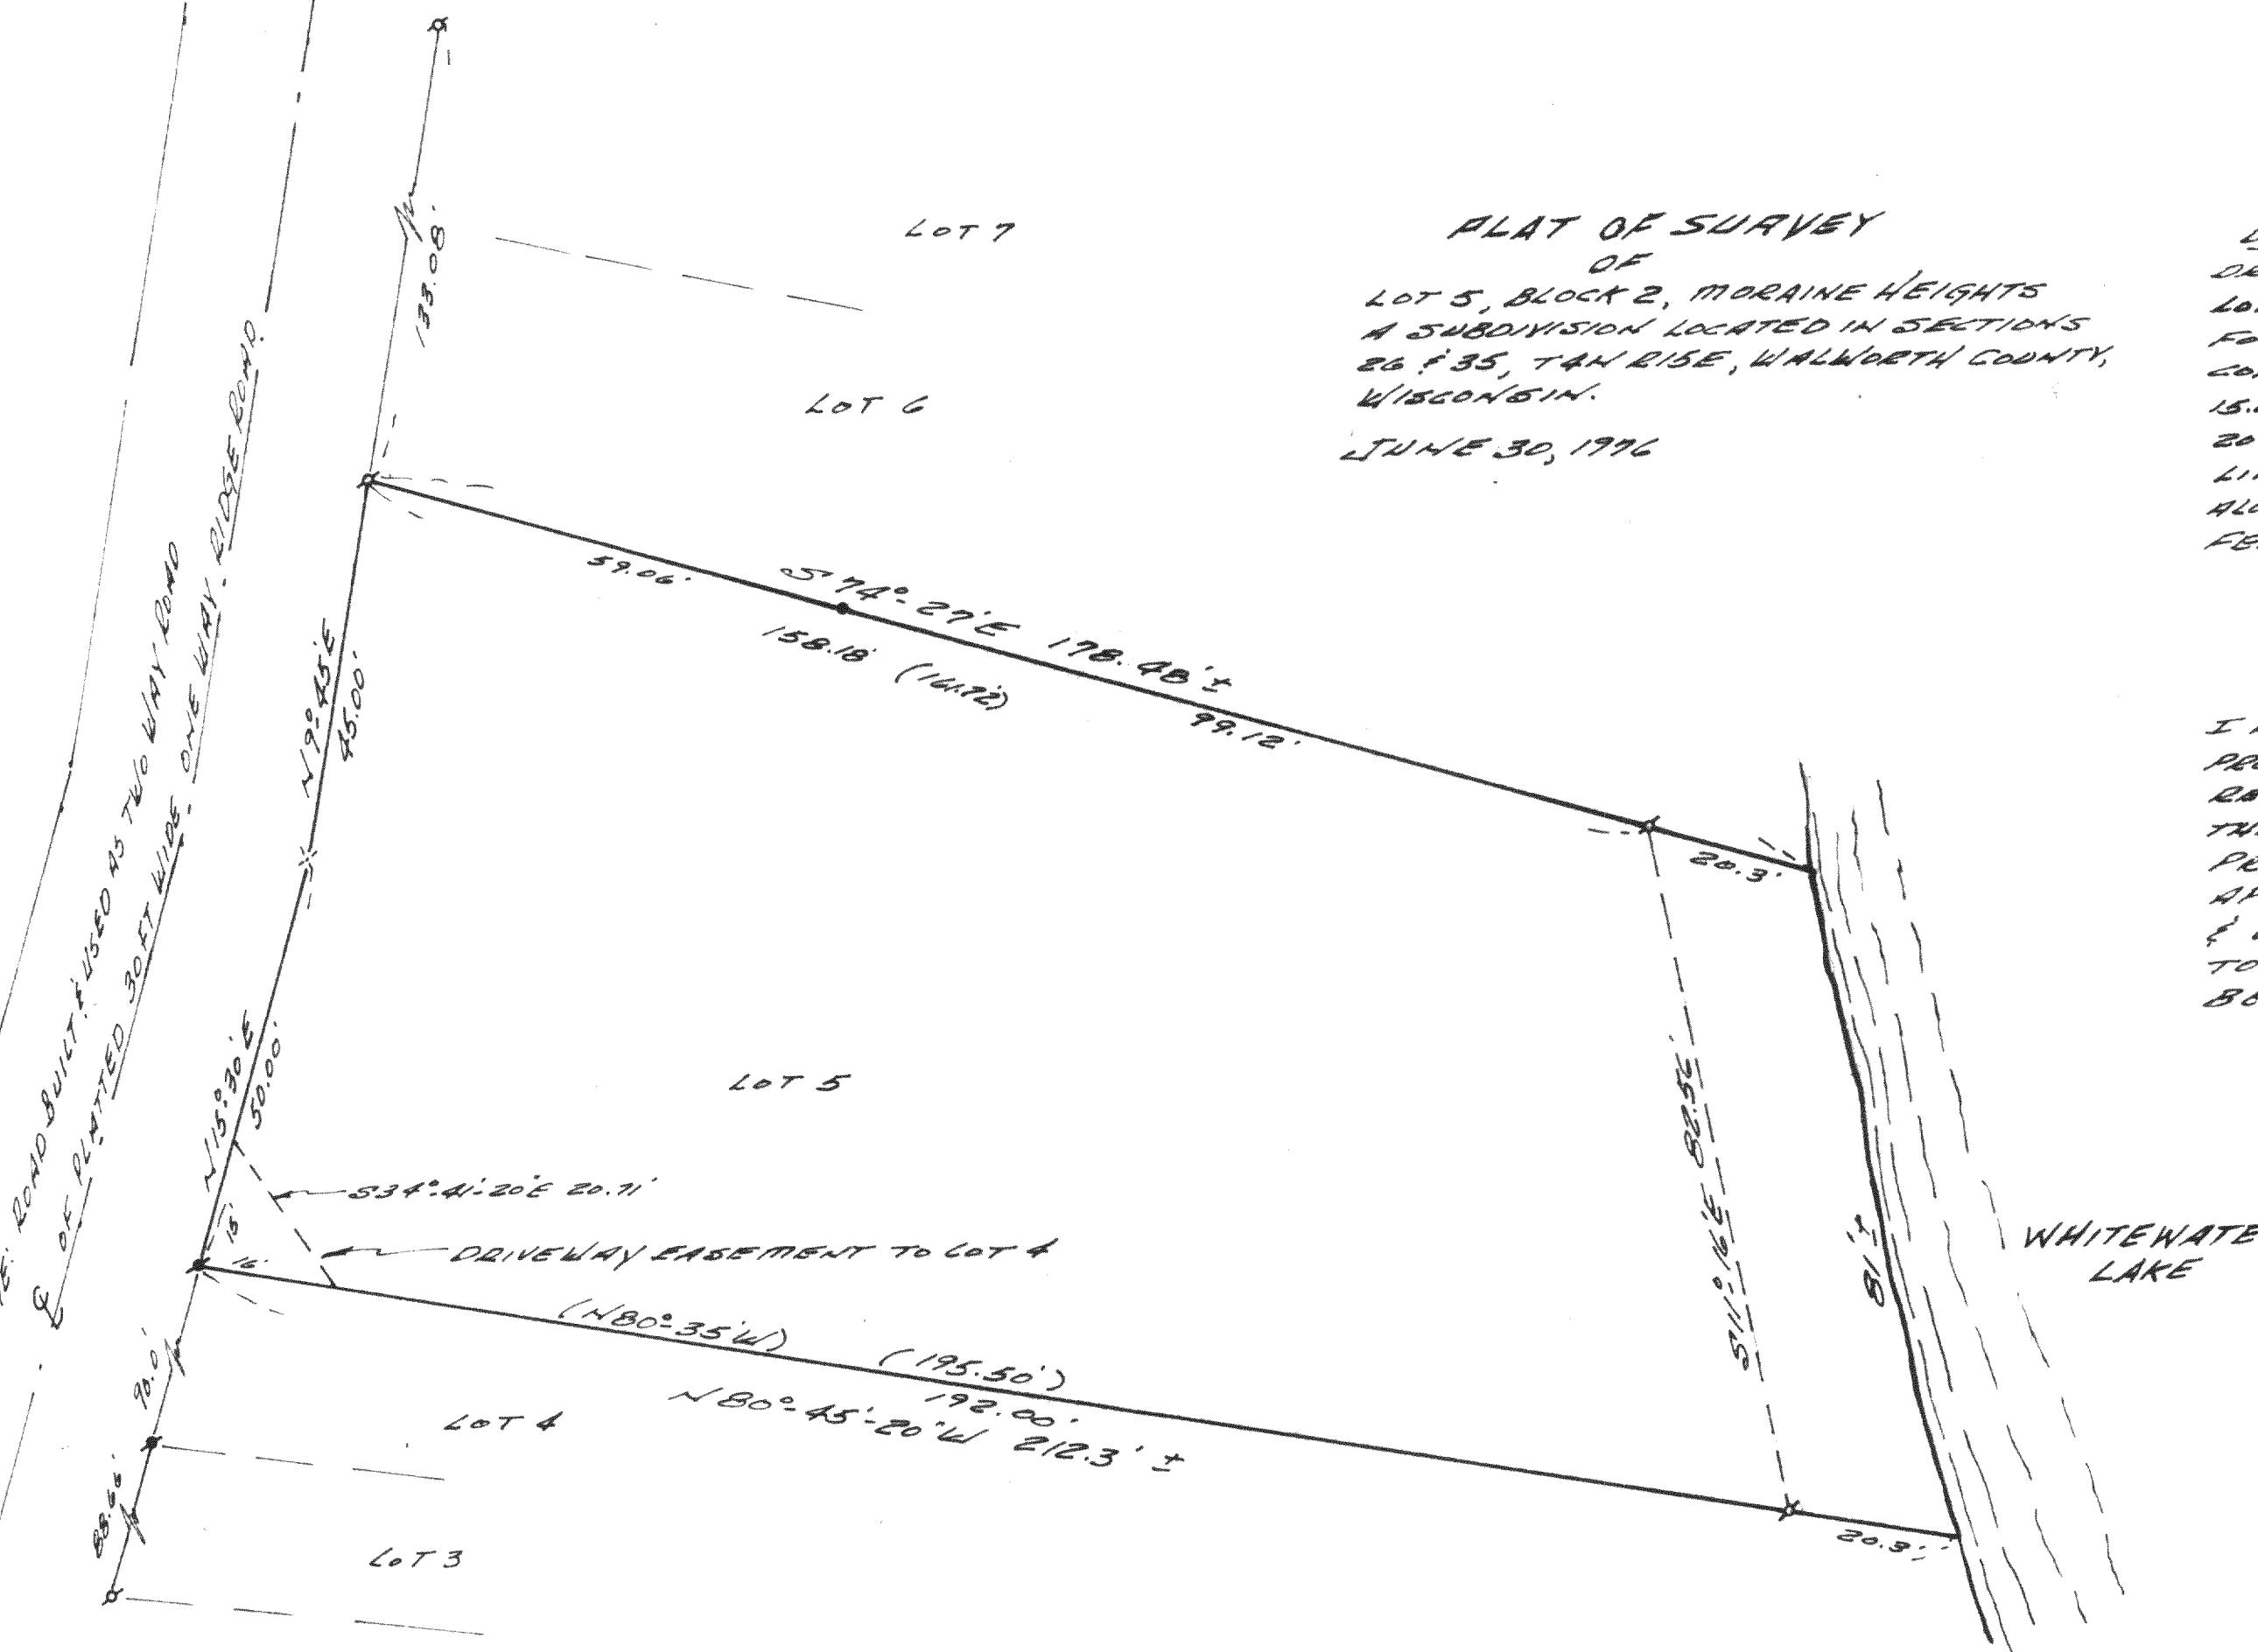

DESCRIPTION OF DRIVEWAY EASEMENT
DRIVEWAY EASEMENT OVER PART OF
LOT 5, TO LOT 4, DESCRIBED AS
FOLLOWS: BEGIN AT THE SOUTHWEST
CORNER OF LOT 5, THENCE N 15° 30' E
15.00 FEET; THENCE 534° 41' 20" E
20.71 FEET TO THE SOUTHEASTLY LOT
LINE OF SAID LOT 5. THENCE N 80° 45' 20" W
ALONG SAID SOUTHEASTLY LOT LINE, 16.00
FEET TO THE POINT OF BEGINNING.

I HAVE SURVEYED THE ABOVE DESCRIBED
PROPERTY & THE ABOVE MAP IS A TRUE
REPRESENTATION THEREOF & SHOWS
THE SIZE & LOCATION OF THE
PROPERTY, ITS EXTERIOR BOUNDARIES,
APPARENT EASEMENTS, & ROADWAYS
& VISIBLE ENCROACHMENTS, IF ANY,
TO THE BEST OF MY KNOWLEDGE &
BELIEF.

Thomas P.A. Jensen
THOMAS P.A. JENSEN R.L.S. #1084

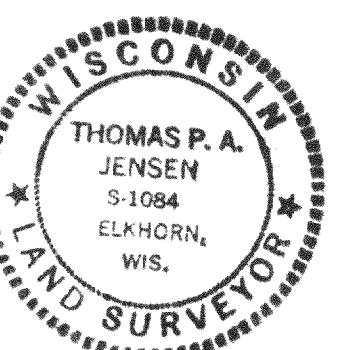

415-159