
PLAT OF SURVEY

LOCATION: N7384 C.T.H. "P", Whitewater, Wisconsin

LEGAL DESCRIPTION:

Lot 4 of CERTIFIED SURVEY MAP NO. 3543, Lot 3, CERTIFIED SURVEY MAP NO. 2018 recorded in Volume 9 Certified Surveys Maps of Walworth County at pages 317 and 318 in the Southeast 1/4 of the Southwest 1/4 of Section 36, Town 4 North, Range 15 East, Town of Whitewater, Walworth County, Wisconsin.

July 20, 2023 Survey No. 114081-B

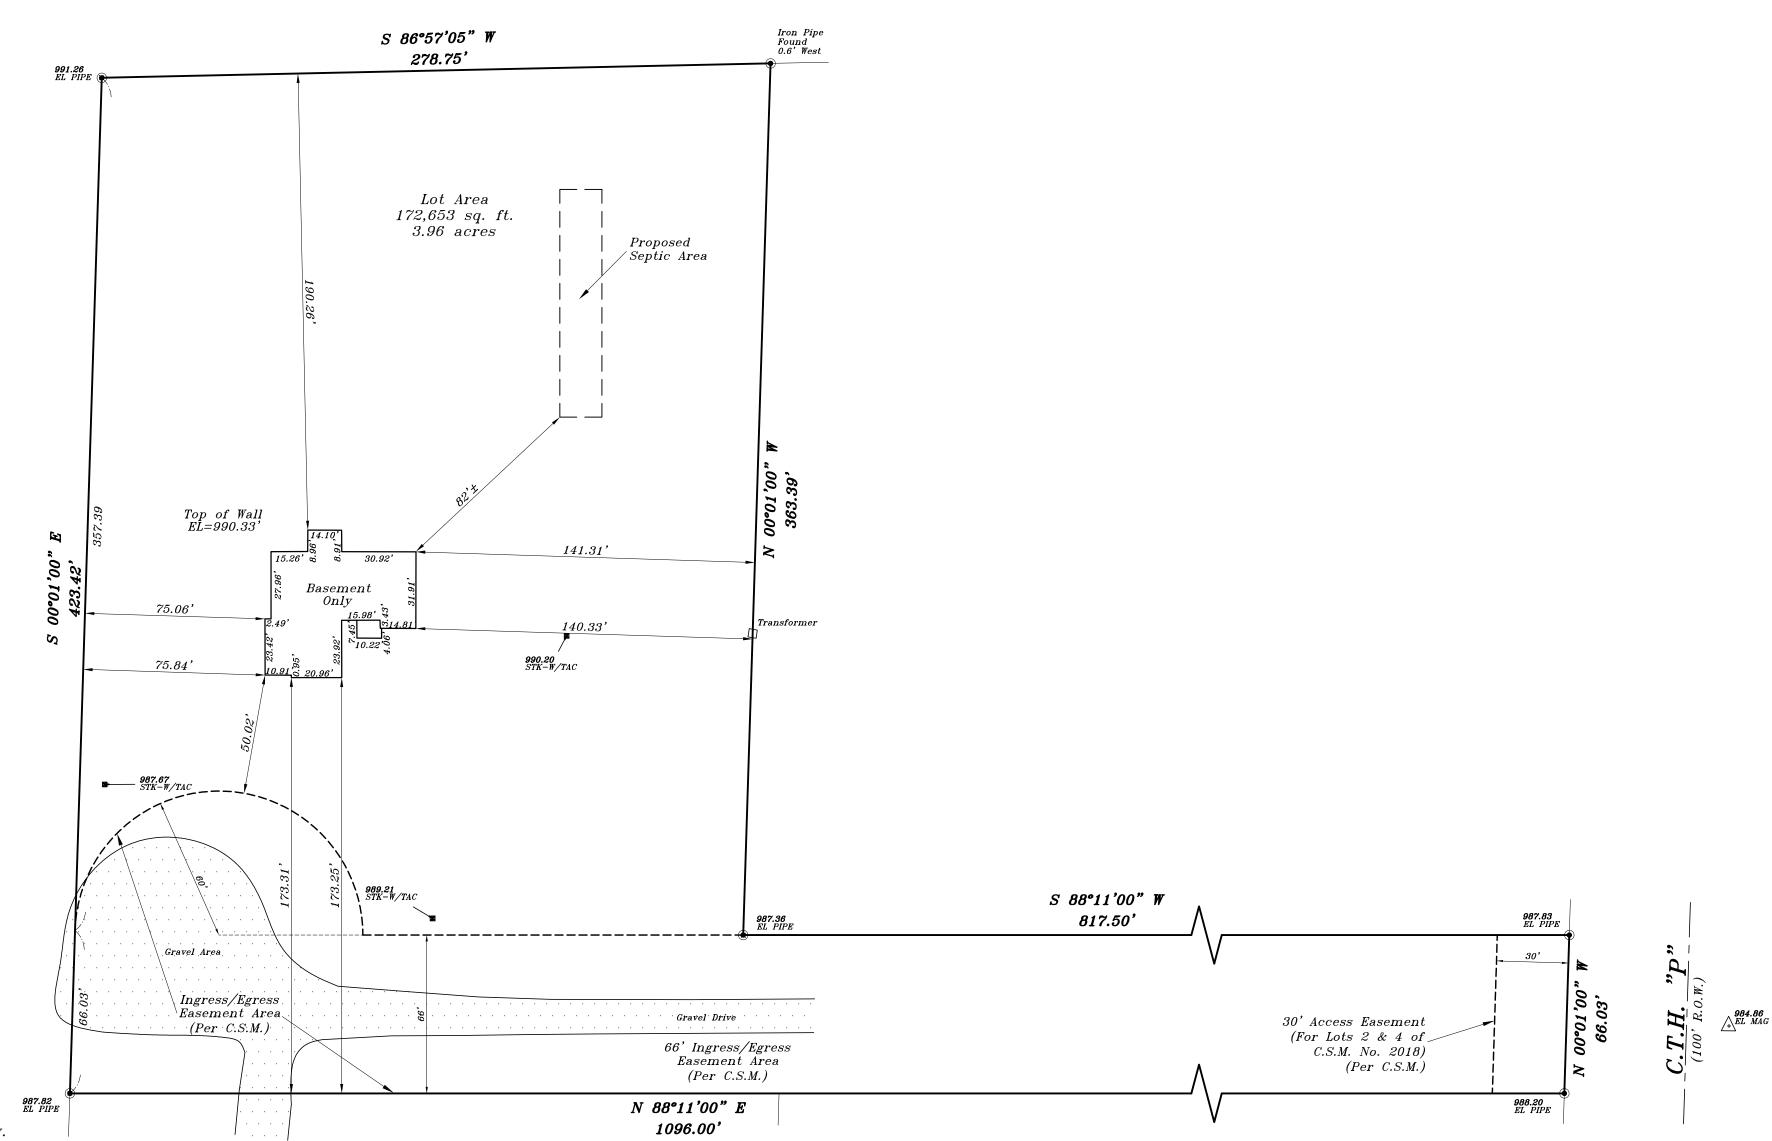

Proposed finished yard, 1st floor or top of foundation grade shown

Prop. Fin. Yd Gr.

989.67

990.00'

990.33

on this drawing is a suggested grade and should be verified by the owner, builder or municipality.

METROPOLITAN SURVEY SERVICE, INC.


PROFESSIONAL LAND SURVEYORS

9415 West Forest Home Avenue, Suite 202 Hales Corners, Wisconsin 53130 PH. (414) 529-5380 survey@metropolitansurvey.com

www.metropolitansurvey.com ● — Denotes Iron Pipe Found □ — Denotes Iron Pipe Set

000.0 — Denotes Proposed Grade



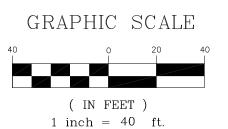



I HEREBY CERTIFY THAT I HAVE SURVEYED THE ABOVE DESCRIBED PROPERTY AND THAT THE ABOVE MAP IS A TRUE REPRESENTATION THEREOF AND SHOWS THE SIZE AND LOCATION OF THE PROPERTY. ITS EXTERIOR BOUNDARIES, THE LOCATION OF ALL VISIBLE STRUCTURES AND DIMENSIONS OF ALL PRINCIPAL BUILDINGS THEREON, BOUNDARY FENCES, APPARENT EASEMENTS AND ROADWAYS AND VISIBLE ENCROACHMENT, IF ANY.

THIS SURVEY IS MADE FOR THE EXCLUSIVE USE OF THE PRESENT OWNERS OF THE PROPERTY, AND ALSO THOSE WHO PURCHASE, MORTGAGE, OR GUARANTEE THE TITLE THERETO WITHIN ONE (1) YEAR FROM THE DATE HEREOF.

Dennis C. Sauer **Professional Land Surveyor S-2421**