

LAND-MARK SURVEYING  
Mark L. Miritz  
Wisconsin Professional Land Surveyor S-2582

N9330 Knuteson Drive  
Whitewater, WI 53190  
Phone:(262)949-1239  
MARKMIRITZ@  
LAND-MARKSURVEYING.COM

PLAT OF SURVEY

LOT 18 OF BLOCK 3 OF  
GRAND VIEW SUBDIVISION

LOCATED IN THE SOUTHEAST 1/4 OF SECTION 34  
TOWN 4 NORTH, RANGE 15 EAST, TOWN OF WHITEWATER,  
WALWORTH COUNTY, WISCONSIN.

OWNERS:  
JOSEPH GEORGEN TRUST  
MARY GEORGEN TRUST  
175 VISTA ROAD  
LAKE ZURICH, IL. 60047

BLOCK  
.....

LOT 23

LOT 22

LOT 21

LOT 19



3  
.....

LOT 17

LOT 18

10,127 S.F. ( 0.23 AC.)

KETTLE MORaine DRIVE  
66' wide

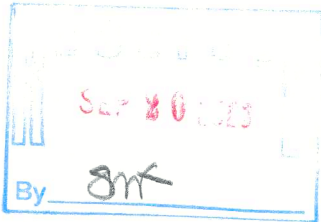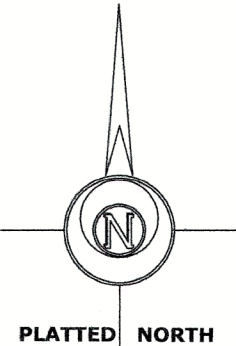

LEGEND

- FOUND IRON PIPE
- FOUND IRON ROD
- SET IRON ROD, 18" LONG, WEIGHING 1.5 LBS./LINEAL FT., 3/4" DIA.
- RECORDED AS DIMENSION
- EXISTING CHAIN LINK FENCE

SCALE: 1" = 30 FEET

"I hereby certify that the above described property has been surveyed by me or under my direction and that the above map is a true representation thereof and shows the size and location of the property, its exterior boundaries, the location of all visible structures and dimensions of all principal buildings thereon, boundary fences, apparent easements, roadways and visible encroachments, if any."  
"This survey is made for the use of the present owners of the property, and also those who purchase, mortgage, or guarantee the title thereto within one year from date hereof."

*Mark L. Miritz*  
MARK L. MIRITZ  
WISCONSIN PROFESSIONAL  
LAND SURVEYOR S-2582

DATE: March 12, 2005 JOB NO. 05.215

REVISED MAY 30, 2023 TO SET MISSING CORNER &  
LOCATE WELL AND SEPTIC  
REVISED MAY 12, 2005 TO SHOW FOUNDATION "AS BUILT"

DGD-36

4/15-1621